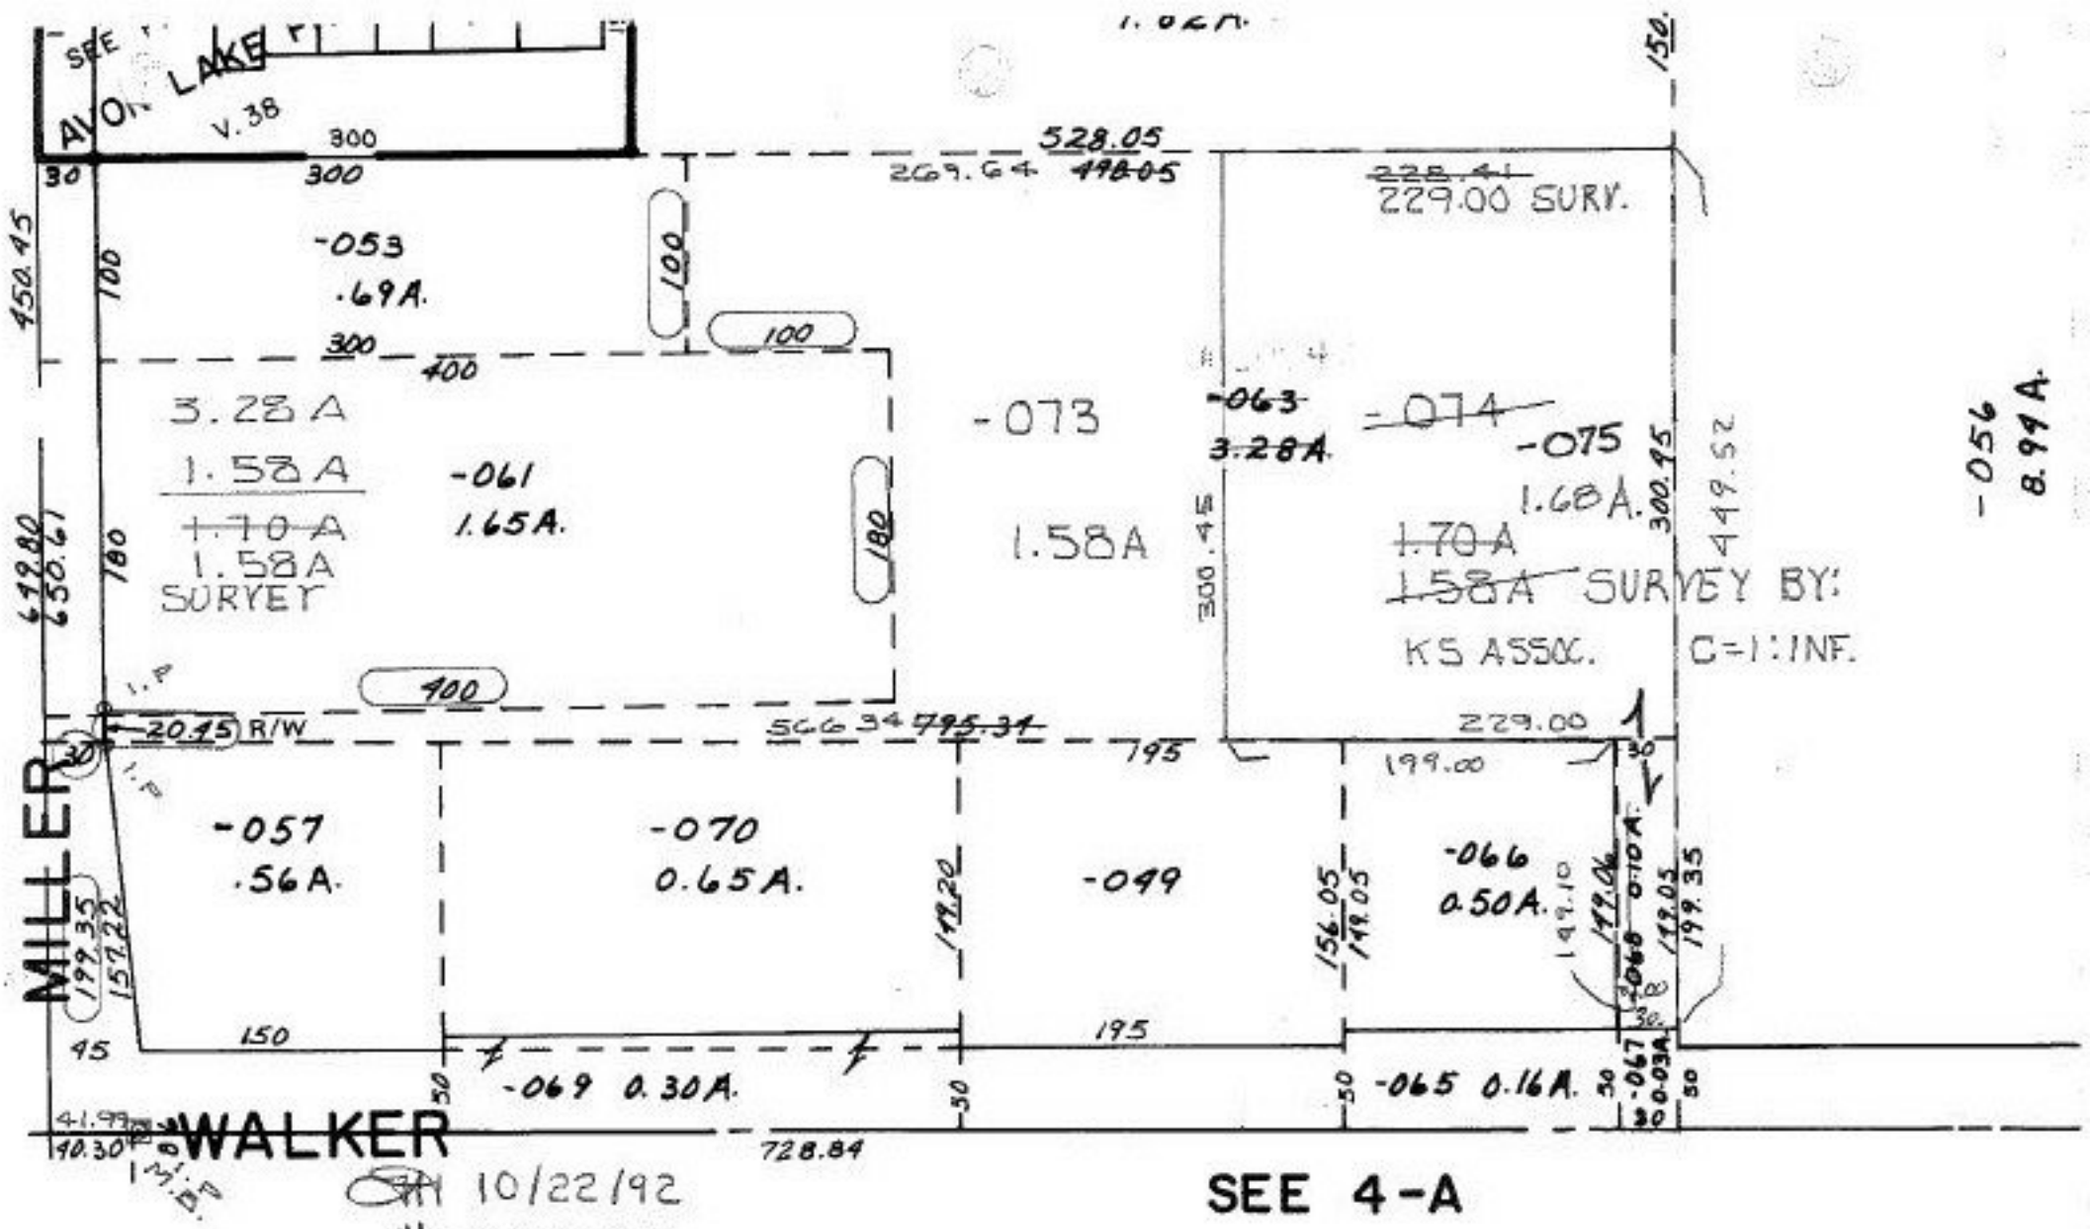

10/22/92
20047

SPLIT/COMB.

APPROVED LORAIN CO. MAP DEPT.
DATE 8-20-92
PAGE 4-00-006-R
CAROLYN BY FRANCIS
VOID AFTER # 20047

COMB. DONE 8/27 T.M.

04-00-006-114- PRIOR INST: O.R.25/935
SURVEYED BY: KS ASSOC. C=1:197,889
REM: C=1: INF.