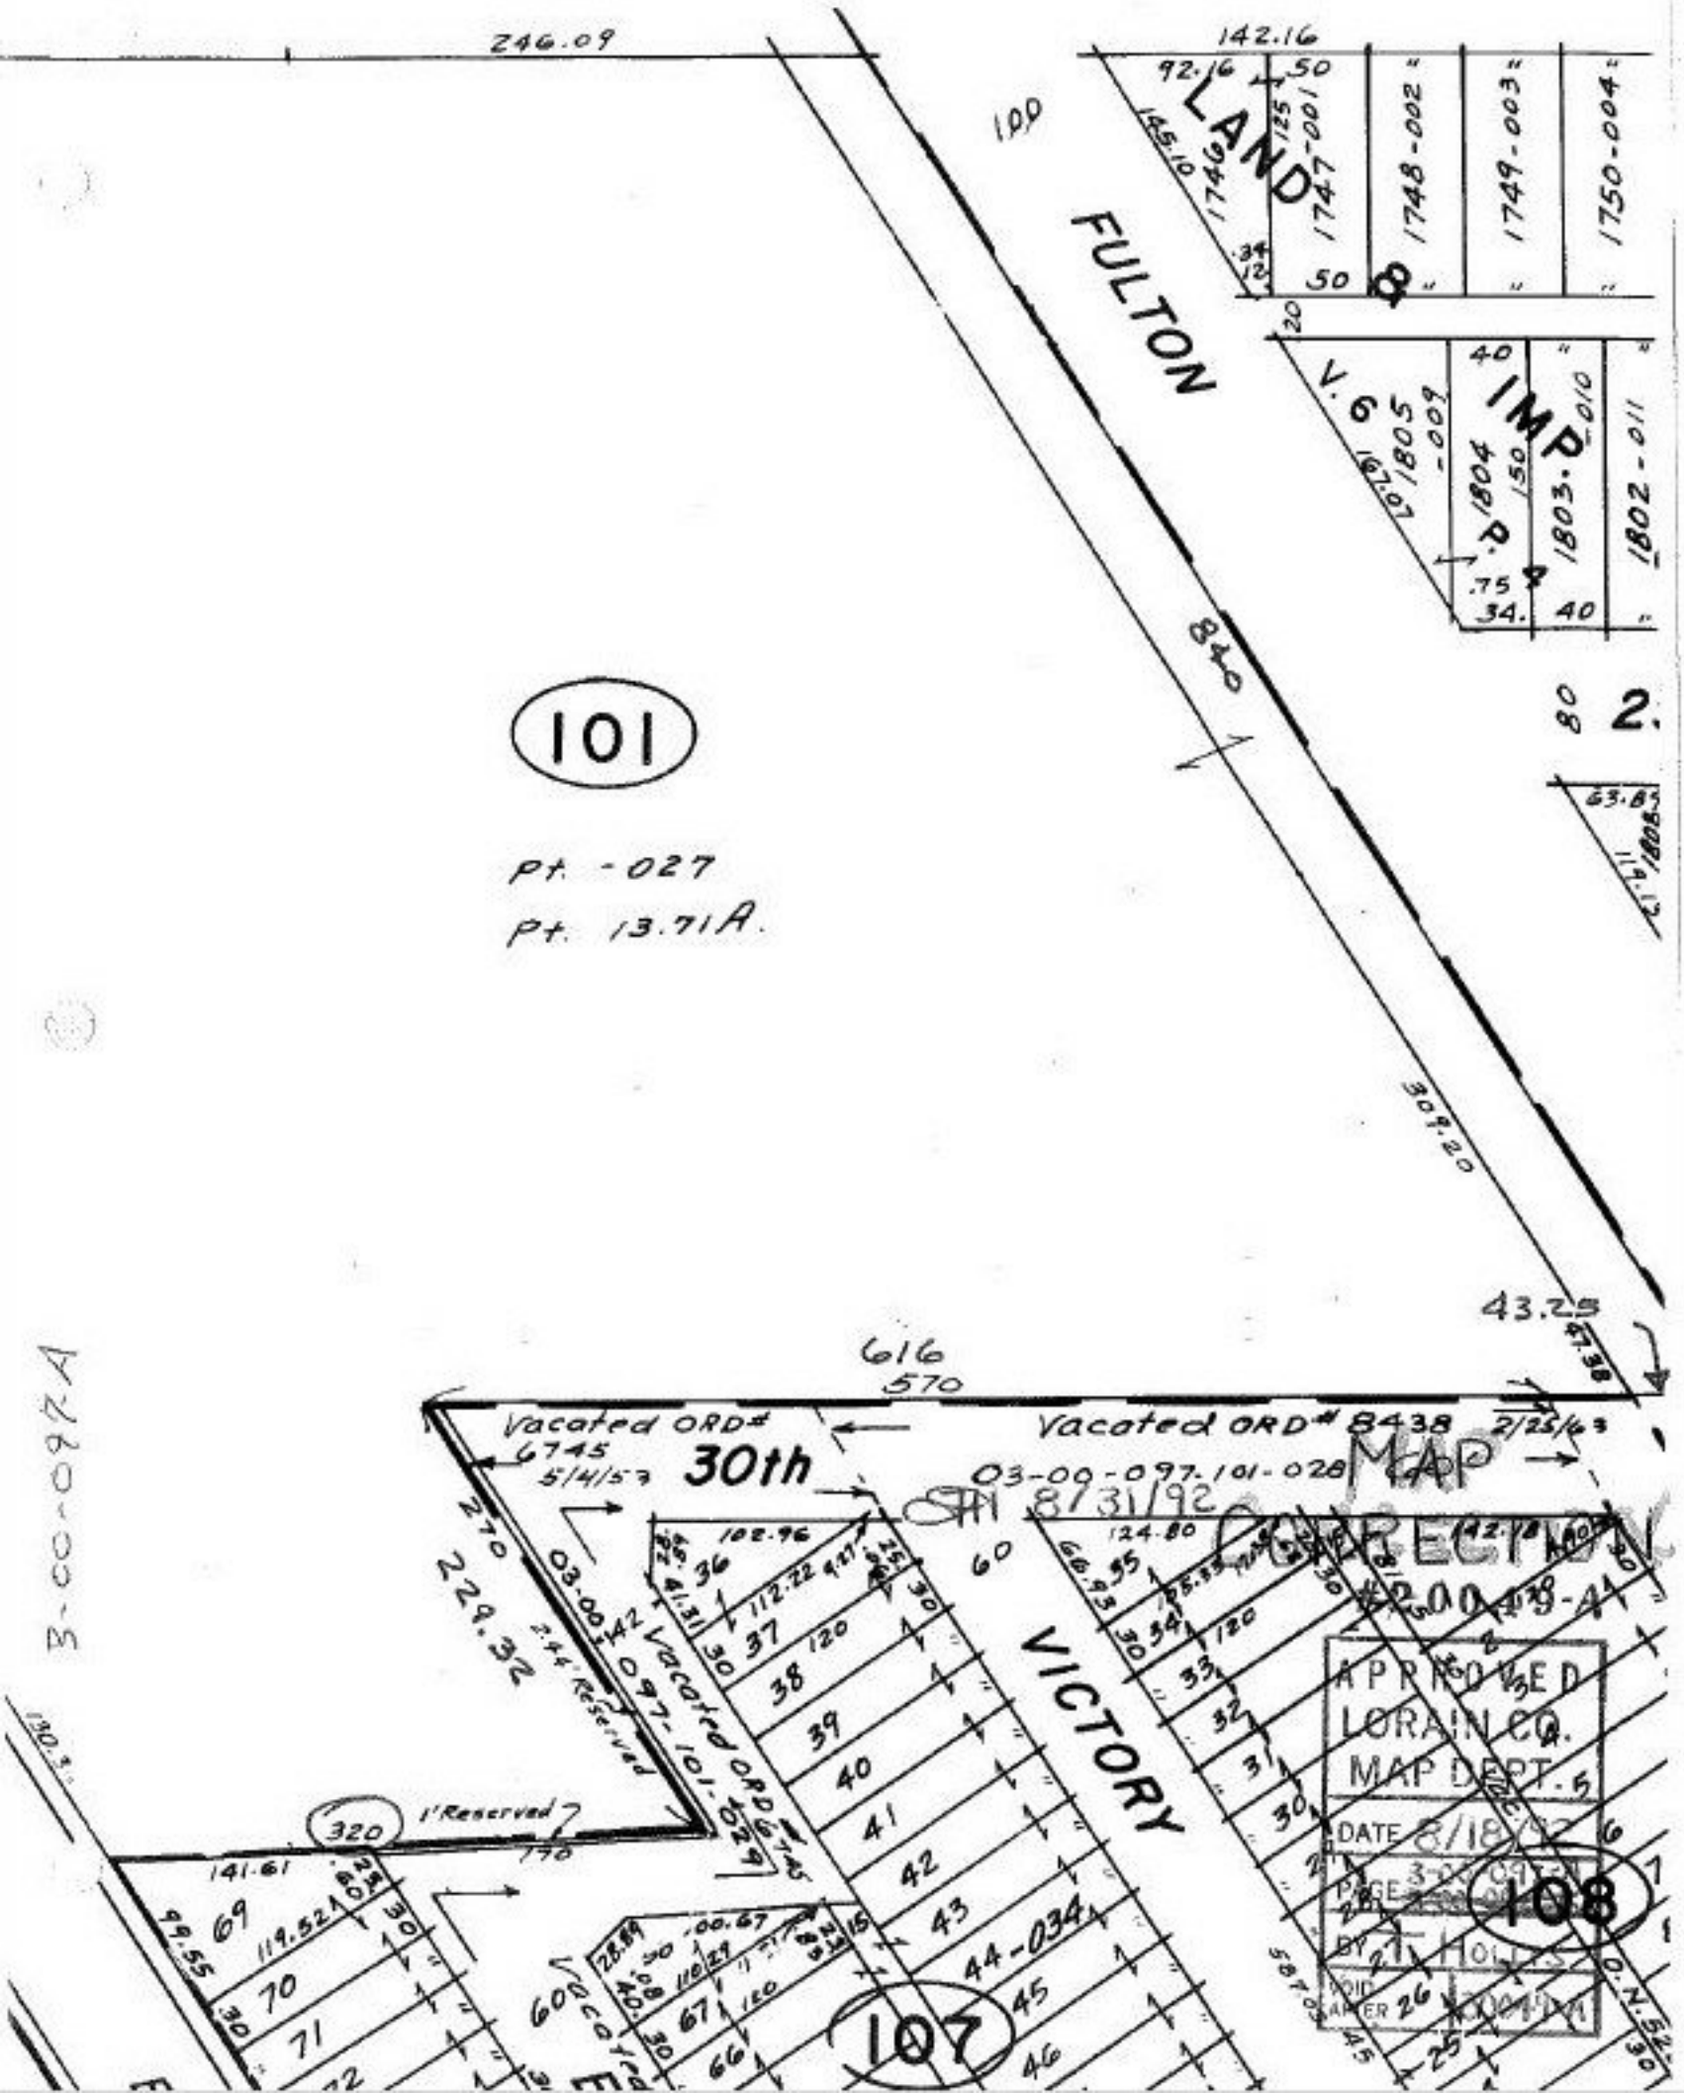
246.09
142.16
92.16
50
125
145.10
LAND
1747-001
1748-002
1749-003
1750-004
100
FULTON
8
20
40
V. 6
1805
-009
IMP
1804
1803-010
1802-011
150
167.07
.75
34.
40
840
80
2.
63.8
1808
119.12
101
pt. -027
pt. 13.71A.
304.20
43.2
616
570
Vacated ORD# 6745 5/4/53
30th
Vacated ORD# 8438 2/25/63
03-00-097.101-028
MAP
8/31/92
CORRECTION
270
229.32
102.96
124.80
112.22
41.31
36
37
38
39
40
41
42
43
44-034
45
46
120
60
03-00-097-101-029
Vacated ORD 6745
2.44' Reserved
1' Reserved
320
141.61
69
119.52
70
71
98.55
99.52
VICTORY
107
108
APPROVED
LORAIN CO.
MAP DEPT.
DATE 8/18/92
BY
VOID AFTER 26
03-00-082.A