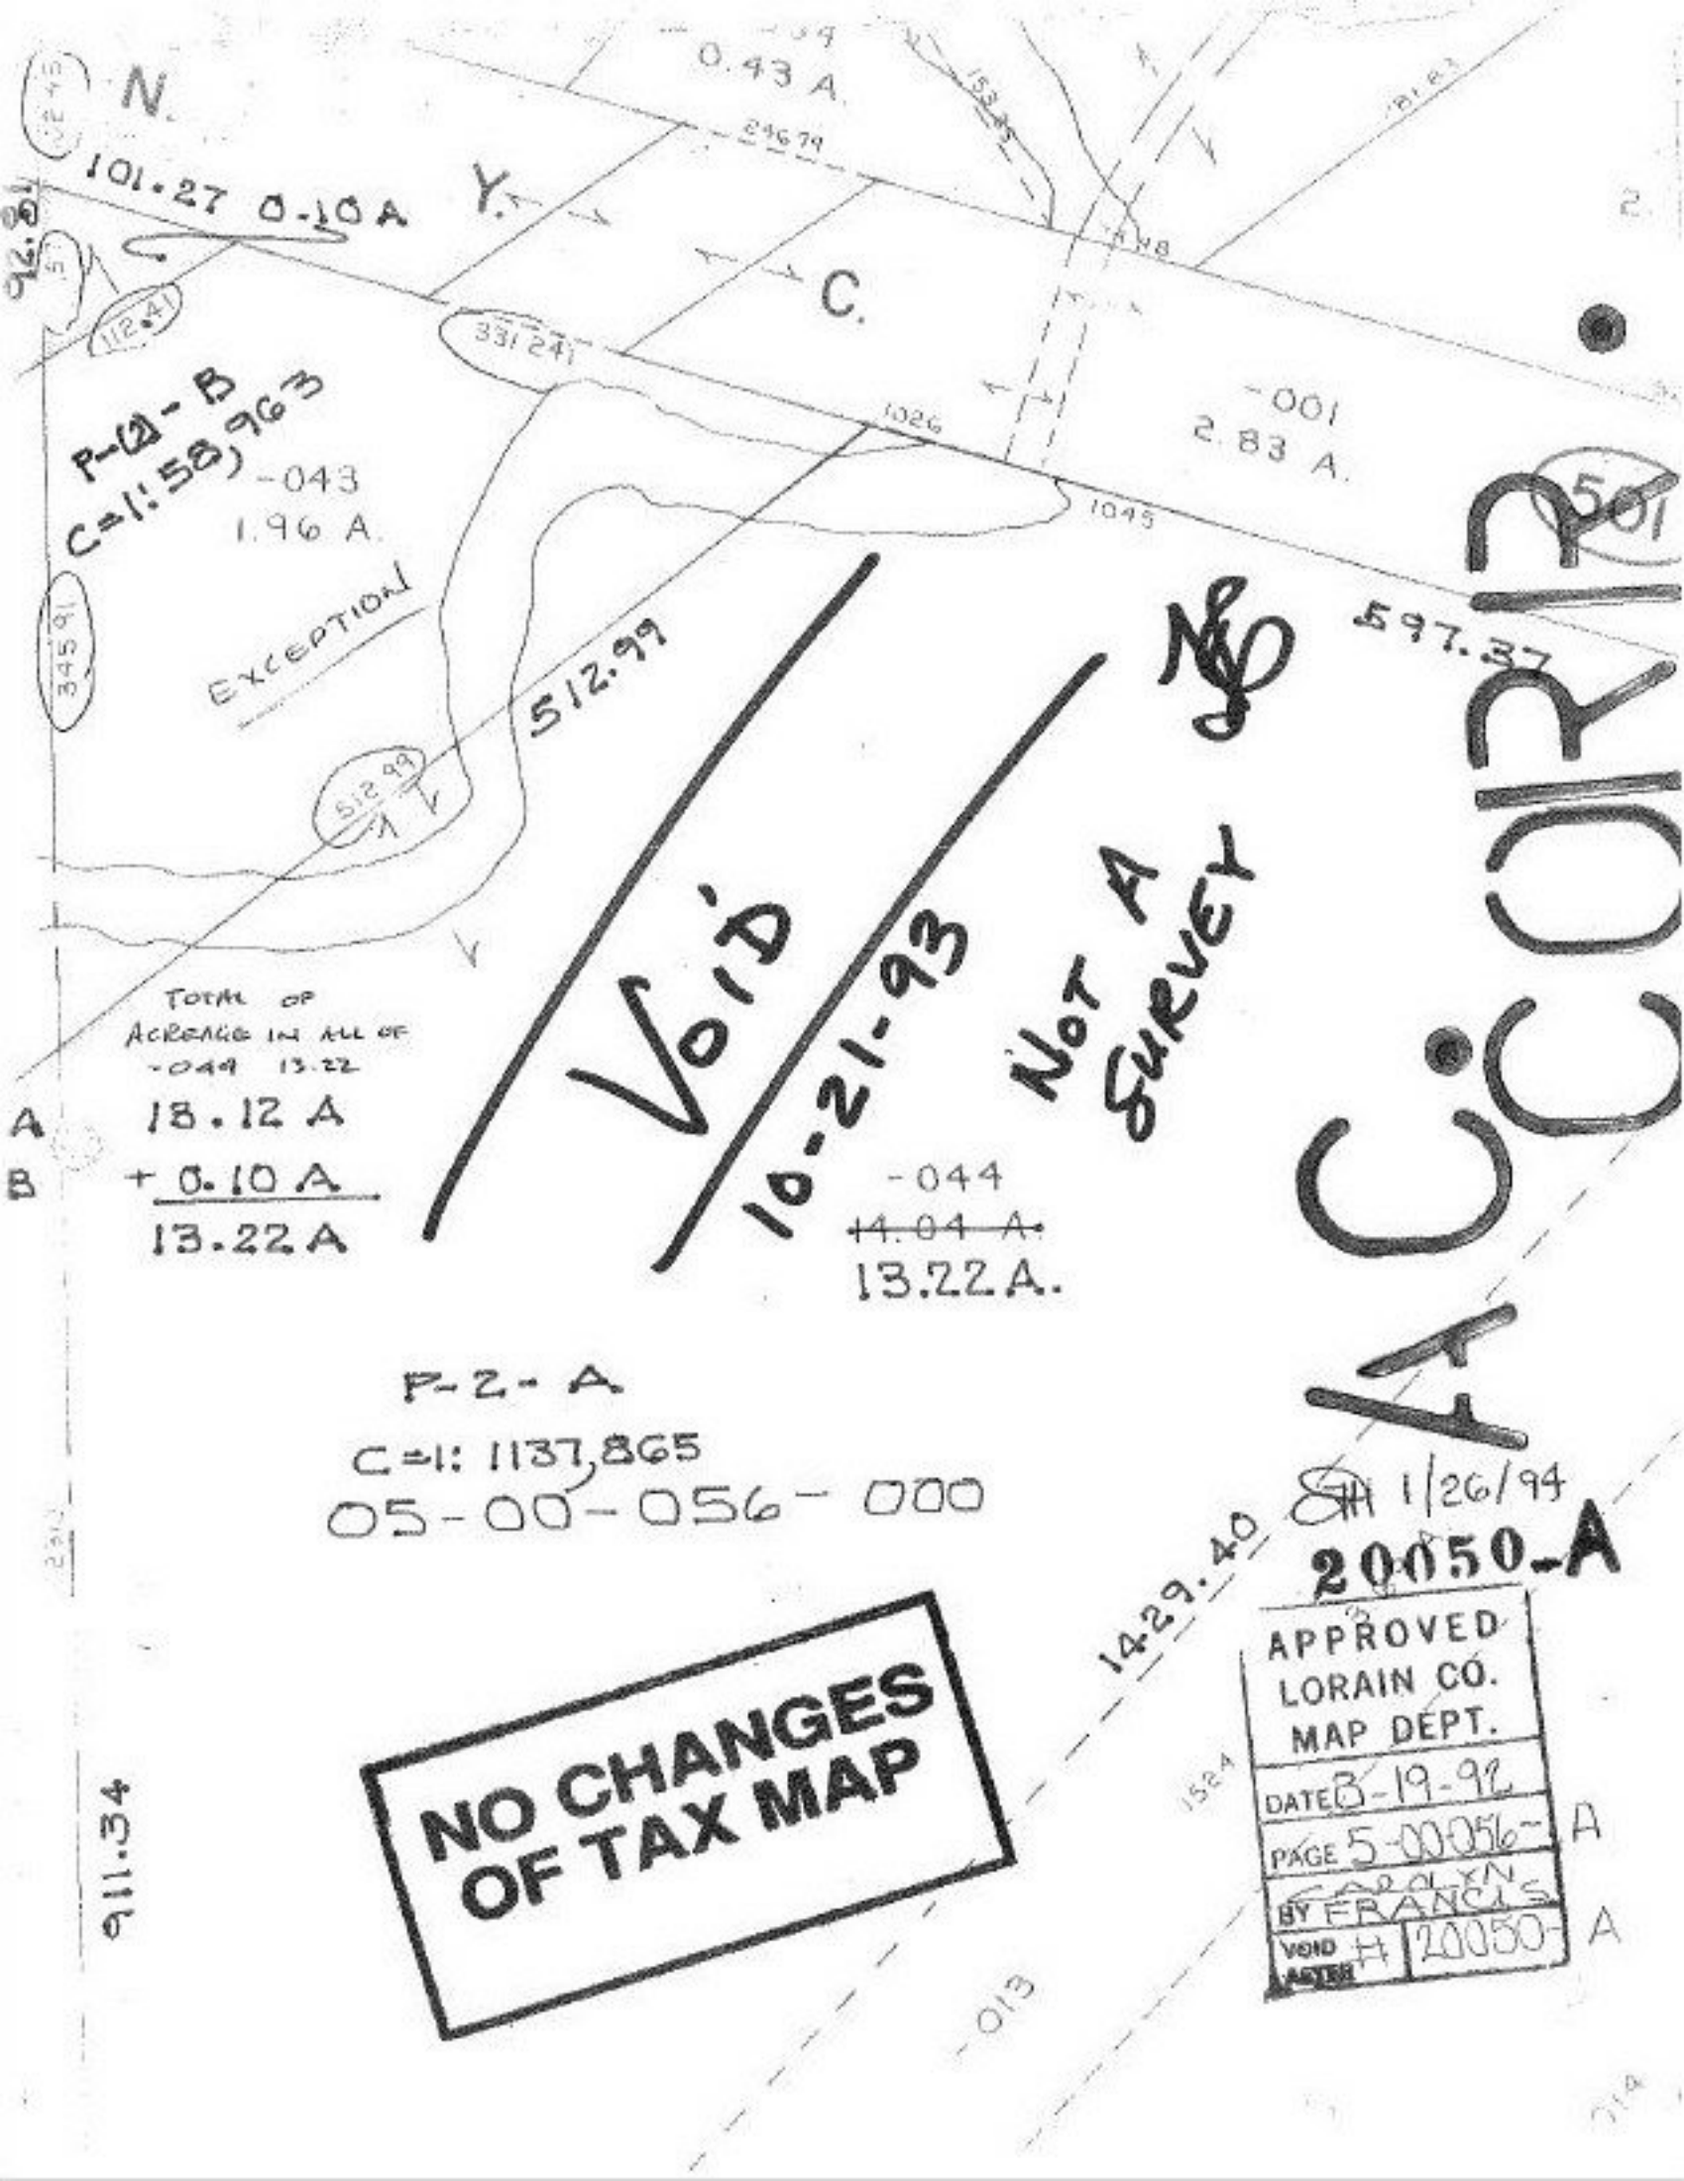
N.
101.27 0.10 A
Y.
C.
0.43 A
-001
2.83 A.
P-2-B
C=1:58,963
-043
1.96 A.
EXCEPTION
512.99
597.87
1045
1026
331.24
345.91
112.41
96.81
TOTAL OF ACREAGE IN ALL OF -049 13.22
18.12 A
+ 0.10 A
13.22 A
A
B
VOID
10-21-93
NOT A SURVEY
-044
~~14.04 A.~~
13.22 A.
P-2-A
C=1: 1137,865
05-00-056-000
1/26/94
20050-A
APPROVED
LORAIN CO.
MAP DEPT.
DATE 3-19-92
PAGE 5-00056-A
BY FRANCIS
VOID AFTER #
20050-A
NO CHANGES OF TAX MAP
911.34
1429.40