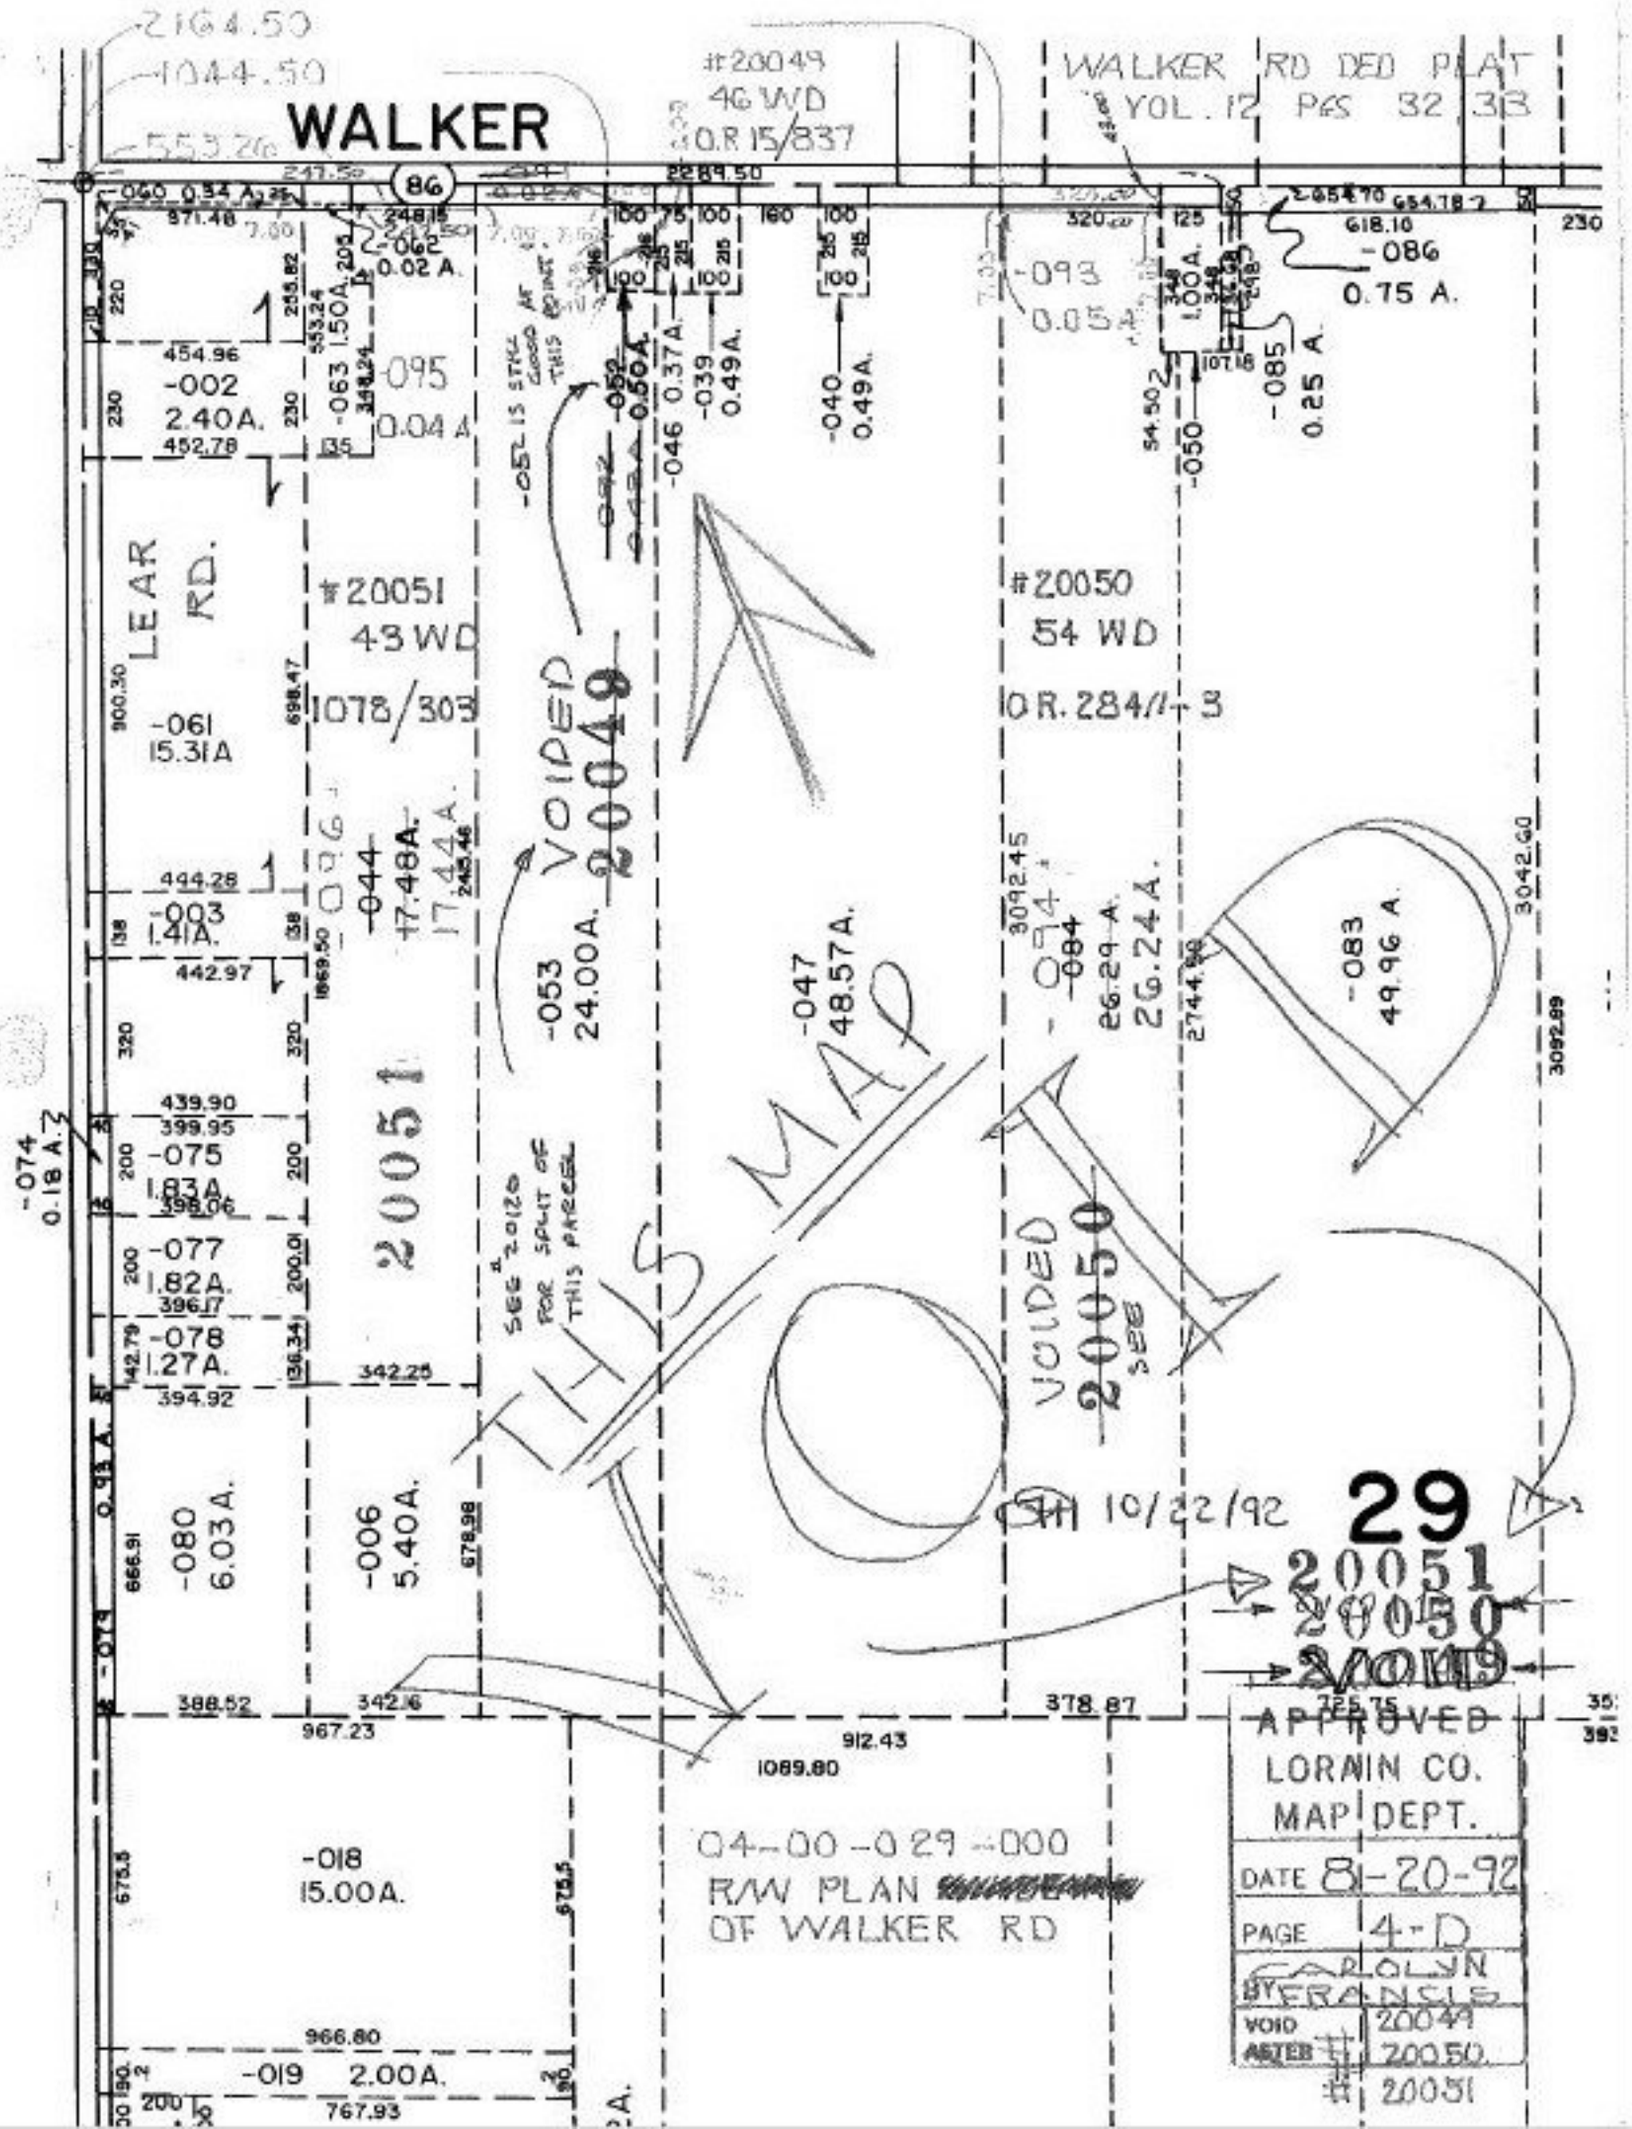

WALKER
#20049
46 WD
O.R. 15/837
WALKER RD DED PLAT
VOL. 12 PGS 32, 33
LEAR RD.
#20051
43 WD
1078/303
#20050
54 WD
O.R. 284/1-3
VOIDED 20049
VOIDED 20050
THIS MAP
20051
-002
2.40A.
-061
15.31A
-003
1.41A.
-075
1.83A.
-077
1.82A.
-078
1.27A.
-080
6.03A.
-006
5.40A.
-018
15.00A.
-019
2.00A.
-053
24.00A.
-047
48.57A.
-083
49.96 A.
-086
0.75 A.
-085
0.25 A.
-093
0.05A.
-040
0.49A.
-039
0.49A.
-046
0.37A.
-052
0.50A.
-063
1.50A.
-095
0.04 A
-062
0.02 A.
-074
0.18 A.
-084
26.29 A.
26.24 A.
-050
-052 IS STILL GOOD AT THIS POINT
SEE #20120 FOR SPLIT OF THIS PARCEL
SH 10/22/92
29
20051
20050
20049
04-00-029-000
R/W PLAN
OF WALKER RD
APPROVED
LORAIN CO.
MAP DEPT.
DATE 8-20-92
PAGE 4-D
BY CAROLYN FRANCIS
VOID 20049
ASTER # 20050
20051