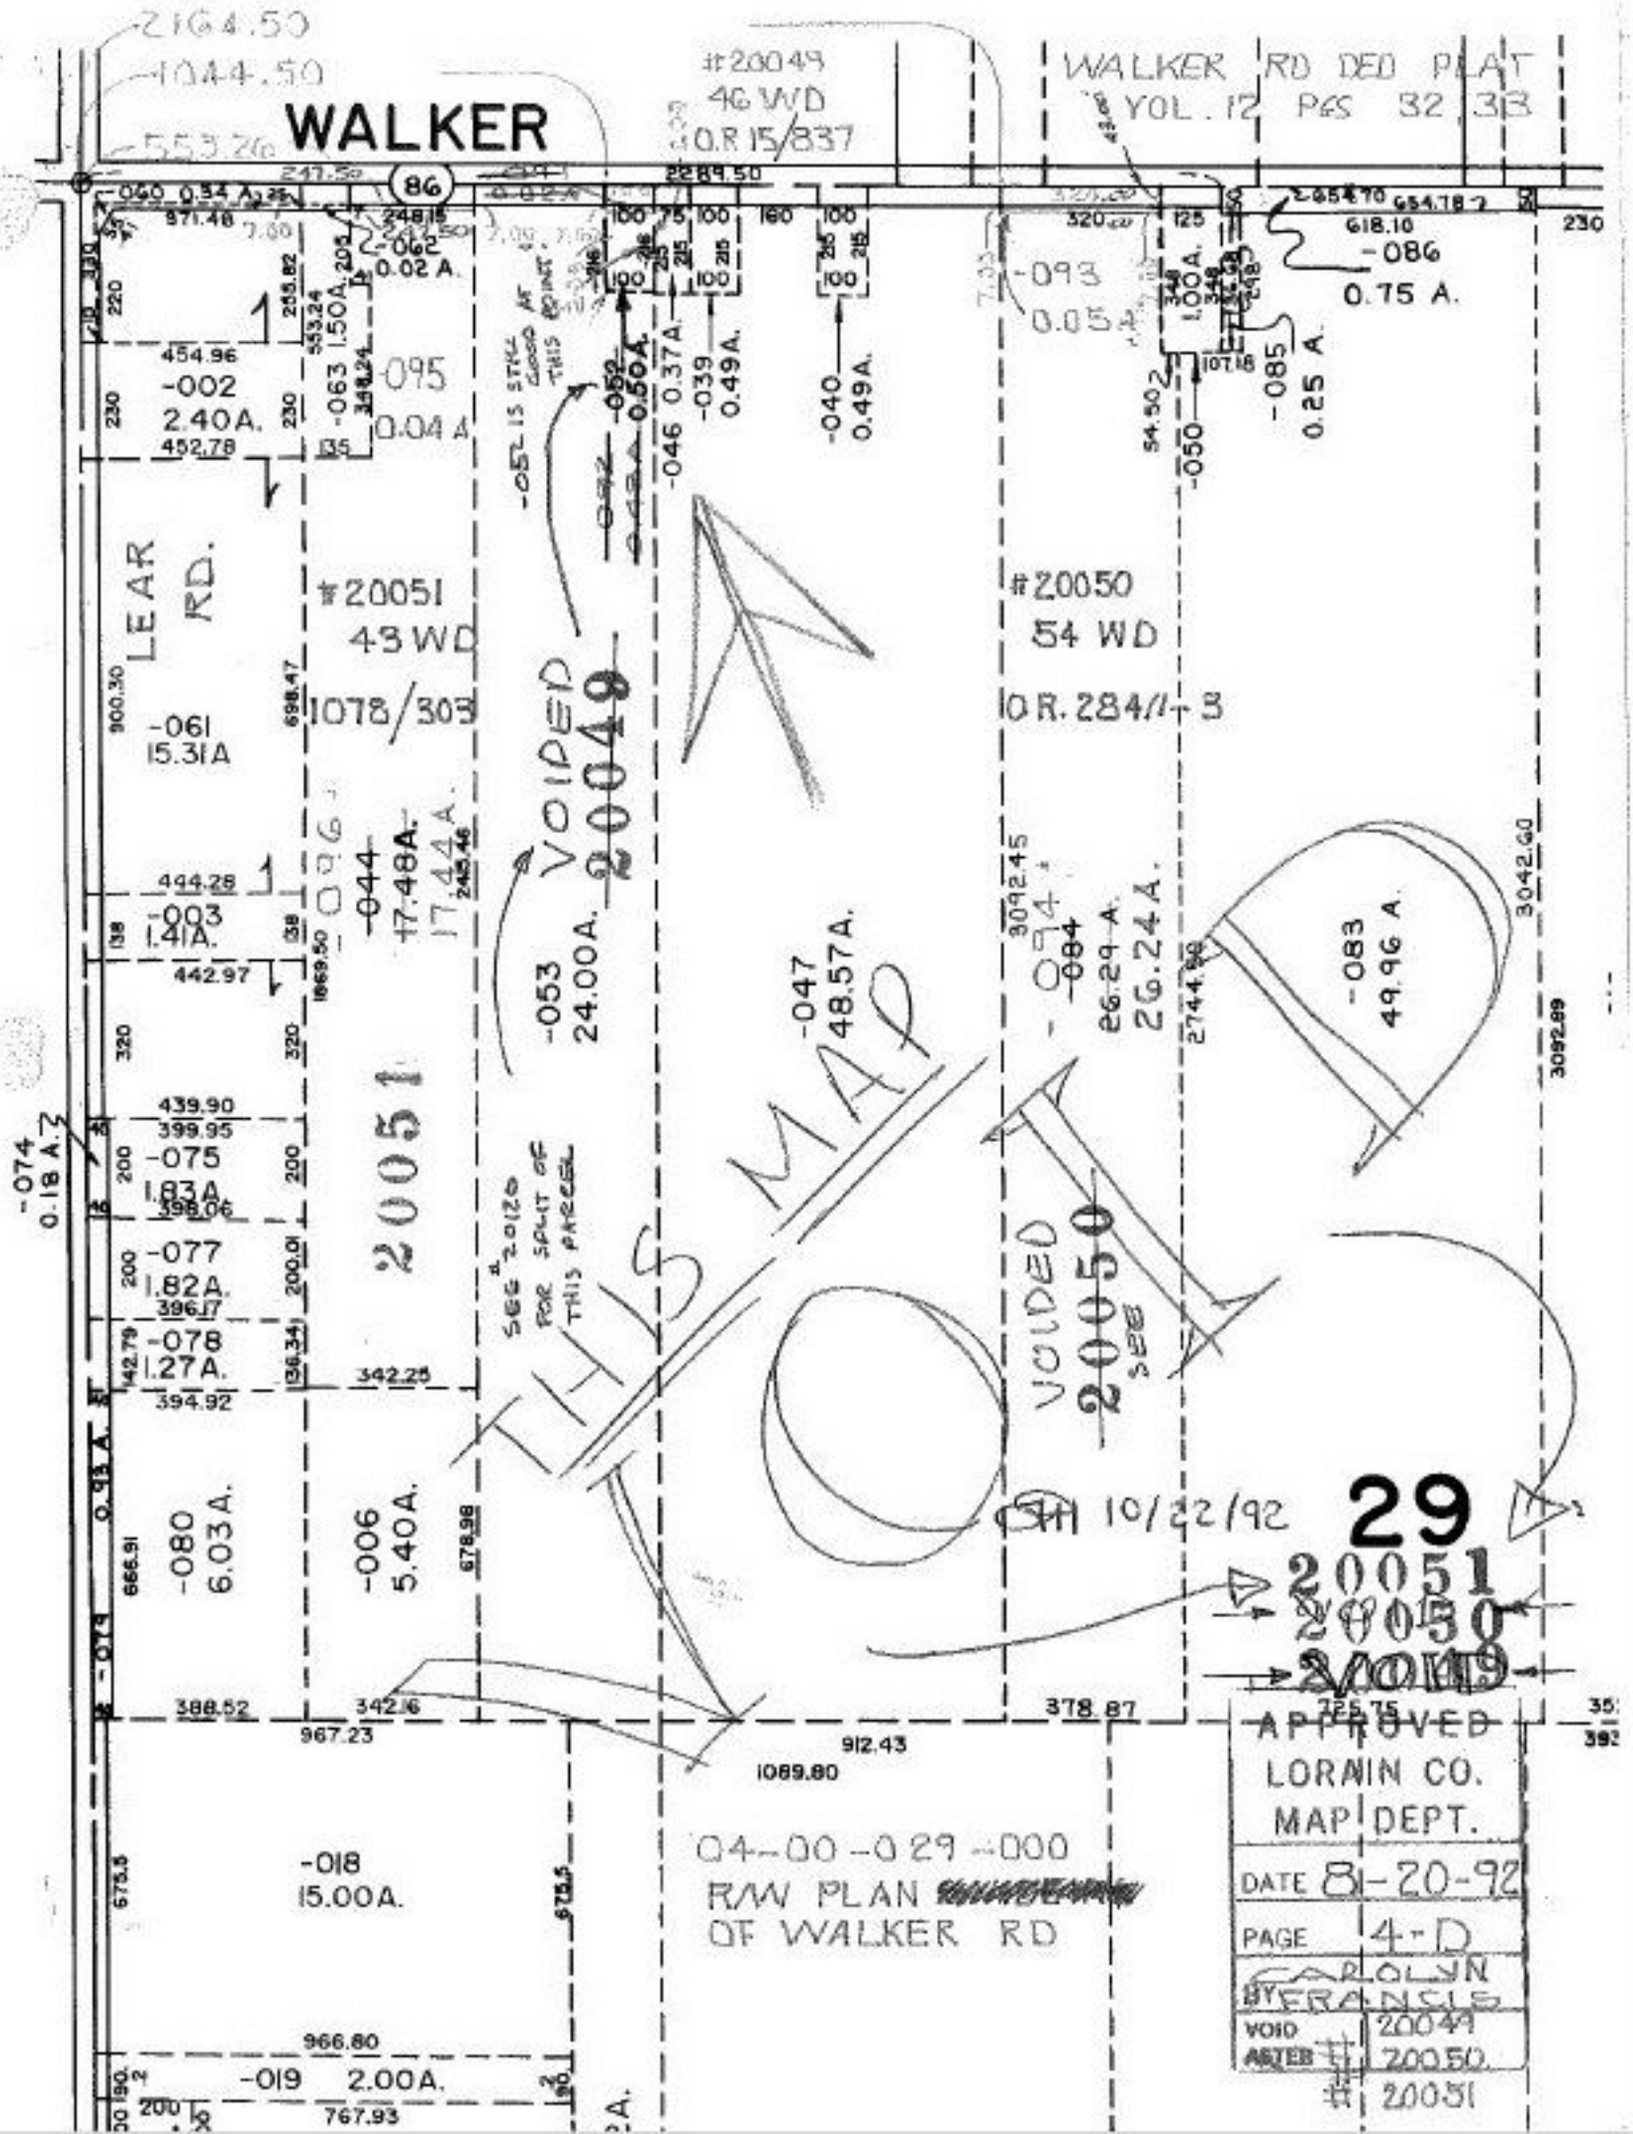
WALKER
WALKER RD DED PLAT
VOL. 12 PGS 32 33
#20049
46 WD
O.R 15/837
#20051
43 WD
1078/303
#20050
54 WD
O.R. 284/1-3
LEAR RD.
VOIDED 20049
VOIDED 20050
SEE #20120 FOR SPLIT OF THIS PARCEL
THIS MAP
-061 15.31A
-002 2.40A.
-003 1.41A.
-074 0.18 A.
-075 1.83A.
-077 1.82A.
-078 1.27A.
-080 6.03A.
-006 5.40A.
-018 15.00A.
-019 2.00A.
-053 24.00A.
-047 48.57A.
-083 49.96 A.
-084 26.29 A.
26.24 A.
17.48A.
17.44 A.
-086 0.75 A.
-085 0.25 A.
-062 0.02 A.
-093 0.05 A.
-095 0.04 A.
-063 1.50A.
-046 0.37A.
-039 0.49A.
-040 0.49A.
-052 0.50A.
04-00-029-000
R/W PLAN OF WALKER RD
10/22/92
29
20051
20050
20049
APPROVED
LORAIN CO.
MAP DEPT.
DATE 8-20-92
PAGE 4-D
CAROLYN
BY FRANCIS
VOID AFTER
20049
20050
20051