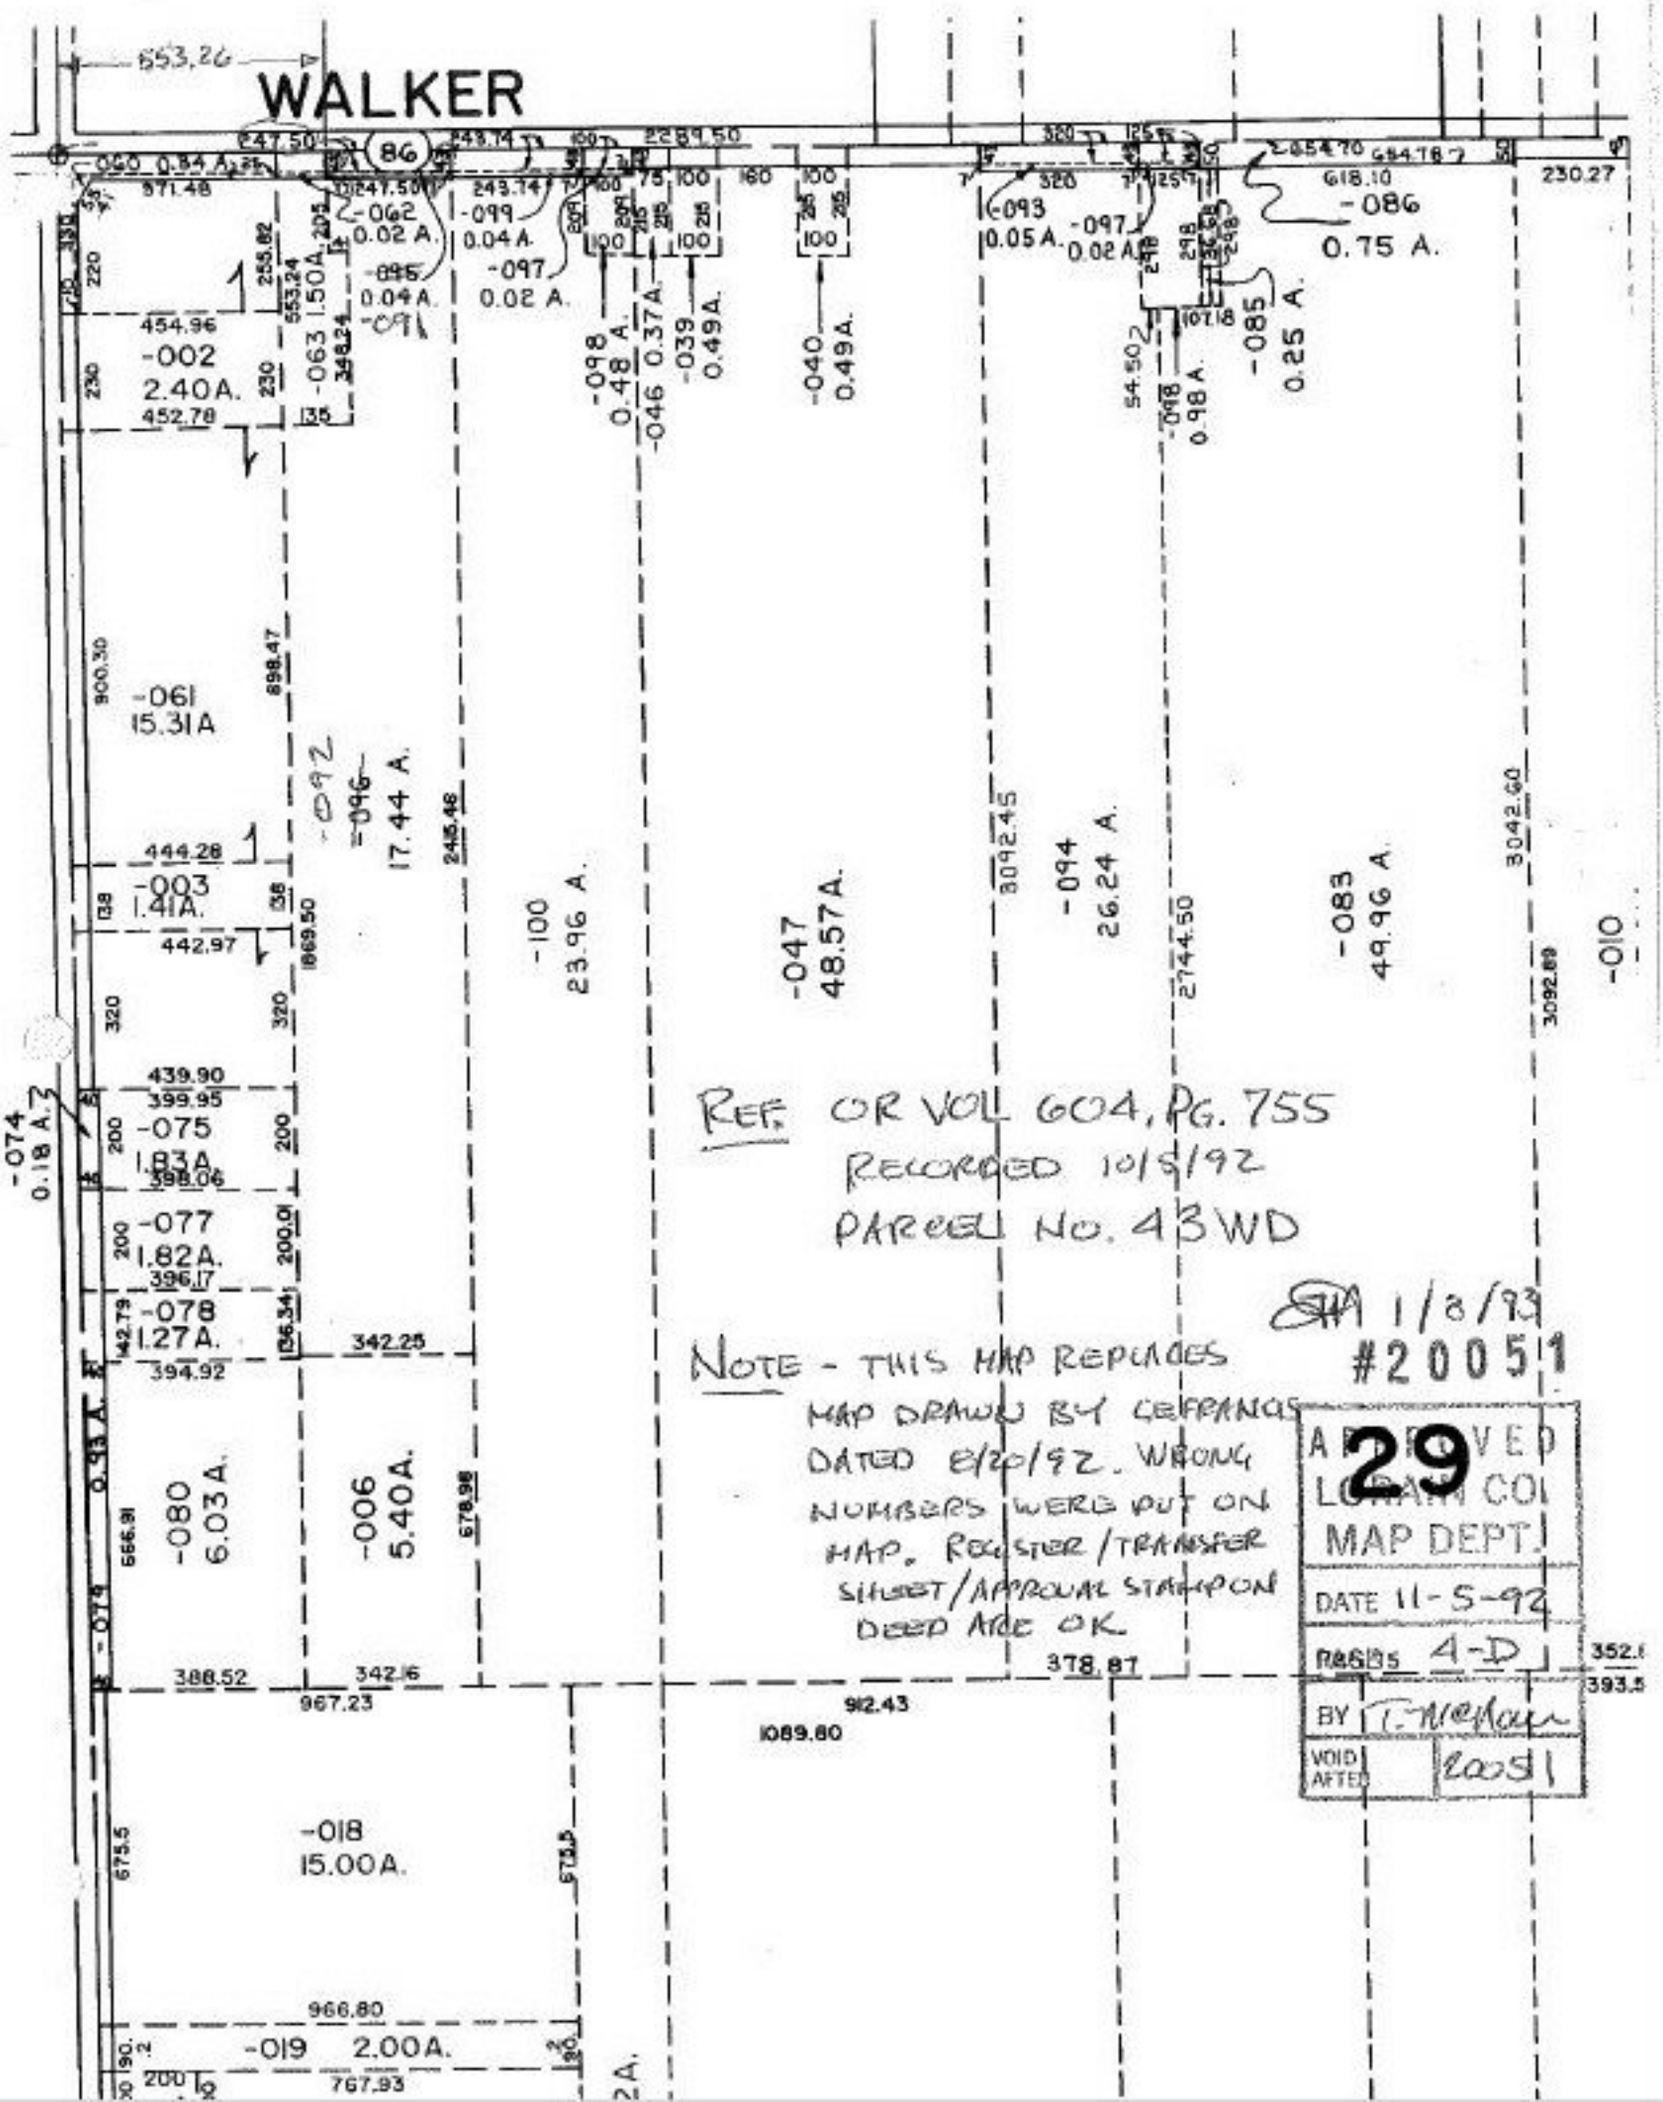
WALKER
553.26
86
-062
0.02 A.
-099
0.04 A.
-097
0.02 A.
-093
0.05 A.
-097
0.02 A.
-086
0.75 A.
-085
0.25 A.
-098
0.98 A.
-098
0.48 A.
-046
0.37 A.
-039
0.49 A.
-040
0.49 A.
-002
2.40 A.
-063
1.50 A.
-061
15.31 A
-092
-096
17.44 A.
-100
23.96 A.
-047
48.57 A.
-094
26.24 A.
-083
49.96 A.
-010
-003
1.41 A.
-075
1.83 A.
-074
0.18 A.
-077
1.82 A.
-078
1.27 A.
-080
6.03 A.
-006
5.40 A.
-018
15.00 A.
-019
2.00 A.
REF. OR VOL 604, PG. 755
RECORDED 10/5/92
PARCEL NO. 43WD
NOTE - THIS MAP REPLACES
MAP DRAWN BY CEFRANCIS
DATED 8/20/92. WRONG
NUMBERS WERE PUT ON
MAP. REGISTER/TRANSFER
SHEET/APPROVAL STAMP ON
DEED ARE OK.
1/8/93
#20051
29
APPROVED
LORAIN CO.
MAP DEPT.
DATE 11-5-92
PAGES 4-D
BY T. McNair
VOID AFTER 20051