20053 A

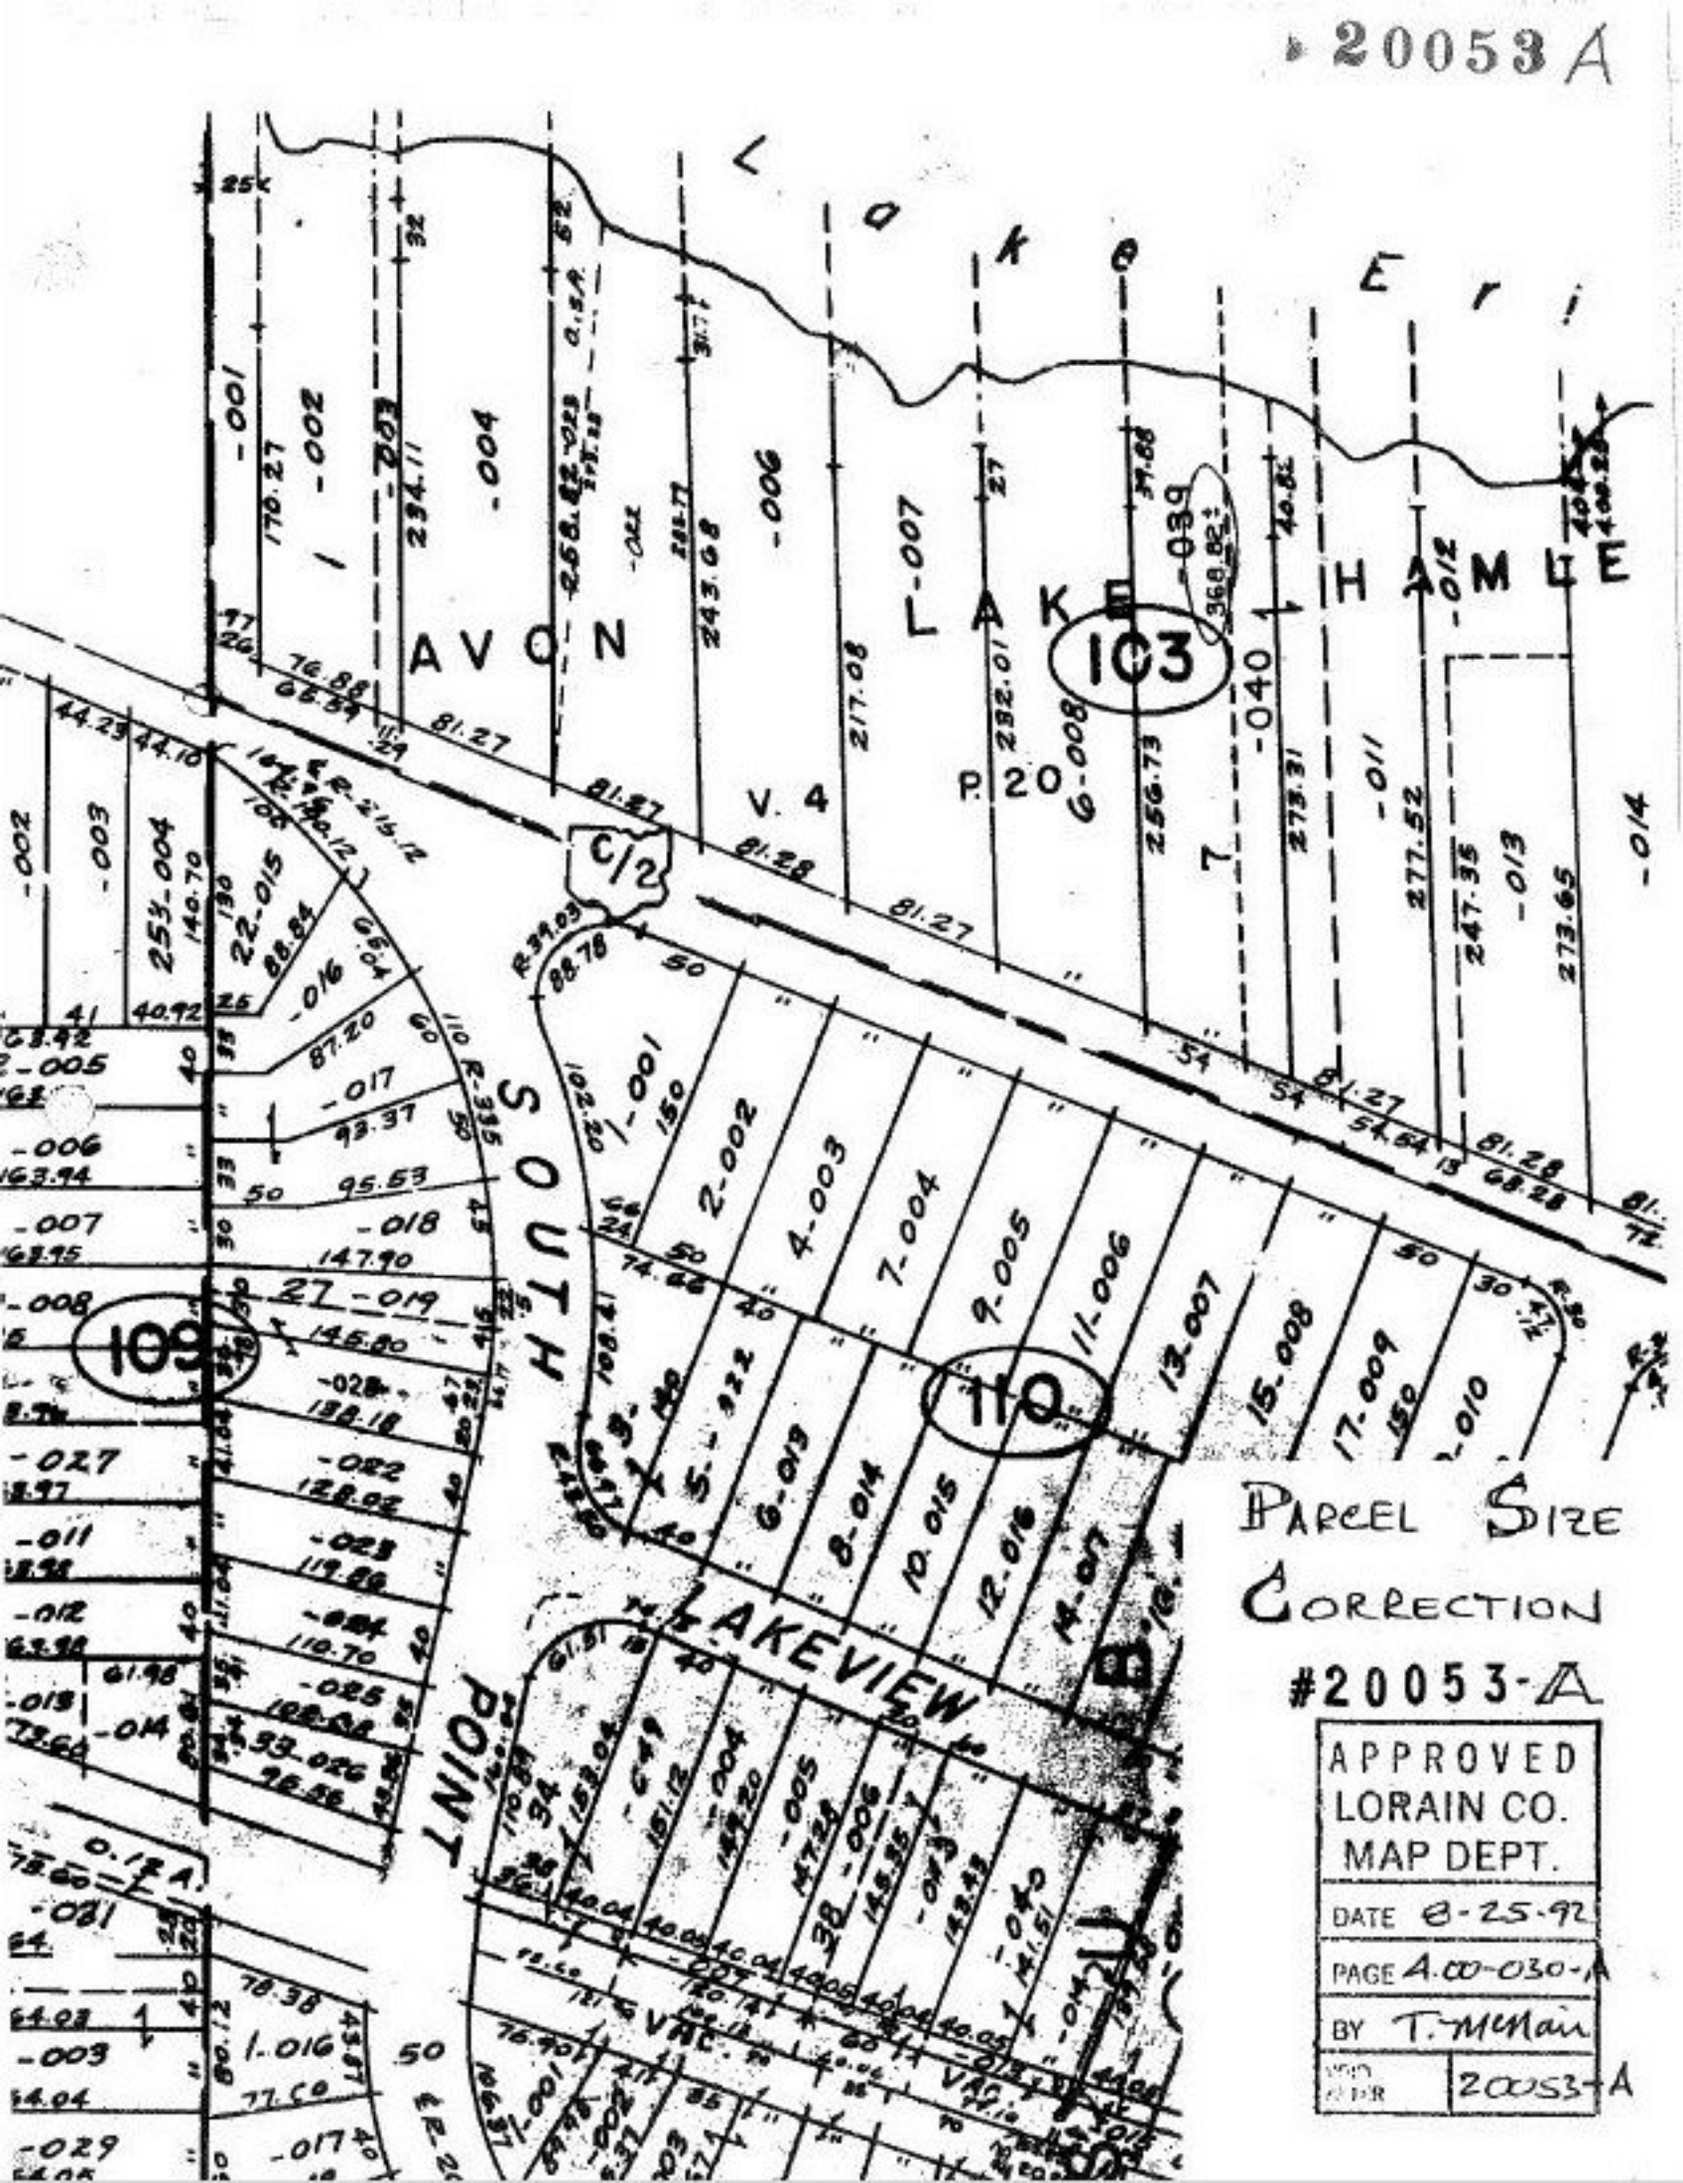

PARCEL SIZE CORRECTION

#20053-A

APPROVED LORAIN CO. MAP DEPT.	
DATE	8-25-92
PAGE	A.00-030-A
BY	T. McMain
MAP NBR	20053-A