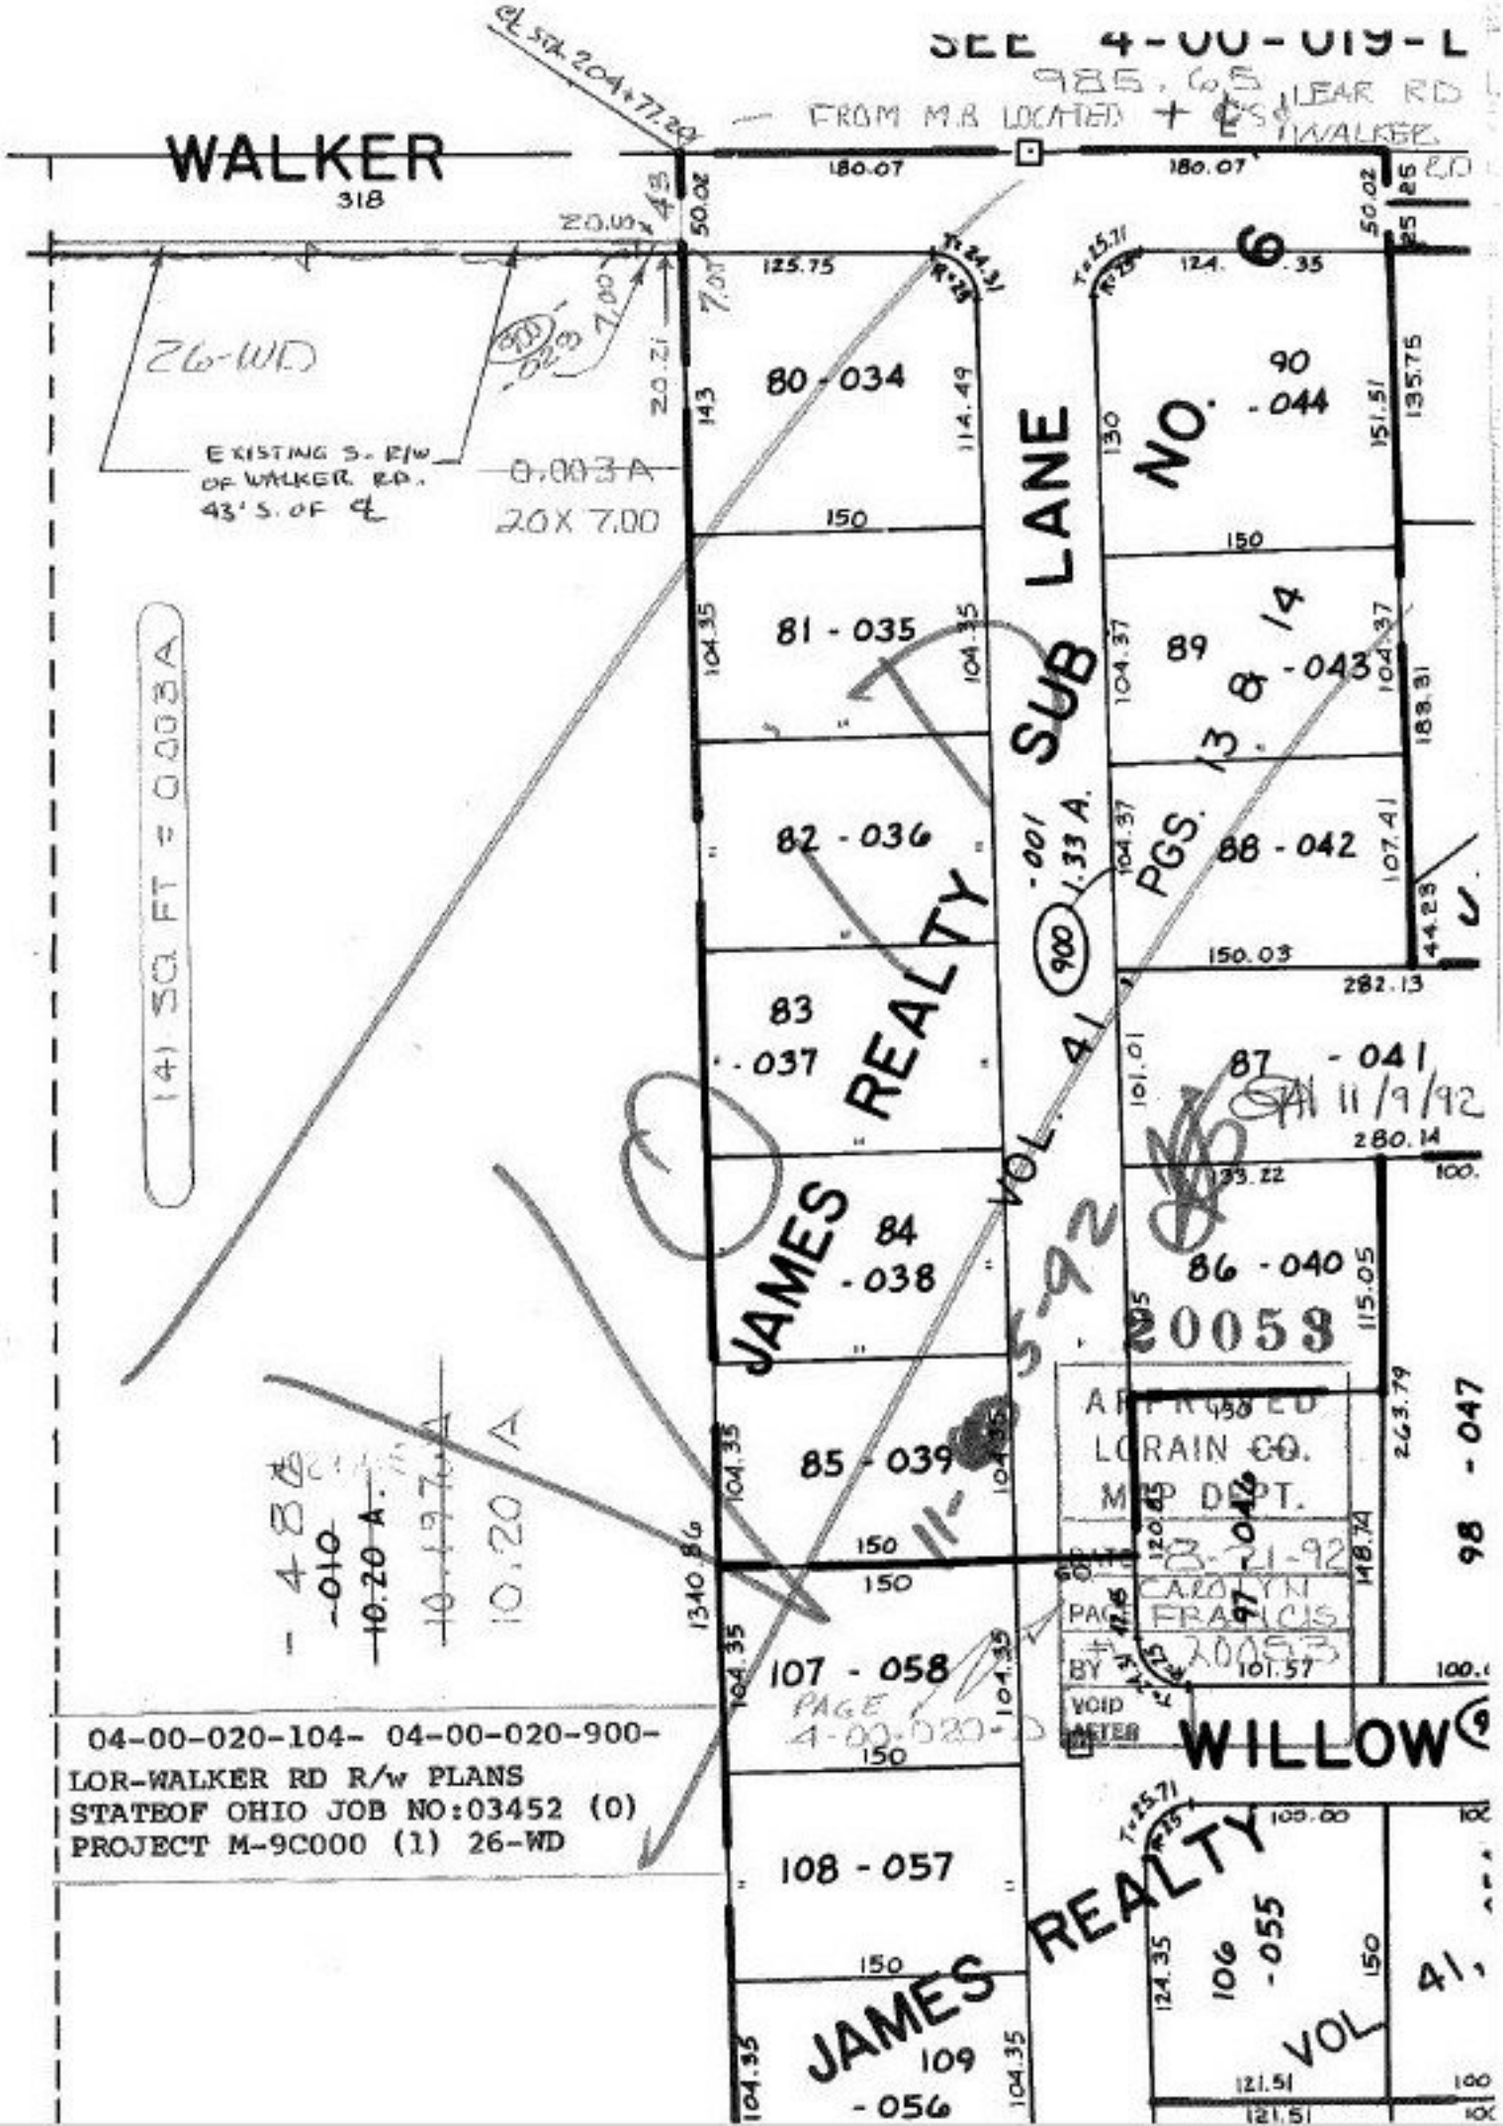
SEE 4-00-019-L
985.65 FROM M.B LOCATED + ℄ LEAR RD WALKER RD
WALKER
318
℄ STA. 204+77.20
26-WD
EXISTING S. R/W OF WALKER RD. 43' S. OF ℄
0.003 A
20 X 7.00
(4) SQ FT = 0.003 A
80 - 034
81 - 035
82 - 036
83 - 037
84 - 038
85 - 039
107 - 058
108 - 057
109 - 056
90 - 044
89 - 043
88 - 042
87 - 041
86 - 040
98 - 047
106 - 055
JAMES REALTY SUB LANE
VOL. 41
PGS. 13 & 14
900 - 001 1.33 A.
11-5-92
11/9/92
20053
APPROVED LORAIN CO. MAP DEPT.
DATE 8-21-92
CAROLYN FRANCIS
BY
VOID AFTER
WILLOW
JAMES REALTY
VOL 41
PAGE 4-00-020-D
04-00-020-104- 04-00-020-900-
LOR-WALKER RD R/w PLANS
STATEOF OHIO JOB NO:03452 (0)
PROJECT M-9C000 (1) 26-WD