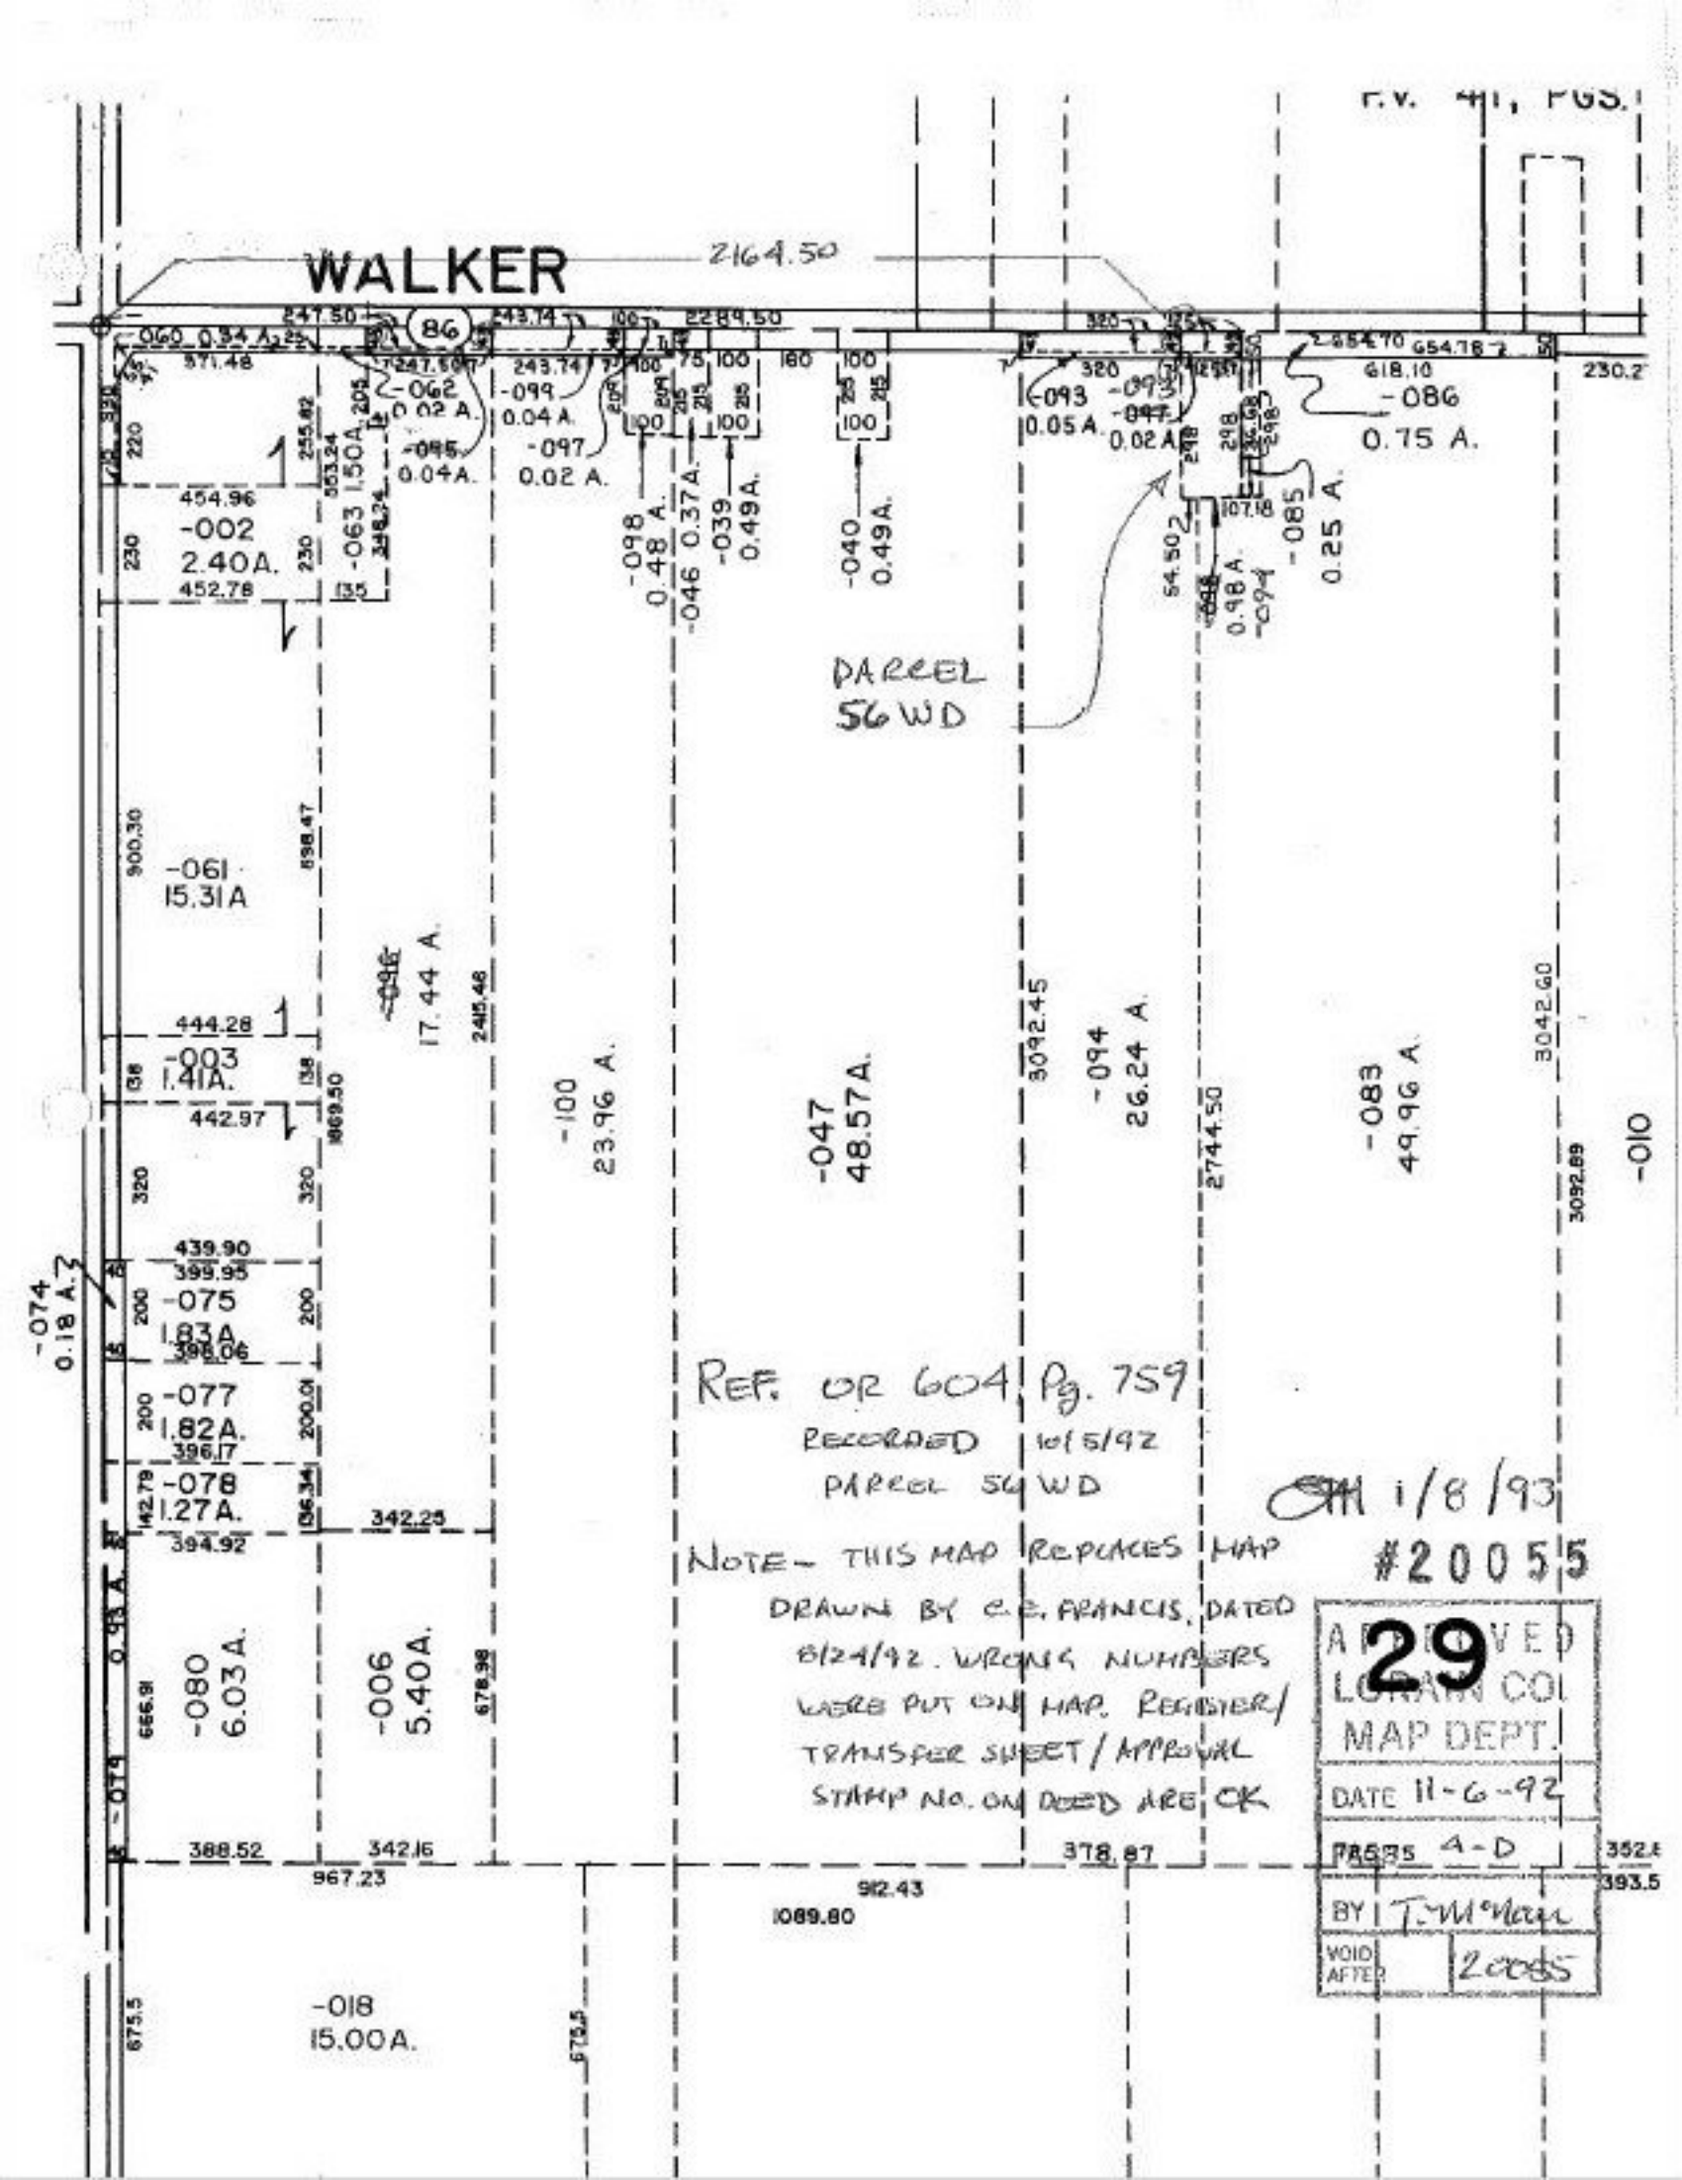
WALKER
2164.50
86
-060 0.54 A.
-062 0.02 A.
-095 0.04 A.
-099 0.04 A.
-097 0.02 A.
-098 0.48 A.
-046 0.37 A.
-039 0.49 A.
-040 0.49 A.
-093 0.05 A.
-097 0.02 A.
-086 0.75 A.
-085 0.25 A.
-094 0.98 A.
-063 1.50 A.
-002 2.40 A.
PARCEL 56 WD
-061 15.31 A.
-096 17.44 A.
-100 23.96 A.
-047 48.57 A.
-094 26.24 A.
-083 49.96 A.
-010
-003 1.41 A.
-075 1.83 A.
-077 1.82 A.
-078 1.27 A.
-074 0.18 A.
-080 6.03 A.
-006 5.40 A.
-018 15.00 A.
REF. OR 604 Pg. 759
RECORDED 10/5/92
PARCEL 56 WD
1/8/93
#20055
NOTE- THIS MAP REPLACES MAP DRAWN BY C.E. FRANCIS, DATED 8/24/92. WRONG NUMBERS WERE PUT ON MAP. REGISTER/ TRANSFER SHEET / APPROVAL STAMP NO. ON DEED ARE OK
29
APPROVED
LORAIN CO.
MAP DEPT.
DATE 11-6-92
PARCELS A-D
BY T.M. McNair
VOID AFTER 2005