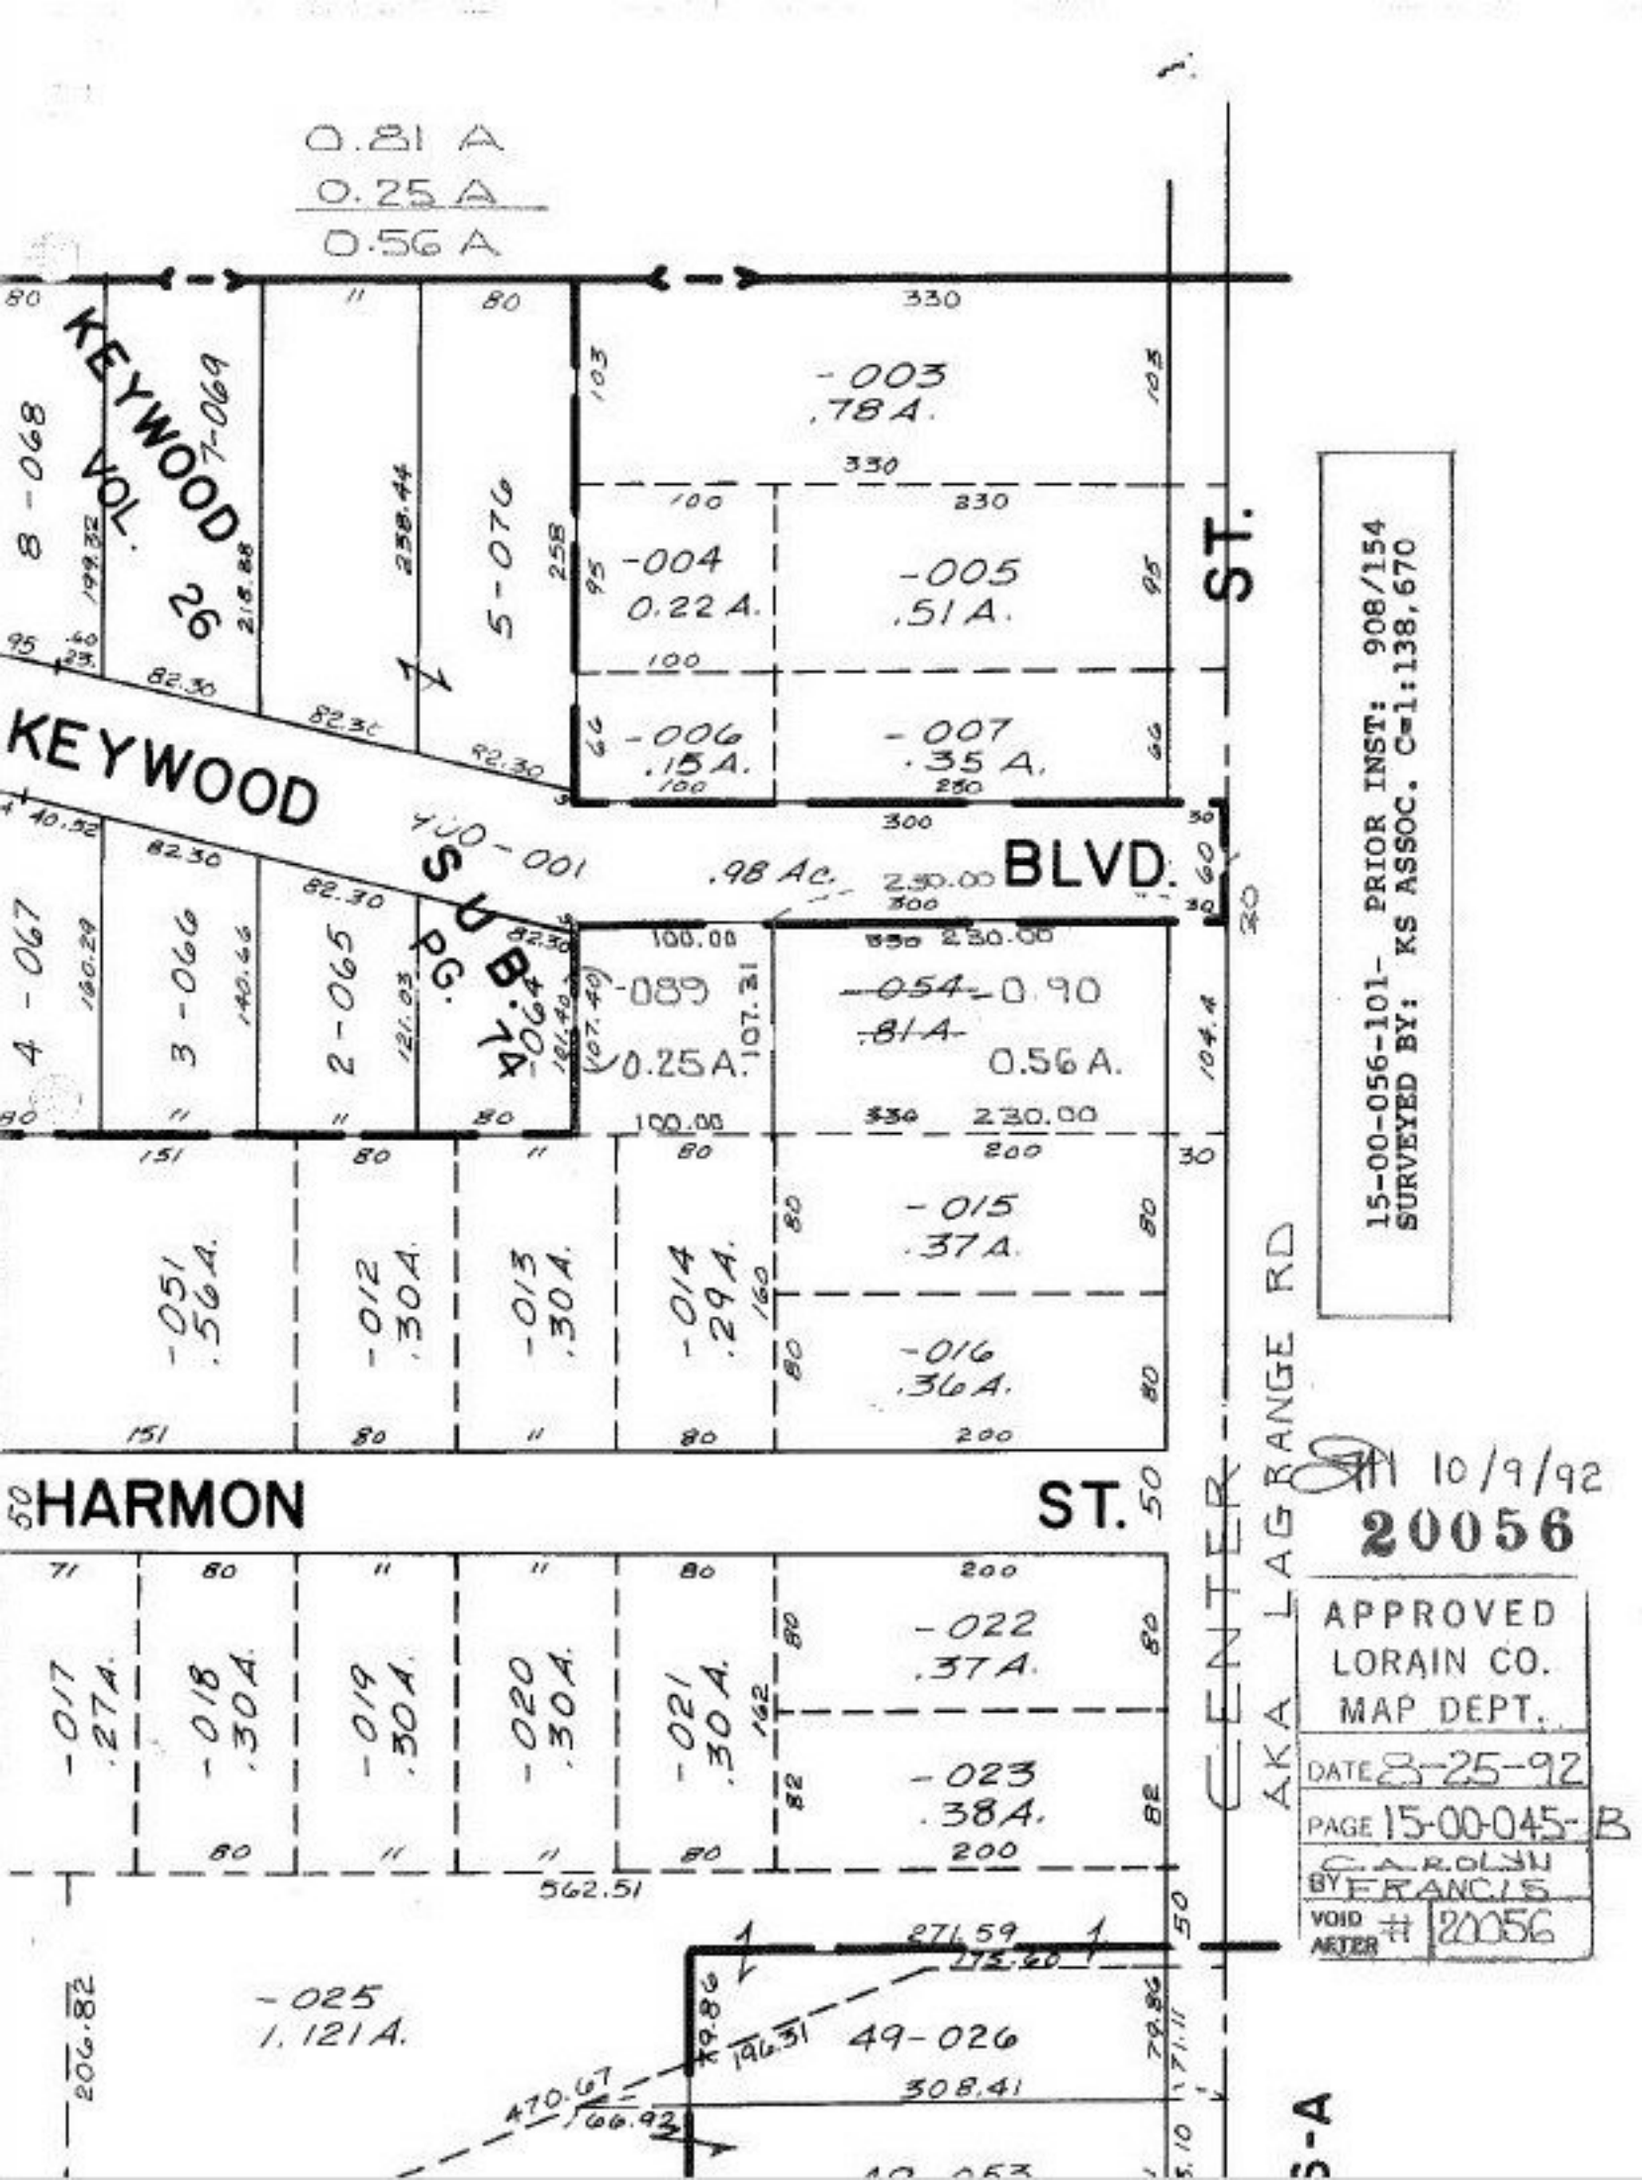
0.81 A
0.25 A
0.56 A
KEYWOOD
8-068
4-067
3-066
2-065
5-076
-003
.78 A.
-004
0.22 A.
-005
.51 A.
-006
.15 A.
-007
.35 A.
700-001
.98 Ac.
KEYWOOD BLVD.
ST.
-089
0.25 A.
-054
.81 A.
0.90
0.56 A.
-051
.56 A.
-012
.30 A.
-013
.30 A.
-014
.29 A.
-015
.37 A.
-016
.36 A.
HARMON ST.
-017
.27 A.
-018
.30 A.
-019
.30 A.
-020
.30 A.
-021
.30 A.
-022
.37 A.
-023
.38 A.
562.51
CENTER
AKA LAGRANGE RD
-025
1.121 A.
49-026
308.41
206.82
470.67
166.92
196.31
272.59
272.20
S-A
15-00-056-101- PRIOR INST: 908/154
SURVEYED BY: KS ASSOC. C=1:138,670
APPROVED
LORAIN CO.
MAP DEPT.
DATE 8-25-92
PAGE 15-00-045- B
CAROLYN
BY FRANCIS
VOID AFTER # 20056
10/9/92
20056