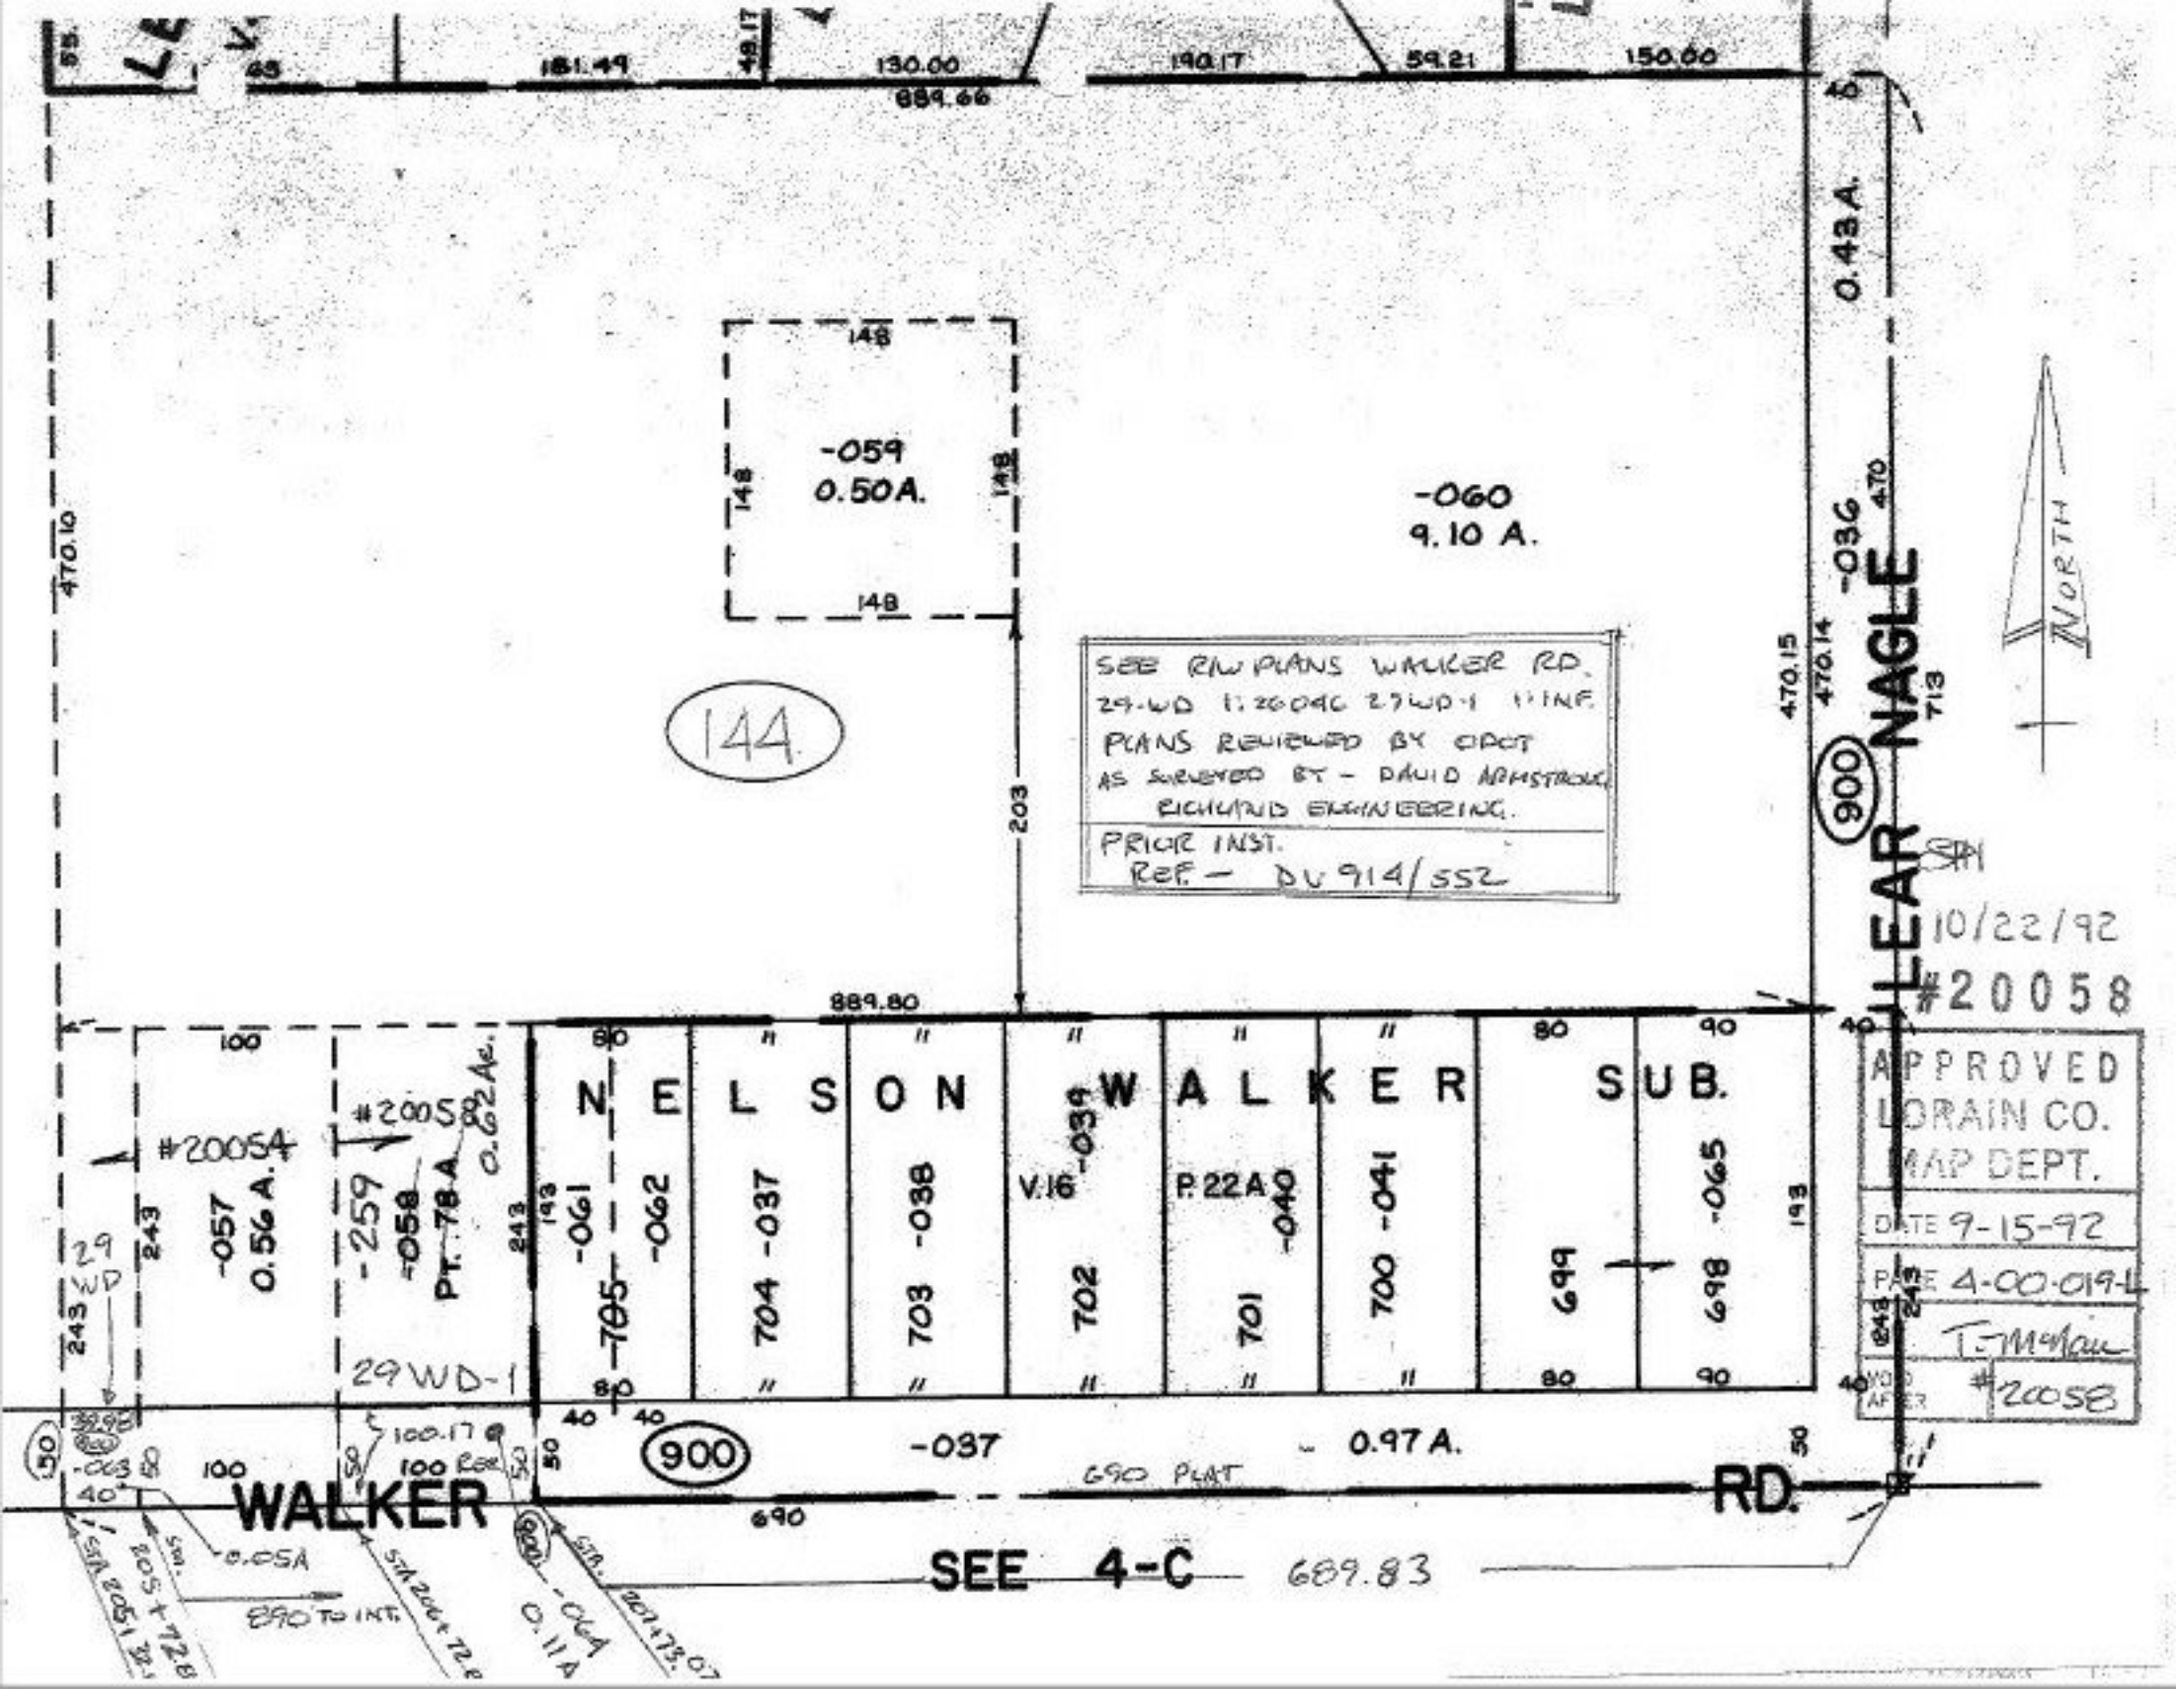
181.49
130.00
190.17
59.21
150.00
889.66
0.43 A.
-059
0.50A.
-060
9.10 A.
144
470.10
203
SEE R/W PLANS WALKER RD.
29-WD 1:26046 29WD-1 1:1NF.
PLANS REVIEWED BY ODOT
AS SURVEYED BY - DAVID ARMSTRONG
RICHLAND ENGINEERING.
PRIOR INST.
REF. - DV 914/552
-036
470.15
470.14
713
900
NORTH
NLEAR NAGLE
10/22/92
#20058
889.80
NELSON WALKER SUB.
#20054
-057
0.56 A.
#20058
-259
-058
PT. 78 A.
0.62 Ac.
-061
-705
-062
704 -037
703 -038
V.16 -039
702
P.22A
701 -040
700 -041
699
698 -065
29 WD
29WD-1
-063
0.05A
100.17
100 Rec.
900
-037
0.97 A.
690 PLAT
WALKER RD.
690
SEE 4-C
689.83
890 TO INT.
-064
0.11A
APPROVED
LORAIN CO.
MAP DEPT.
DATE 9-15-92
PAGE 4-00-019-L
T. McGuire
#20058