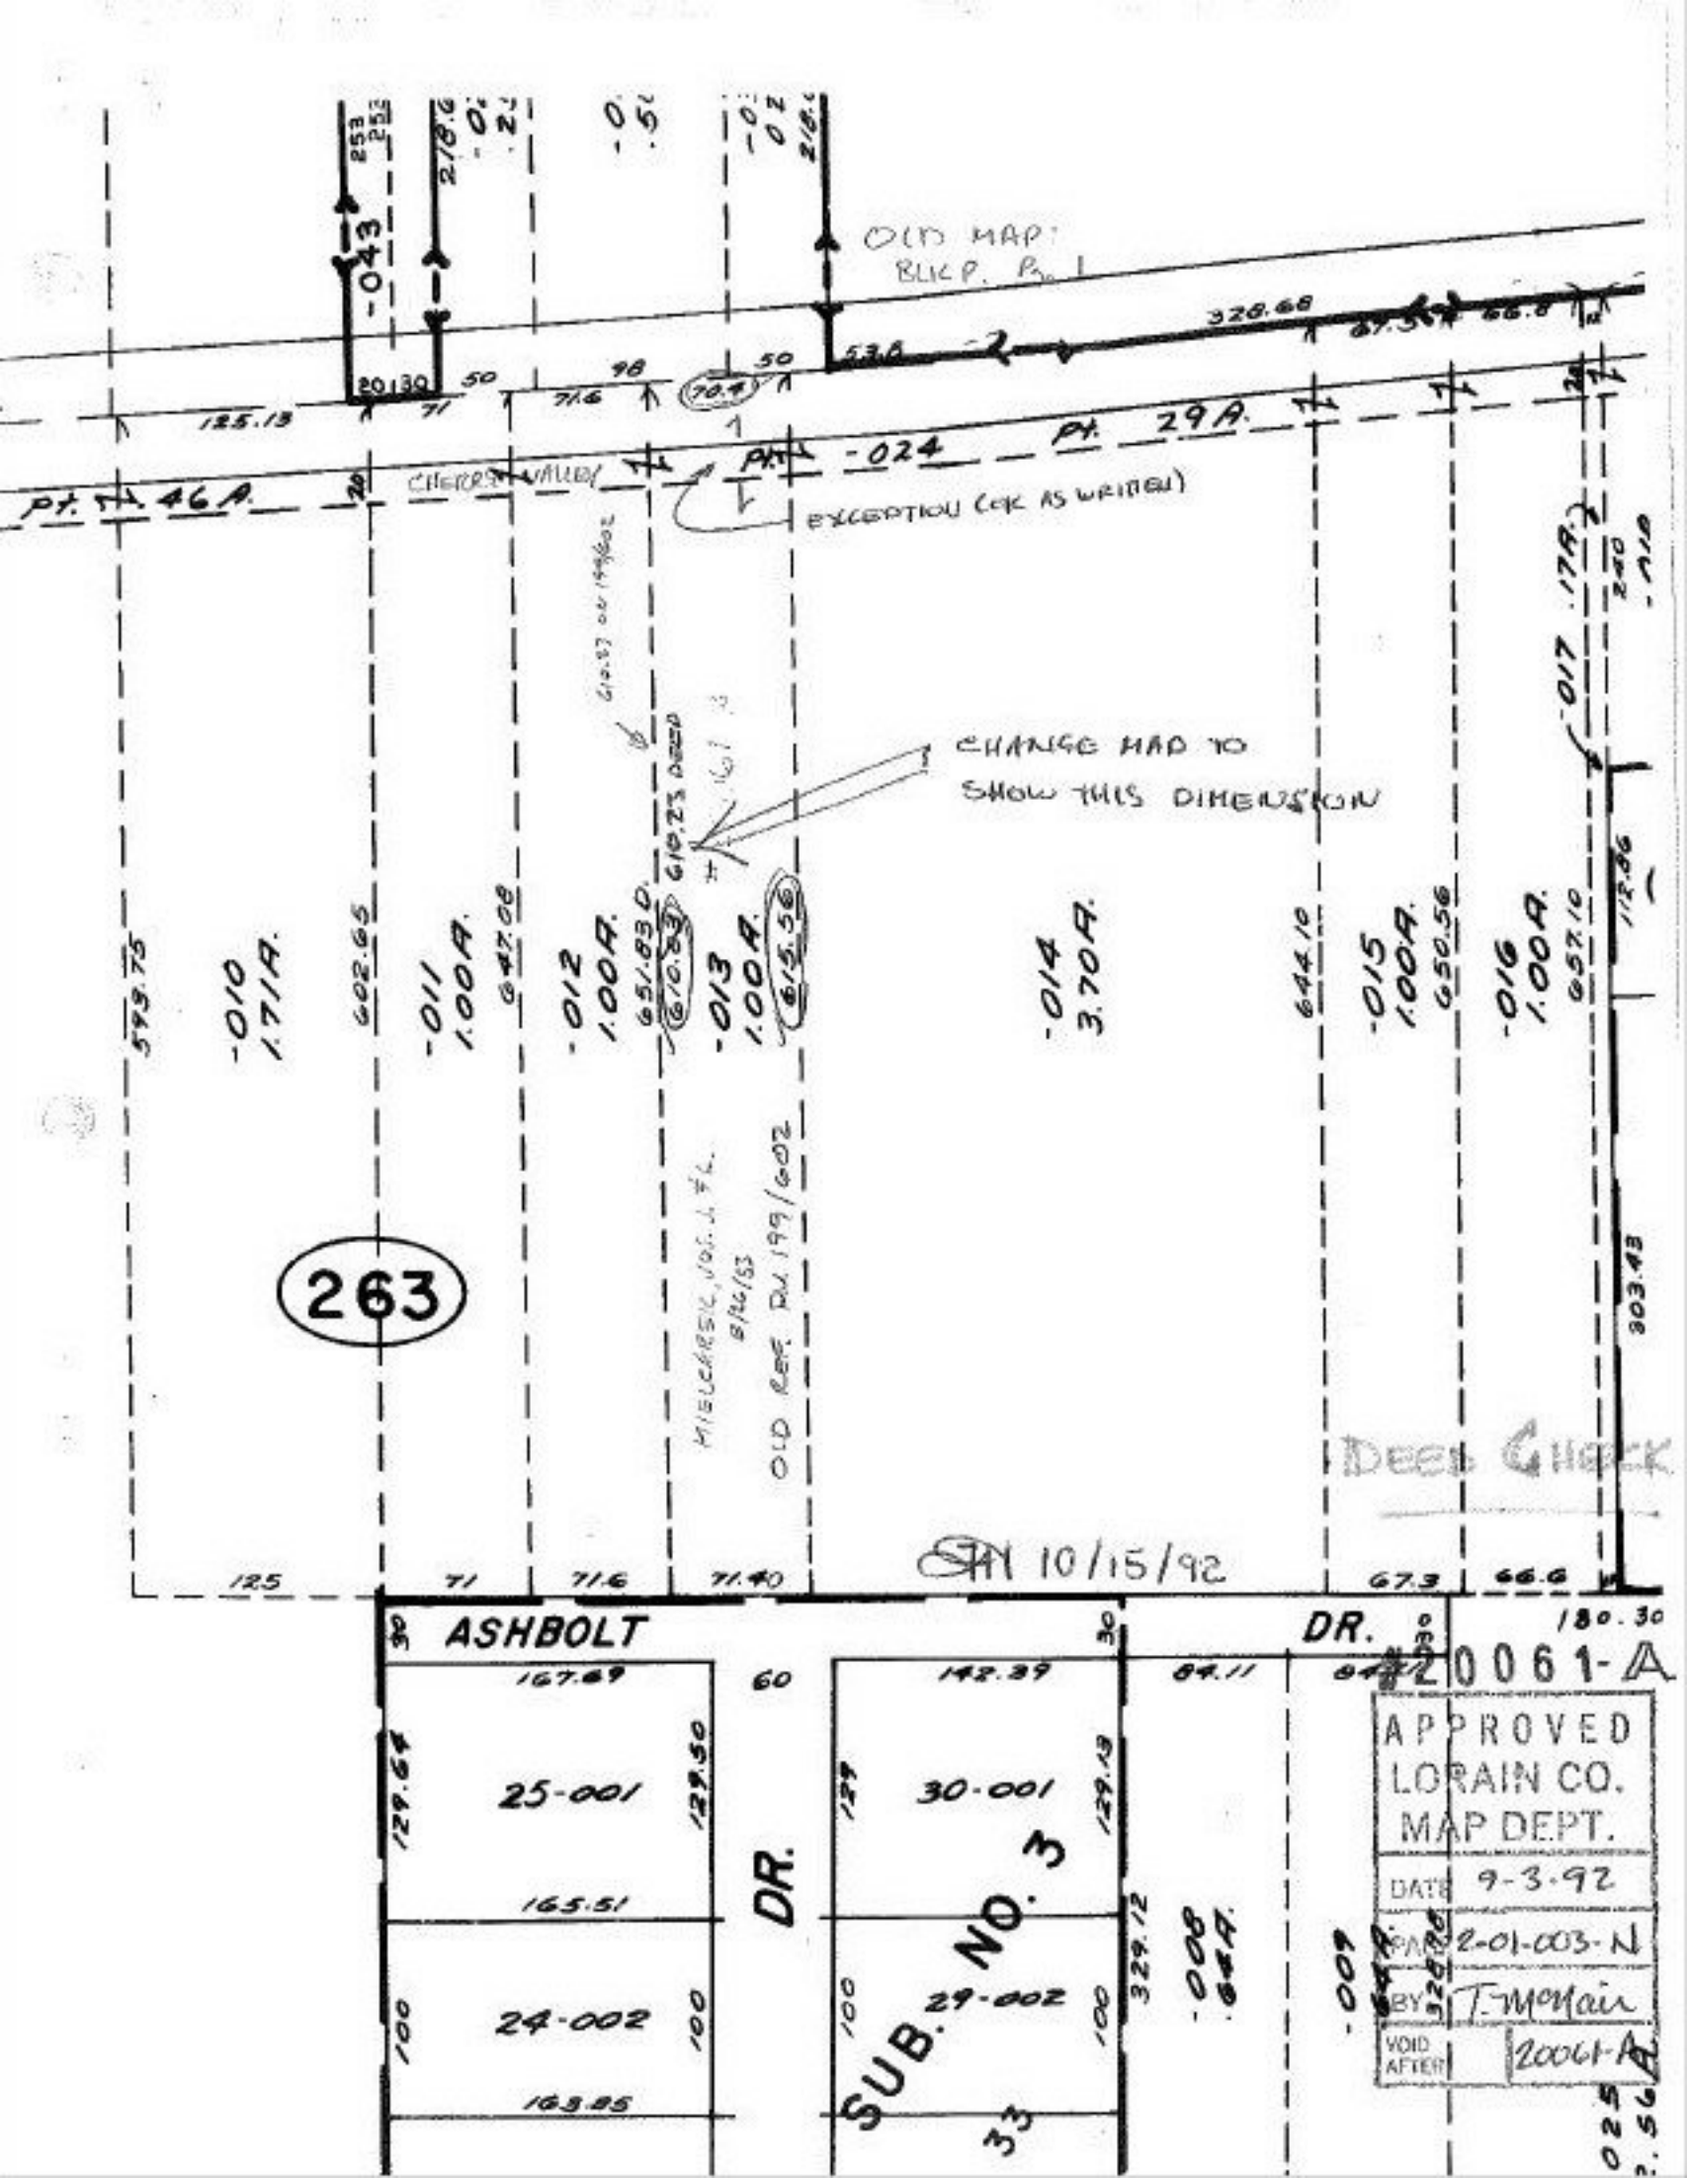
OLD MAP: BLK P. Pg. 1
CHERRY VALLEY
EXCEPTION (OK AS WRITTEN)
CHANGE MAP TO SHOW THIS DIMENSION
Pt. 46 A.
Pt. -024
Pt. 29 A.
-010 1.71 A.
-011 1.00 A.
-012 1.00 A.
-013 1.00 A.
-014 3.70 A.
-015 1.00 A.
-016 1.00 A.
-017 .17 A.
263
MIELCARSIC, JOS. J. & L. 8/26/83
OLD REF. DV. 199/602
DEED CHECK
10/15/92
ASHBOLT DR.
SUB. NO. 3
25-001
24-002
30-001
29-002
#20061-A
APPROVED LORAIN CO. MAP DEPT.
DATE 9-3-92
PAR 2-01-003-N
BY T. McNair
VOID AFTER 20061-A