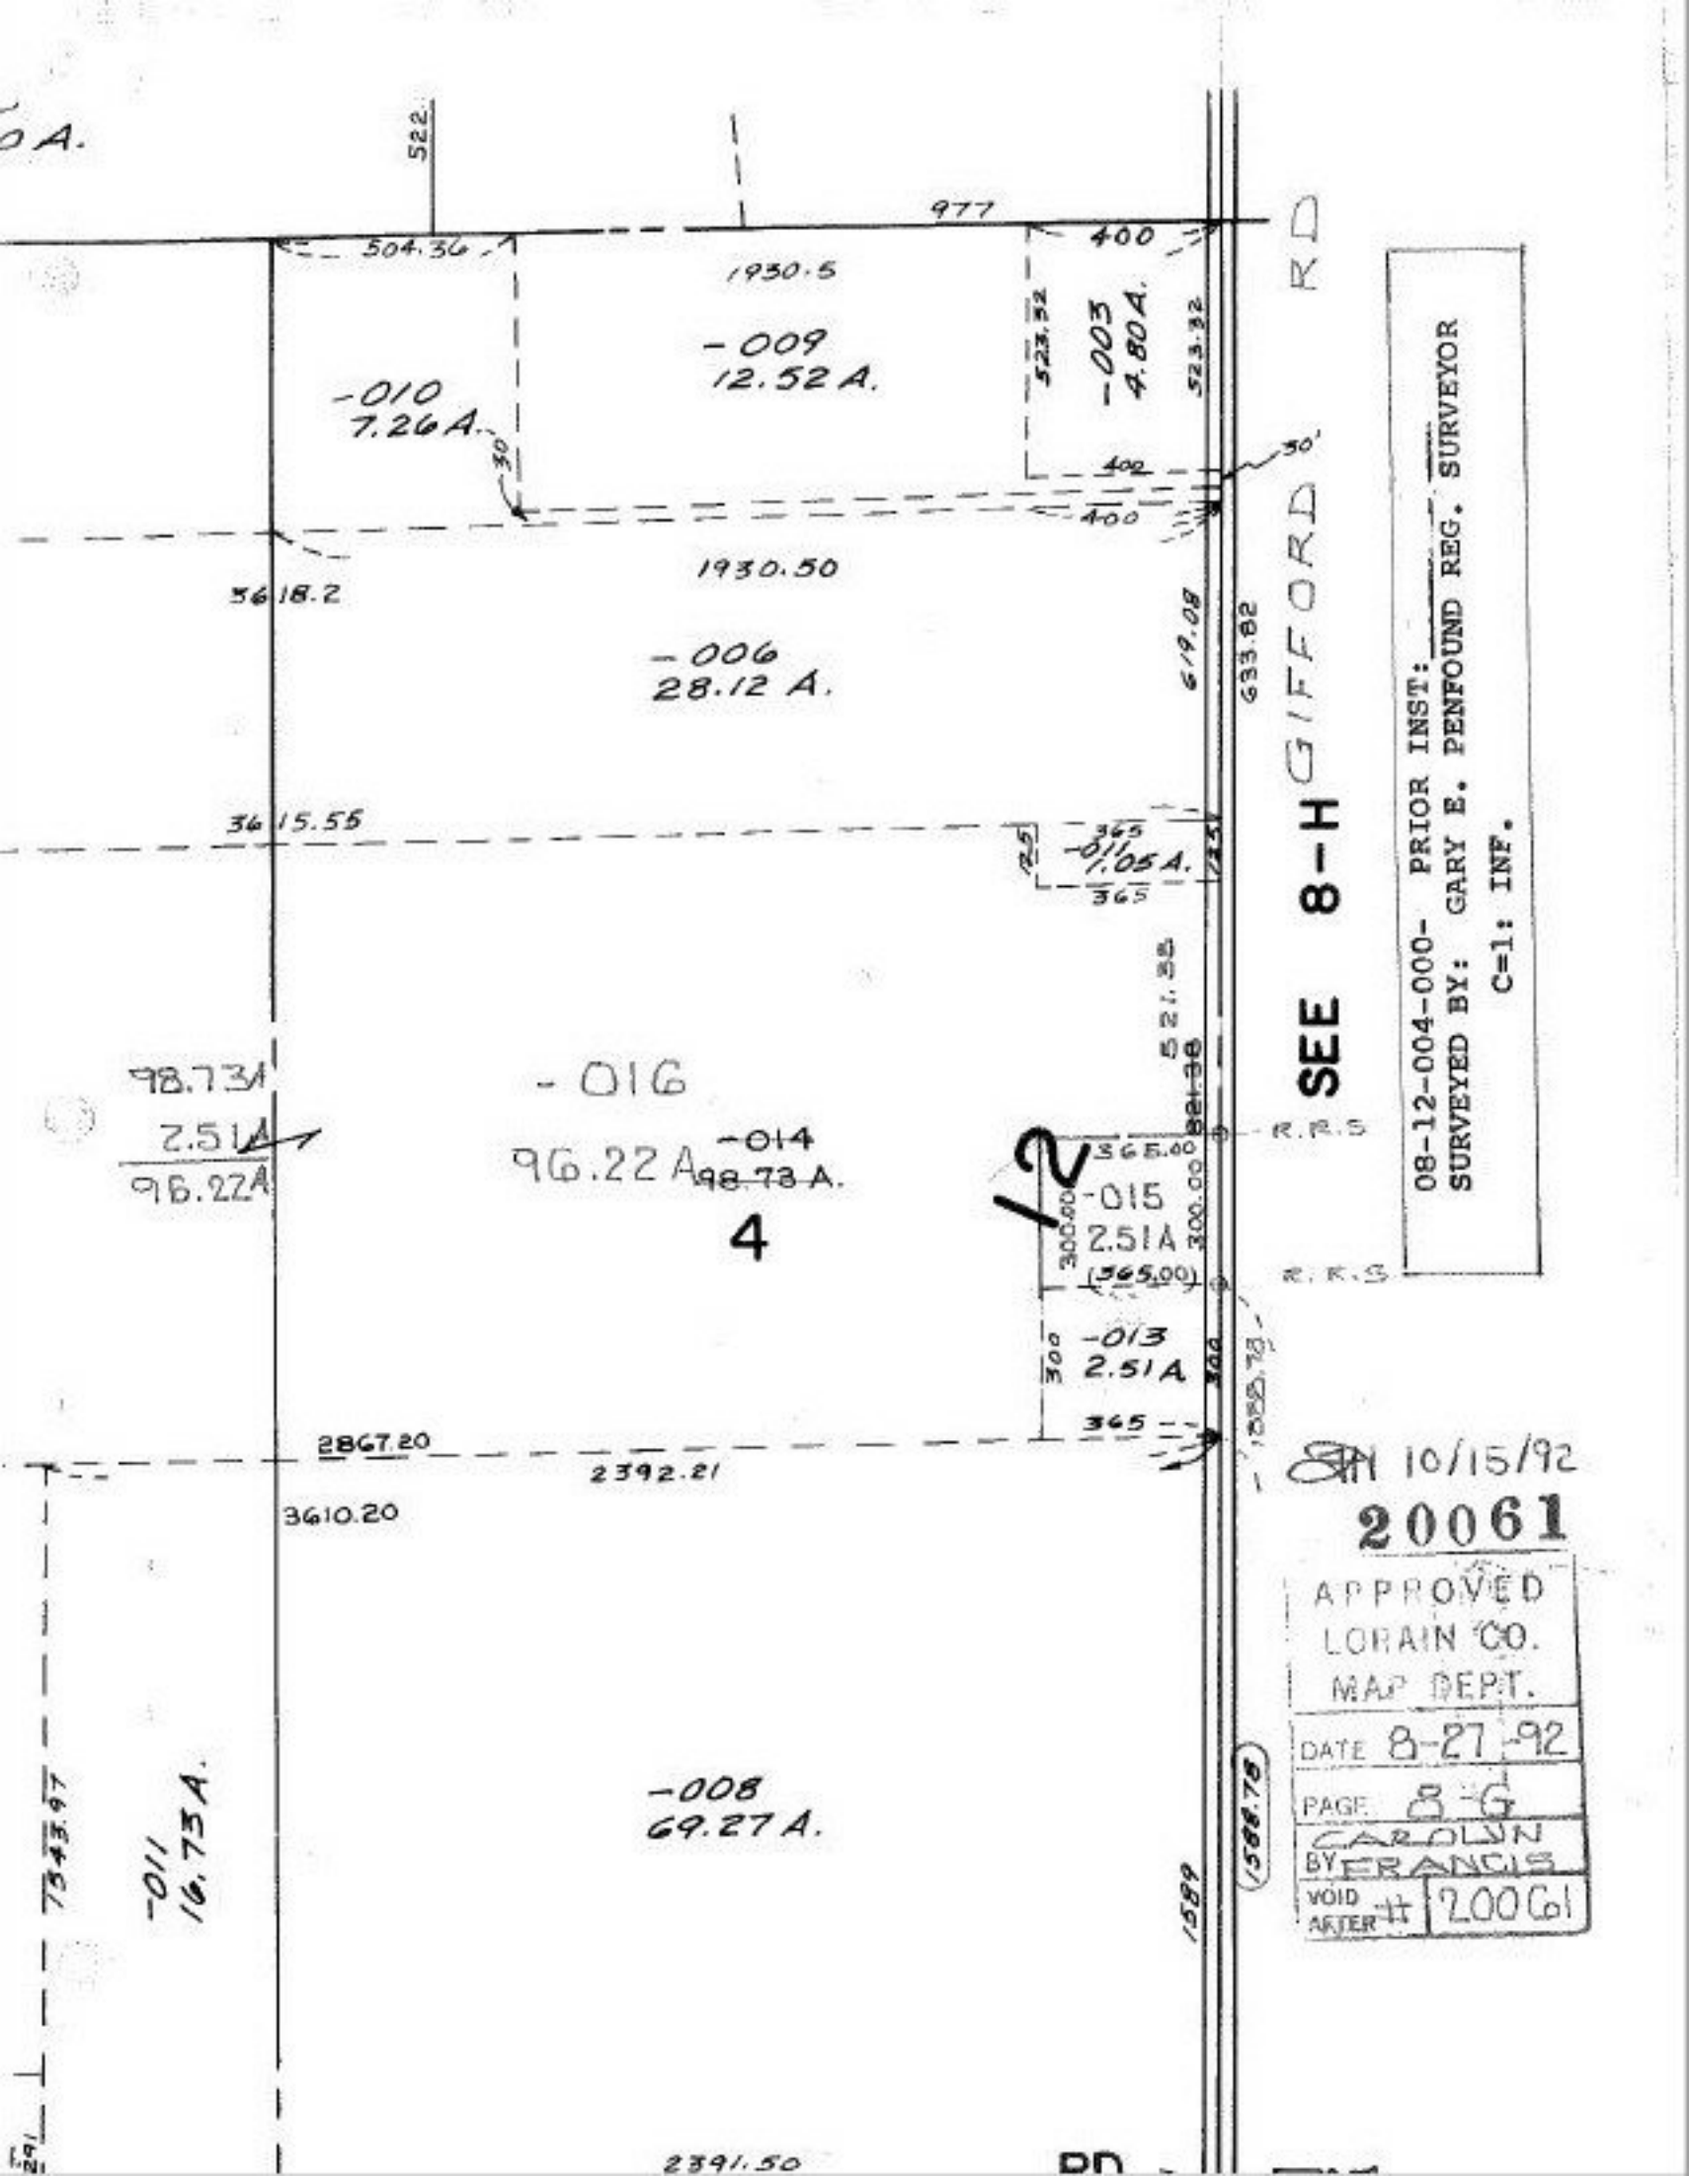
0 A.
522.
977
504.36
1930.5
400
-009
12.52 A.
-010
7.26 A.
-003
4.80 A.
523.32
523.32
30'
402
400
1930.50
3618.2
-006
28.12 A.
619.08
633.82
GIFFORD RD
SEE 8-H
3615.55
125
-011
1.05 A.
365
365
521.35
98.731
2.51A
96.22A
-016
96.22A
-014
98.73 A.
4
12
365.00
-015
2.51A
(365.00)
300.00
300.00
R.R.S
R.R.S
300
-013
2.51A
365
1588.78
2867.20
2392.21
3610.20
-011
16.73A.
-008
69.27 A.
7343.97
1589
2391.50
08-12-004-000- PRIOR INST:
SURVEYED BY: GARY E. PENFOUND REG. SURVEYOR
C=1: INF.
10/15/92
20061
APPROVED
LORAIN CO.
MAP DEPT.
DATE 8-27-92
PAGE 8-G
BY CAROLYN FRANCIS
VOID AFTER 11 20061