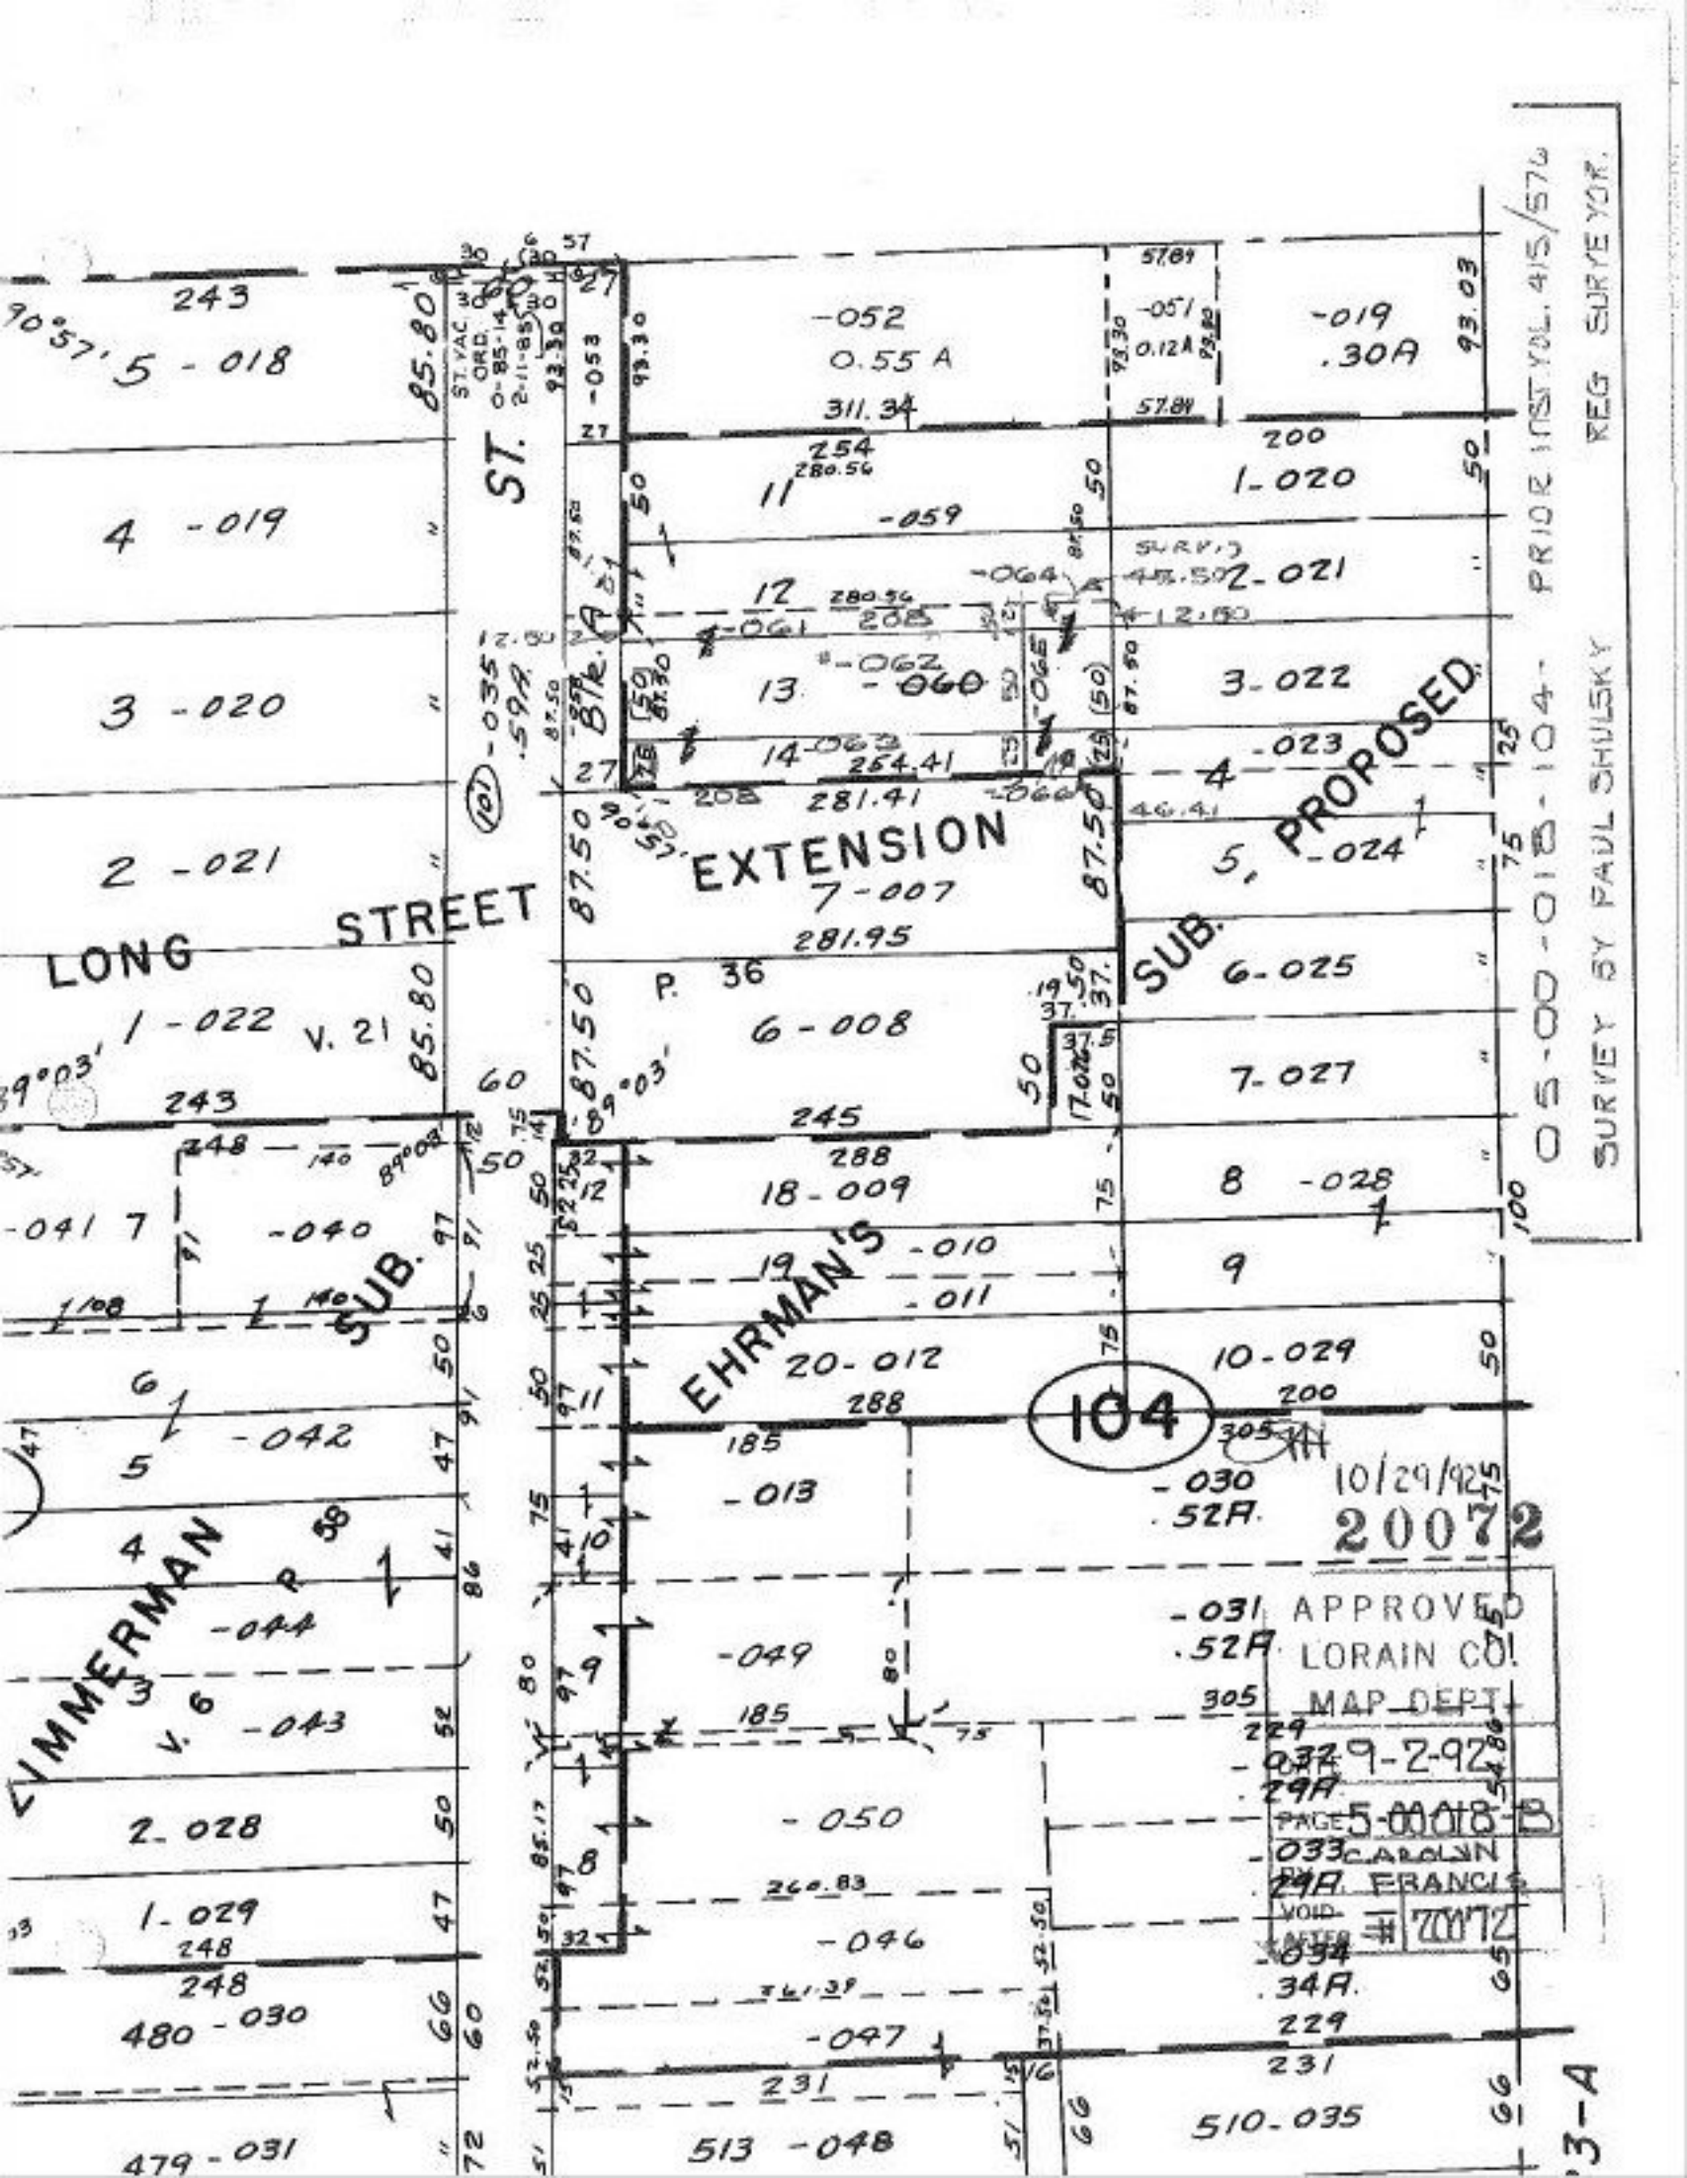

LONG STREET EXTENSION
ST.
SUB. PROPOSED
EHRMAN'S SUB.
ZIMMERMAN SUB.
104
05-00-018-104-
PRIOR INST. VOL. 415/576
SURVEY BY PAUL SHULSKY
REG SURVEYOR.
10/29/92
20072
APPROVED
LORAIN CO.
MAP DEPT.
9-2-92
5-00018-B
CAROLYN
FRANCIS
#20072