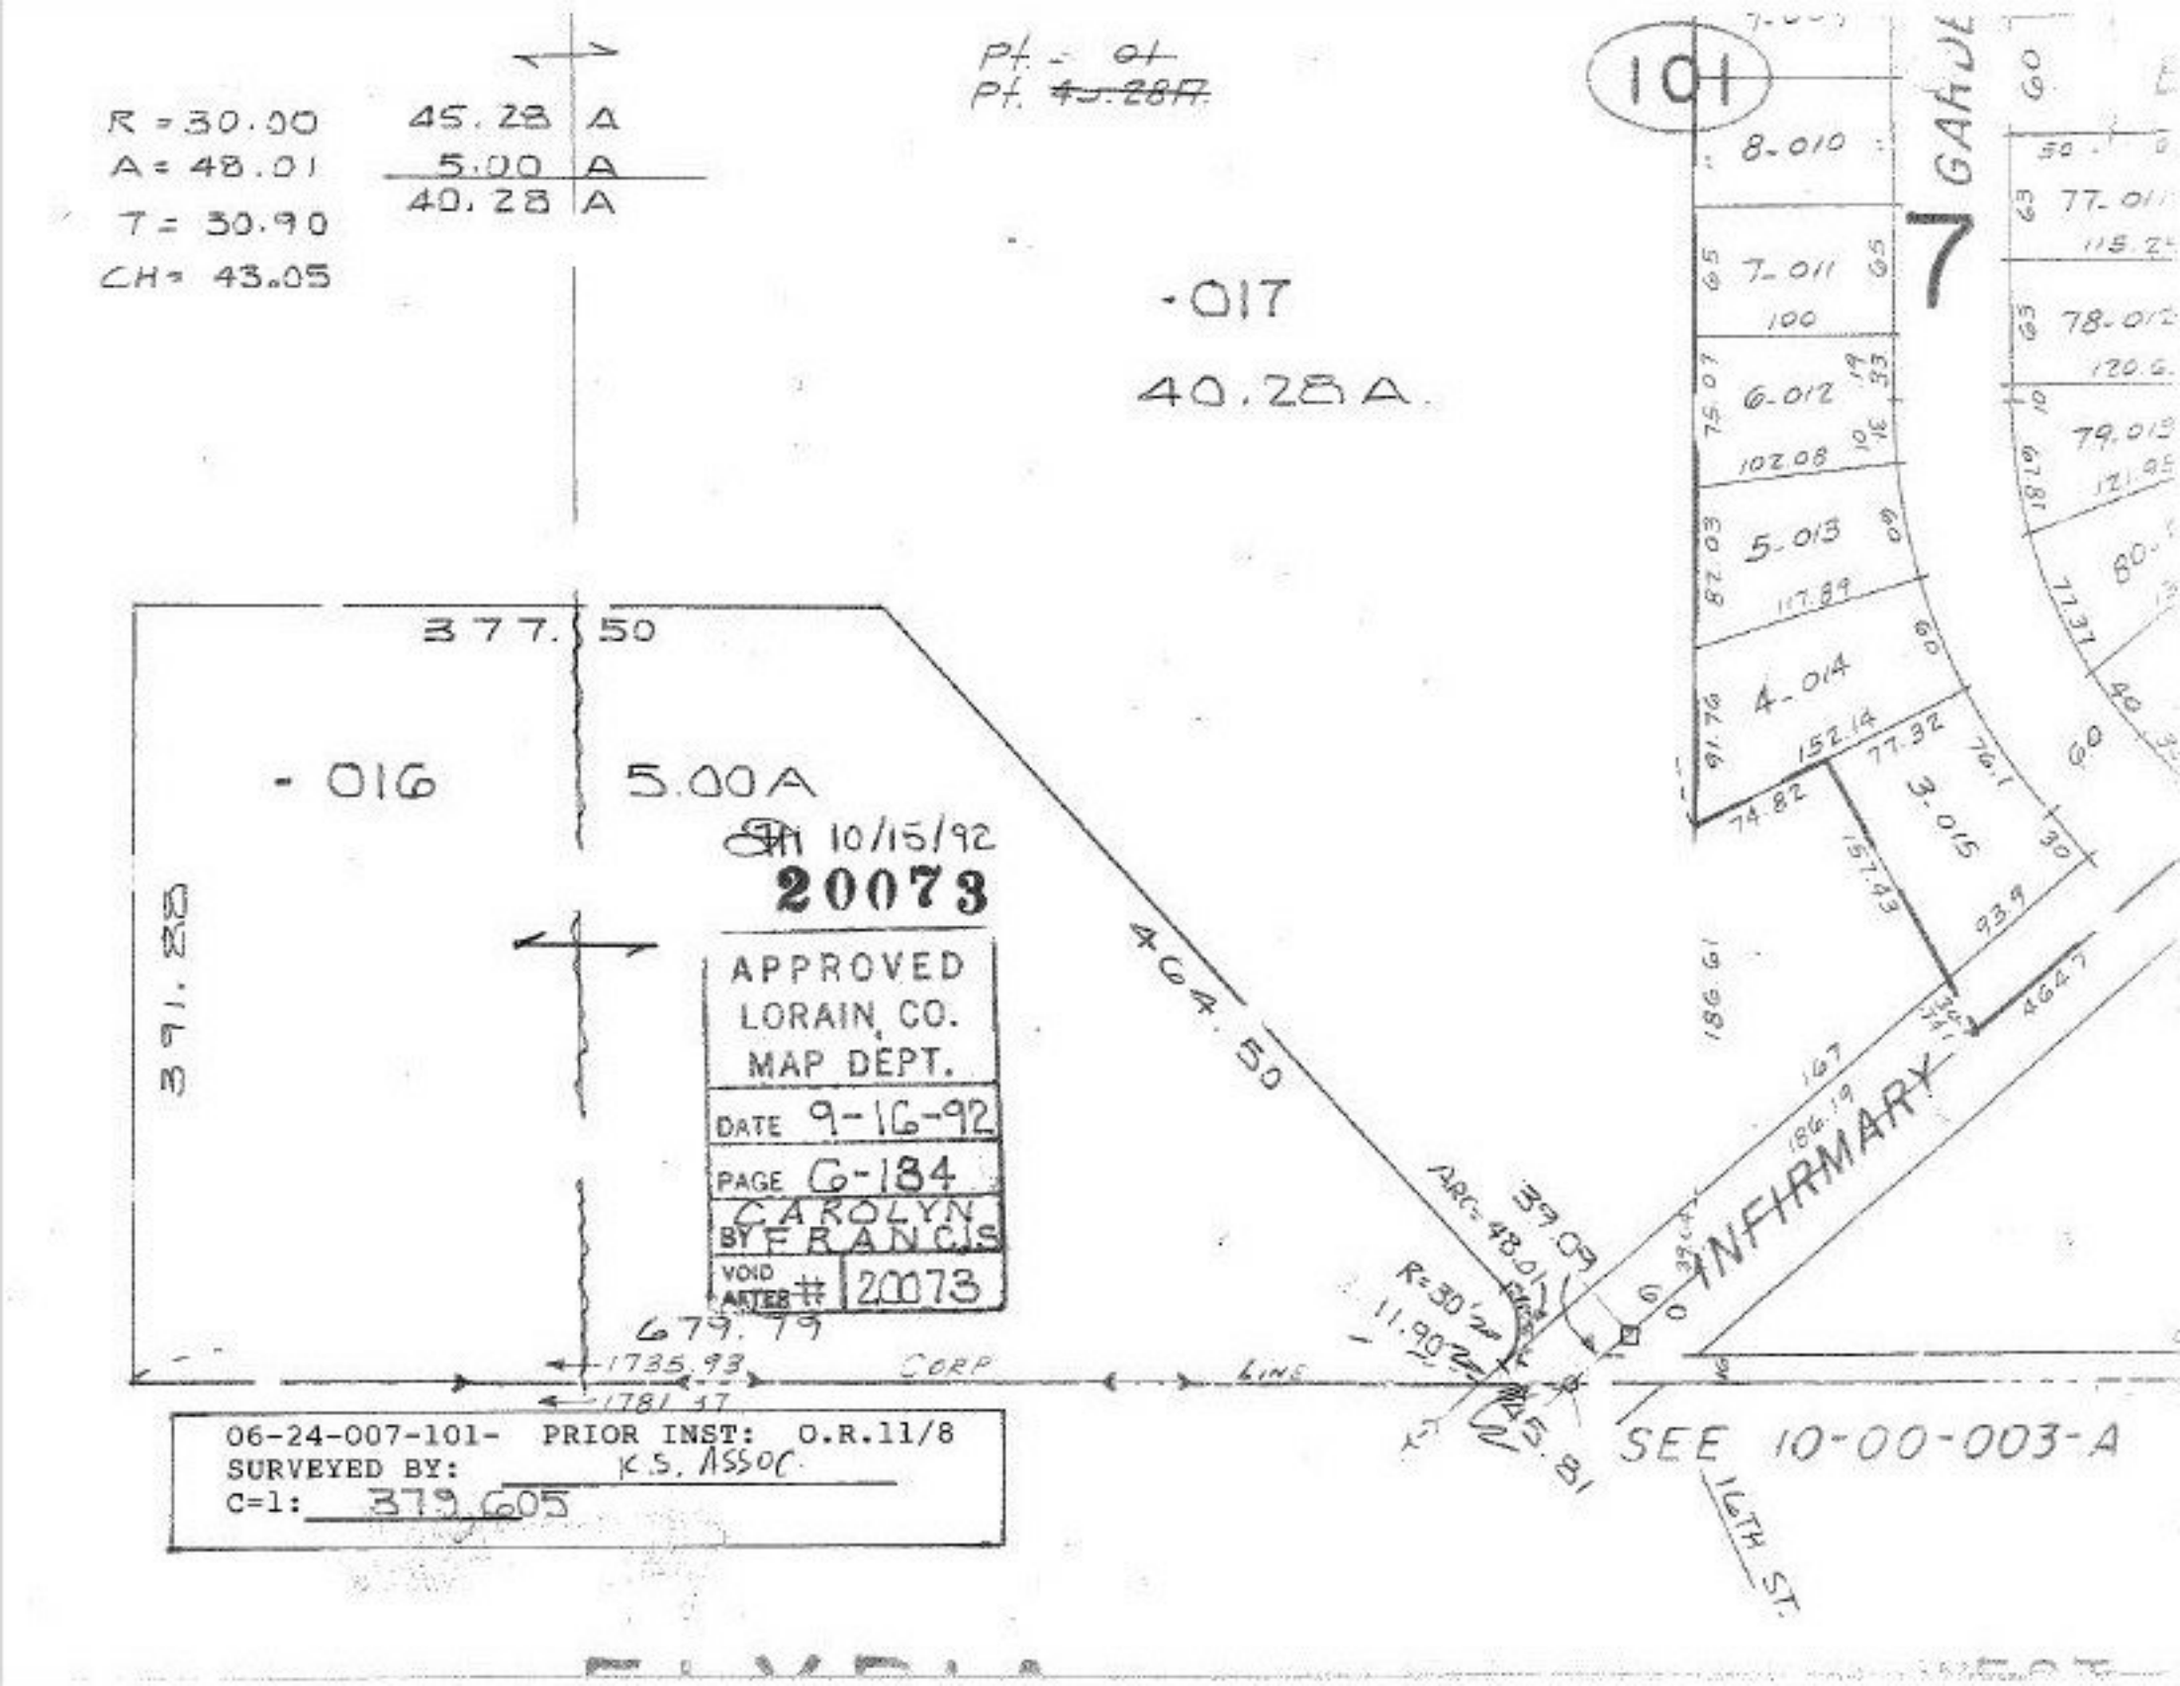
R = 30.00
A = 48.01
T = 30.90
CH = 43.05
45.28 A
5.00 A
40.28 A
Pt. - 01
Pt. 45.28A
-017
40.28A.
101
8.010
7.011
100
6.012
102.08
5.013
117.89
4.014
152.14
3.015
77.32
74.82
157.43
93.9
186.61
464.7
167
186.19
77.011
78.012
79.013
120.6
115.2
121.95
72.31
60
-016
5.00A
377.50
391.25
404.50
10/15/92
20073
APPROVED
LORAIN, CO.
MAP DEPT.
DATE 9-16-92
PAGE G-184
CAROLYN
BY FRANCIS
VOID AFTER # 20073
679.79
1735.93
781.37
CORP
LINE
39.09
ARC = 48.01
R = 30'
11.90
45.81
INFIRMARY
SEE 10-00-003-A
16TH ST.
06-24-007-101- PRIOR INST: O.R.11/8
SURVEYED BY: K.S. ASSOC
C=1: 379.605