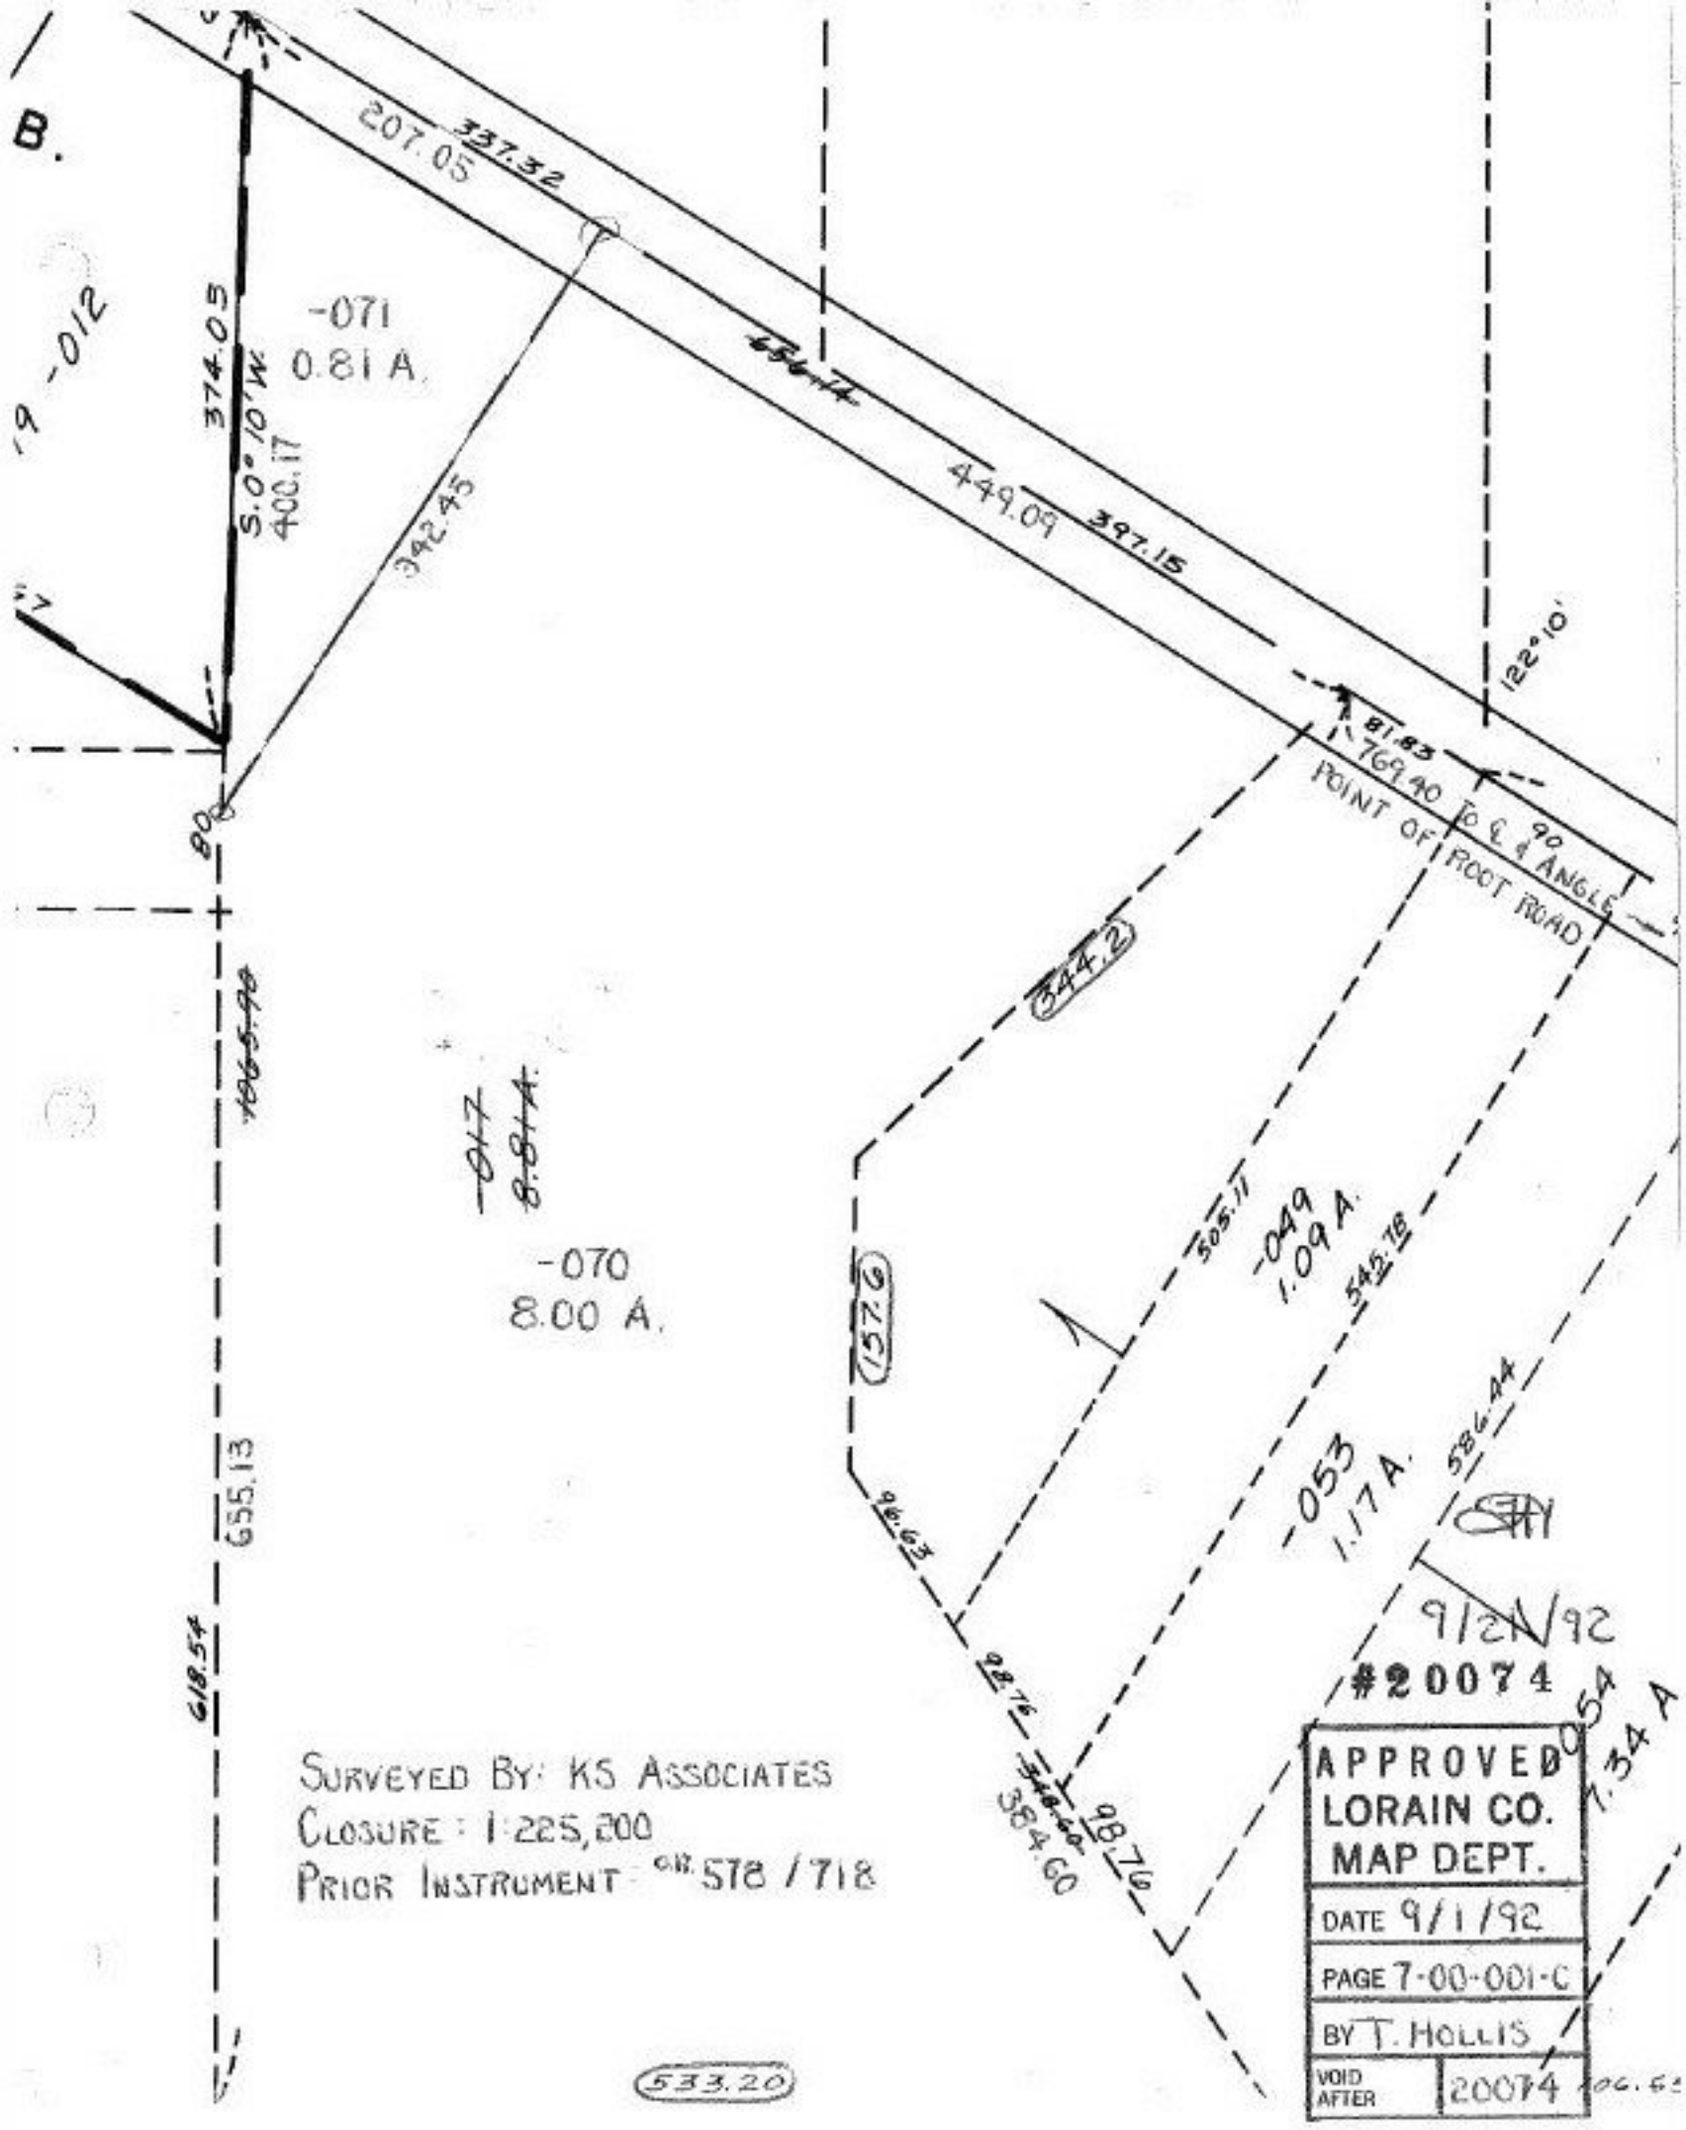

SURVEYED BY: KS ASSOCIATES
CLOSURE: 1:225,200
PRIOR INSTRUMENT OR 578 / 718