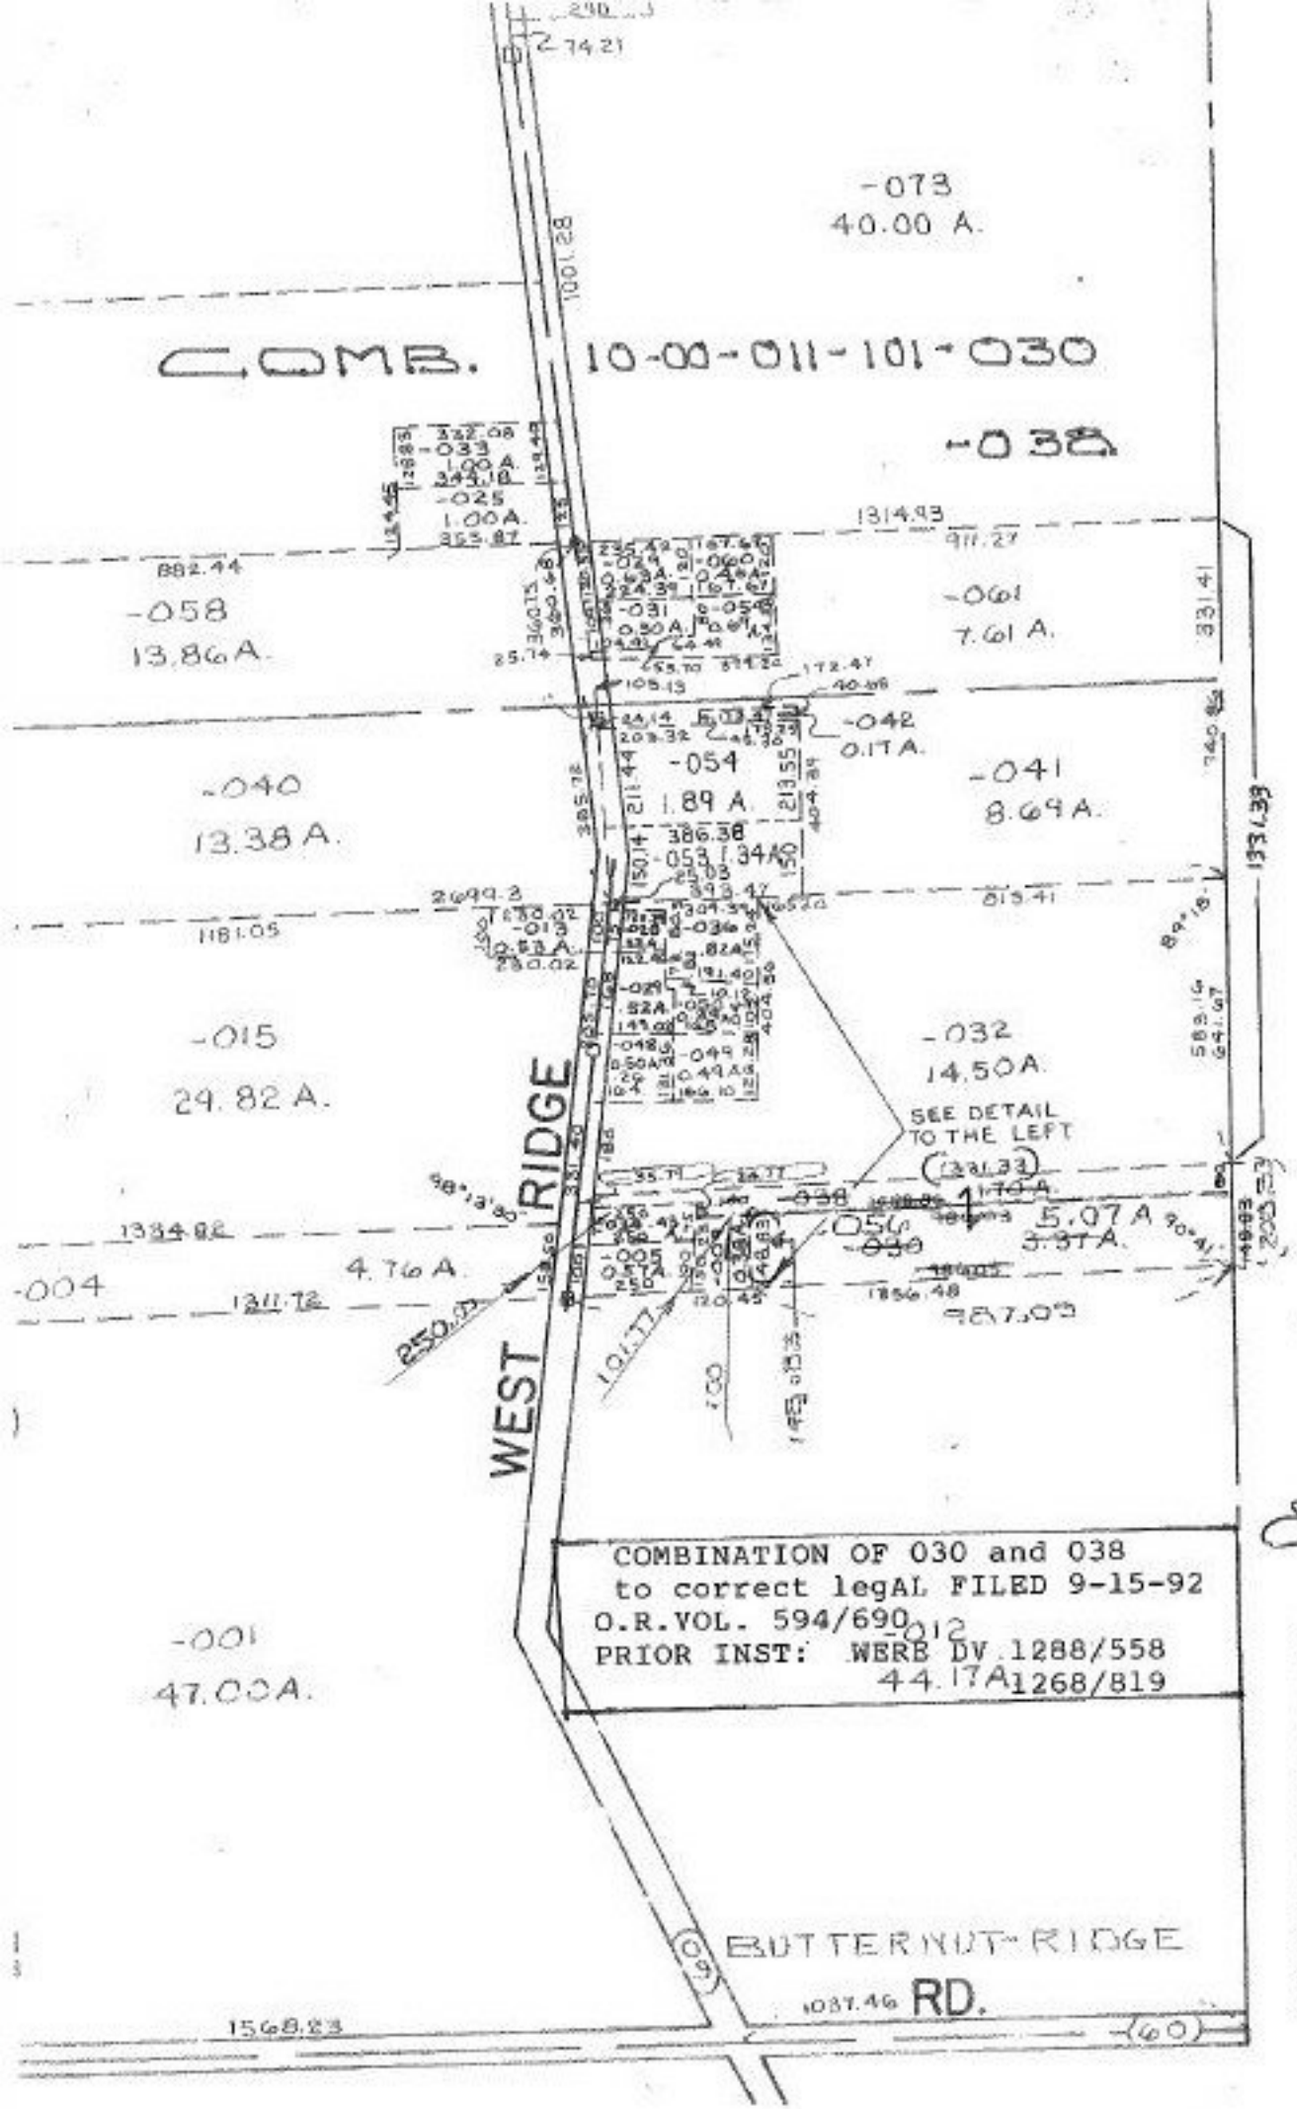

COMB.

COMBINATION OF 030 and 038
to correct legAL FILED 9-15-92
O.R.VOL. 594/690
PRIOR INST: WERE DV 1288/558
44.17A 1268/819

10/29/92

#20077

APPROVED
LORAIN CO.
MAP DEPT.
DATE 9-28-92
PAGE 10-A
BY CAROLYN FRANCIS
VOID AFTER # 20077