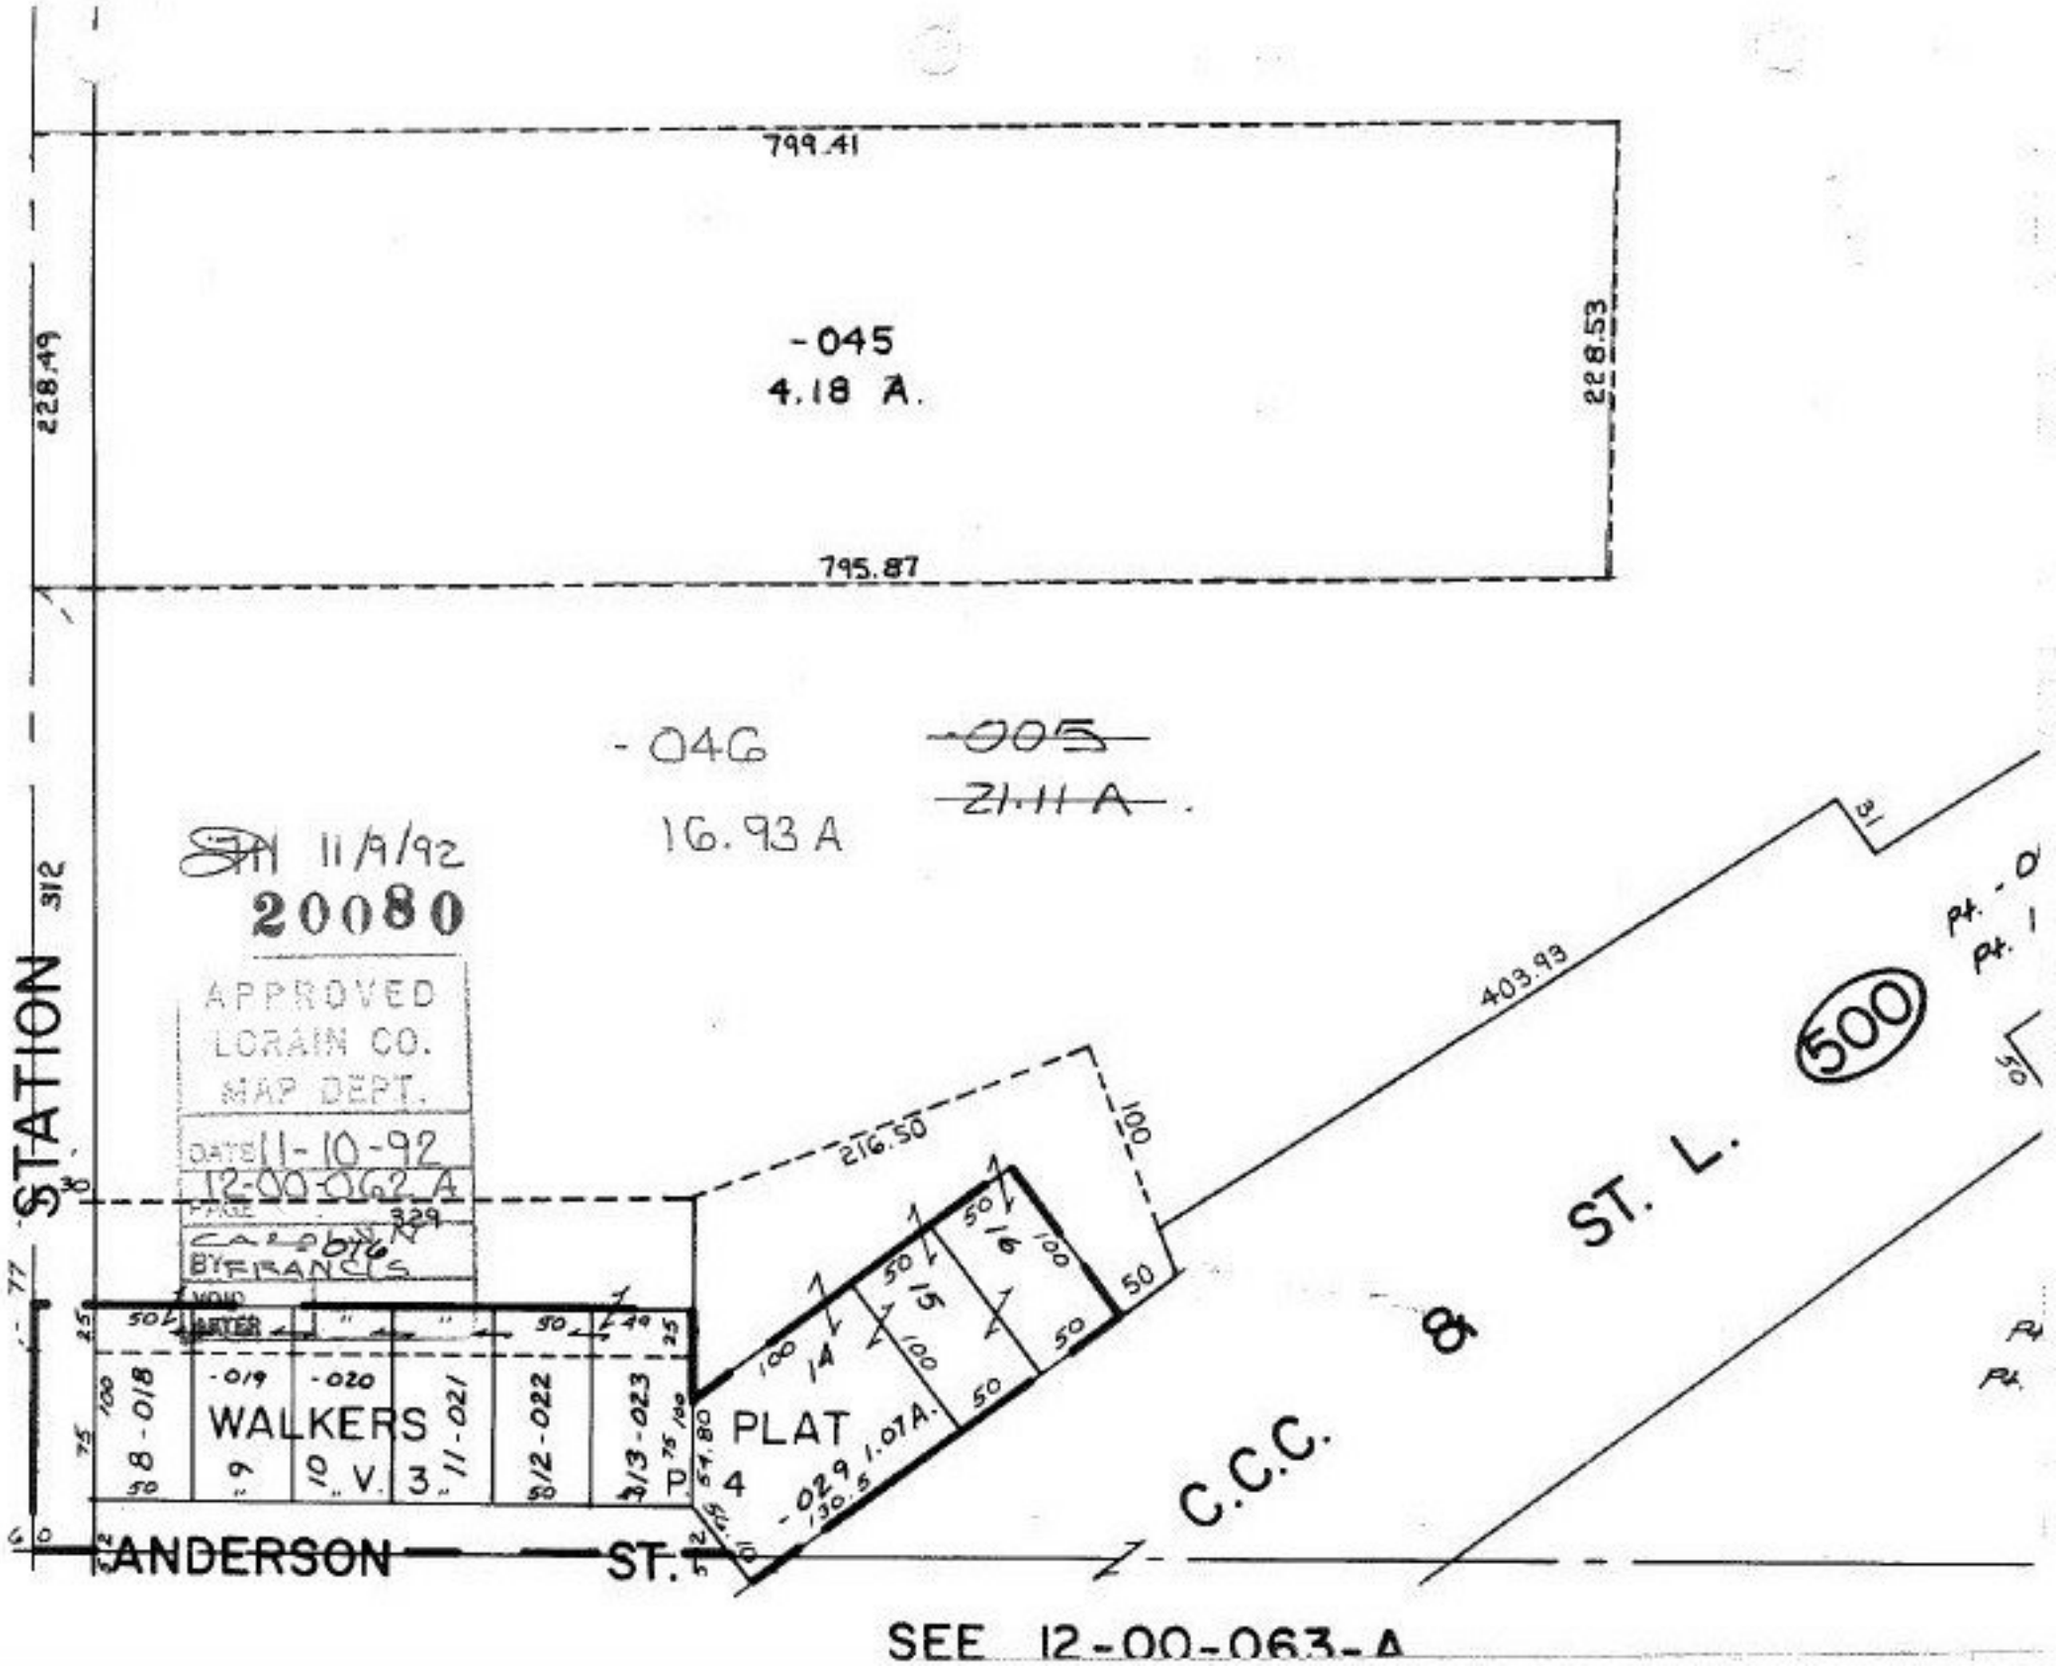
799.41
228.49
228.53
-045
4.18 A.
795.87
-046
16.93 A
-005
21.11 A.
11/9/92
20080
APPROVED
LORAIN CO.
MAP DEPT.
DATE 11-10-92
12-00-062.A
PAGE 329
CARBON
BY FRANCES
VOID
WATER
312
STATION
403.93
216.50
100
50
50
50
50
50
50
50
50
50
50
50
100
100
100