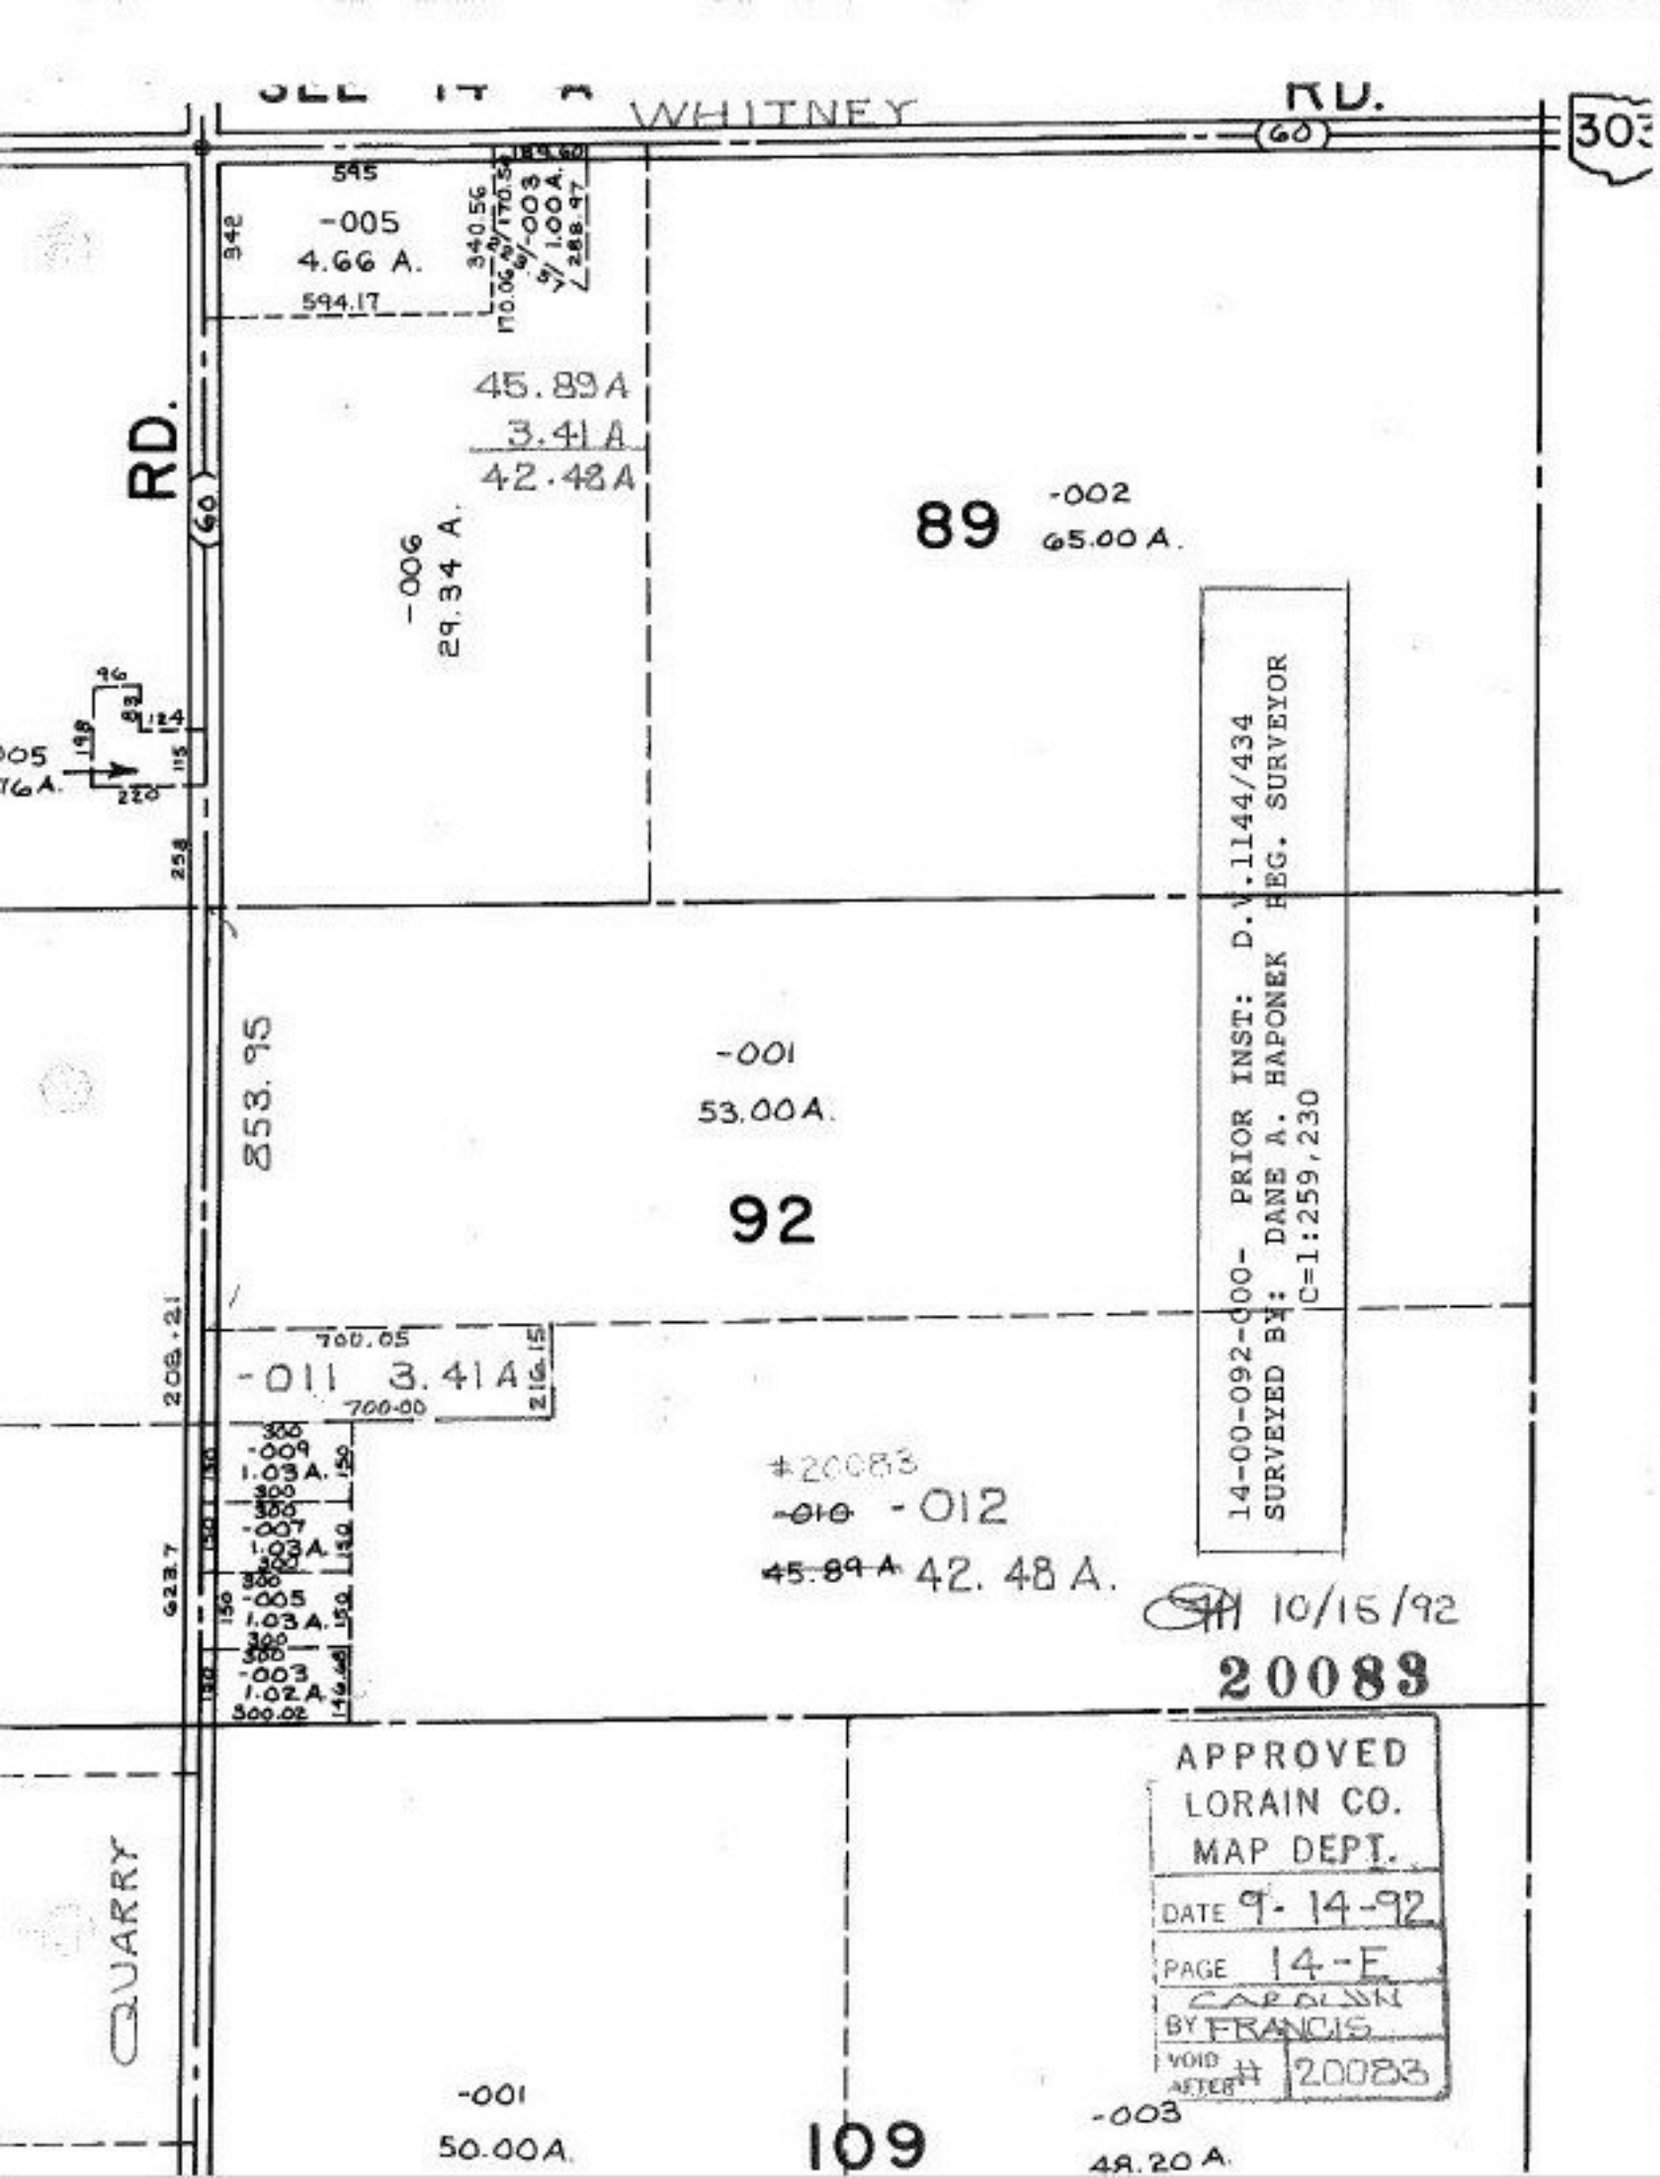
WHITNEY RD.
60
303
RD.
60
595
-005
4.66 A.
342
594.17
340.56
170.06
189.60
170.53
-003
1.00 A.
288.97
45.89 A
3.41 A
42.48 A
-006
29.34 A.
89
-002
65.00 A.
14-00-092-000- PRIOR INST: D.V.1144/434
SURVEYED BY: DANE A. HAPONEK REG. SURVEYOR
C=1:259,230
853.95
-001
53.00 A.
92
208.21
700.05
-011 3.41 A
700.00
216.15
623.7
-009
1.03 A.
-007
1.03 A.
-005
1.03 A.
-003
1.02 A.
300.02
#20083
-010 -012
45.89 A 42.48 A.
10/15/92
20089
APPROVED
LORAIN CO.
MAP DEPT.
DATE 9-14-92
PAGE 14-E
BY FRANCIS CARLSON
VOID AFTER # 20083
QUARRY
-001
50.00 A.
109
-003
48.20 A.