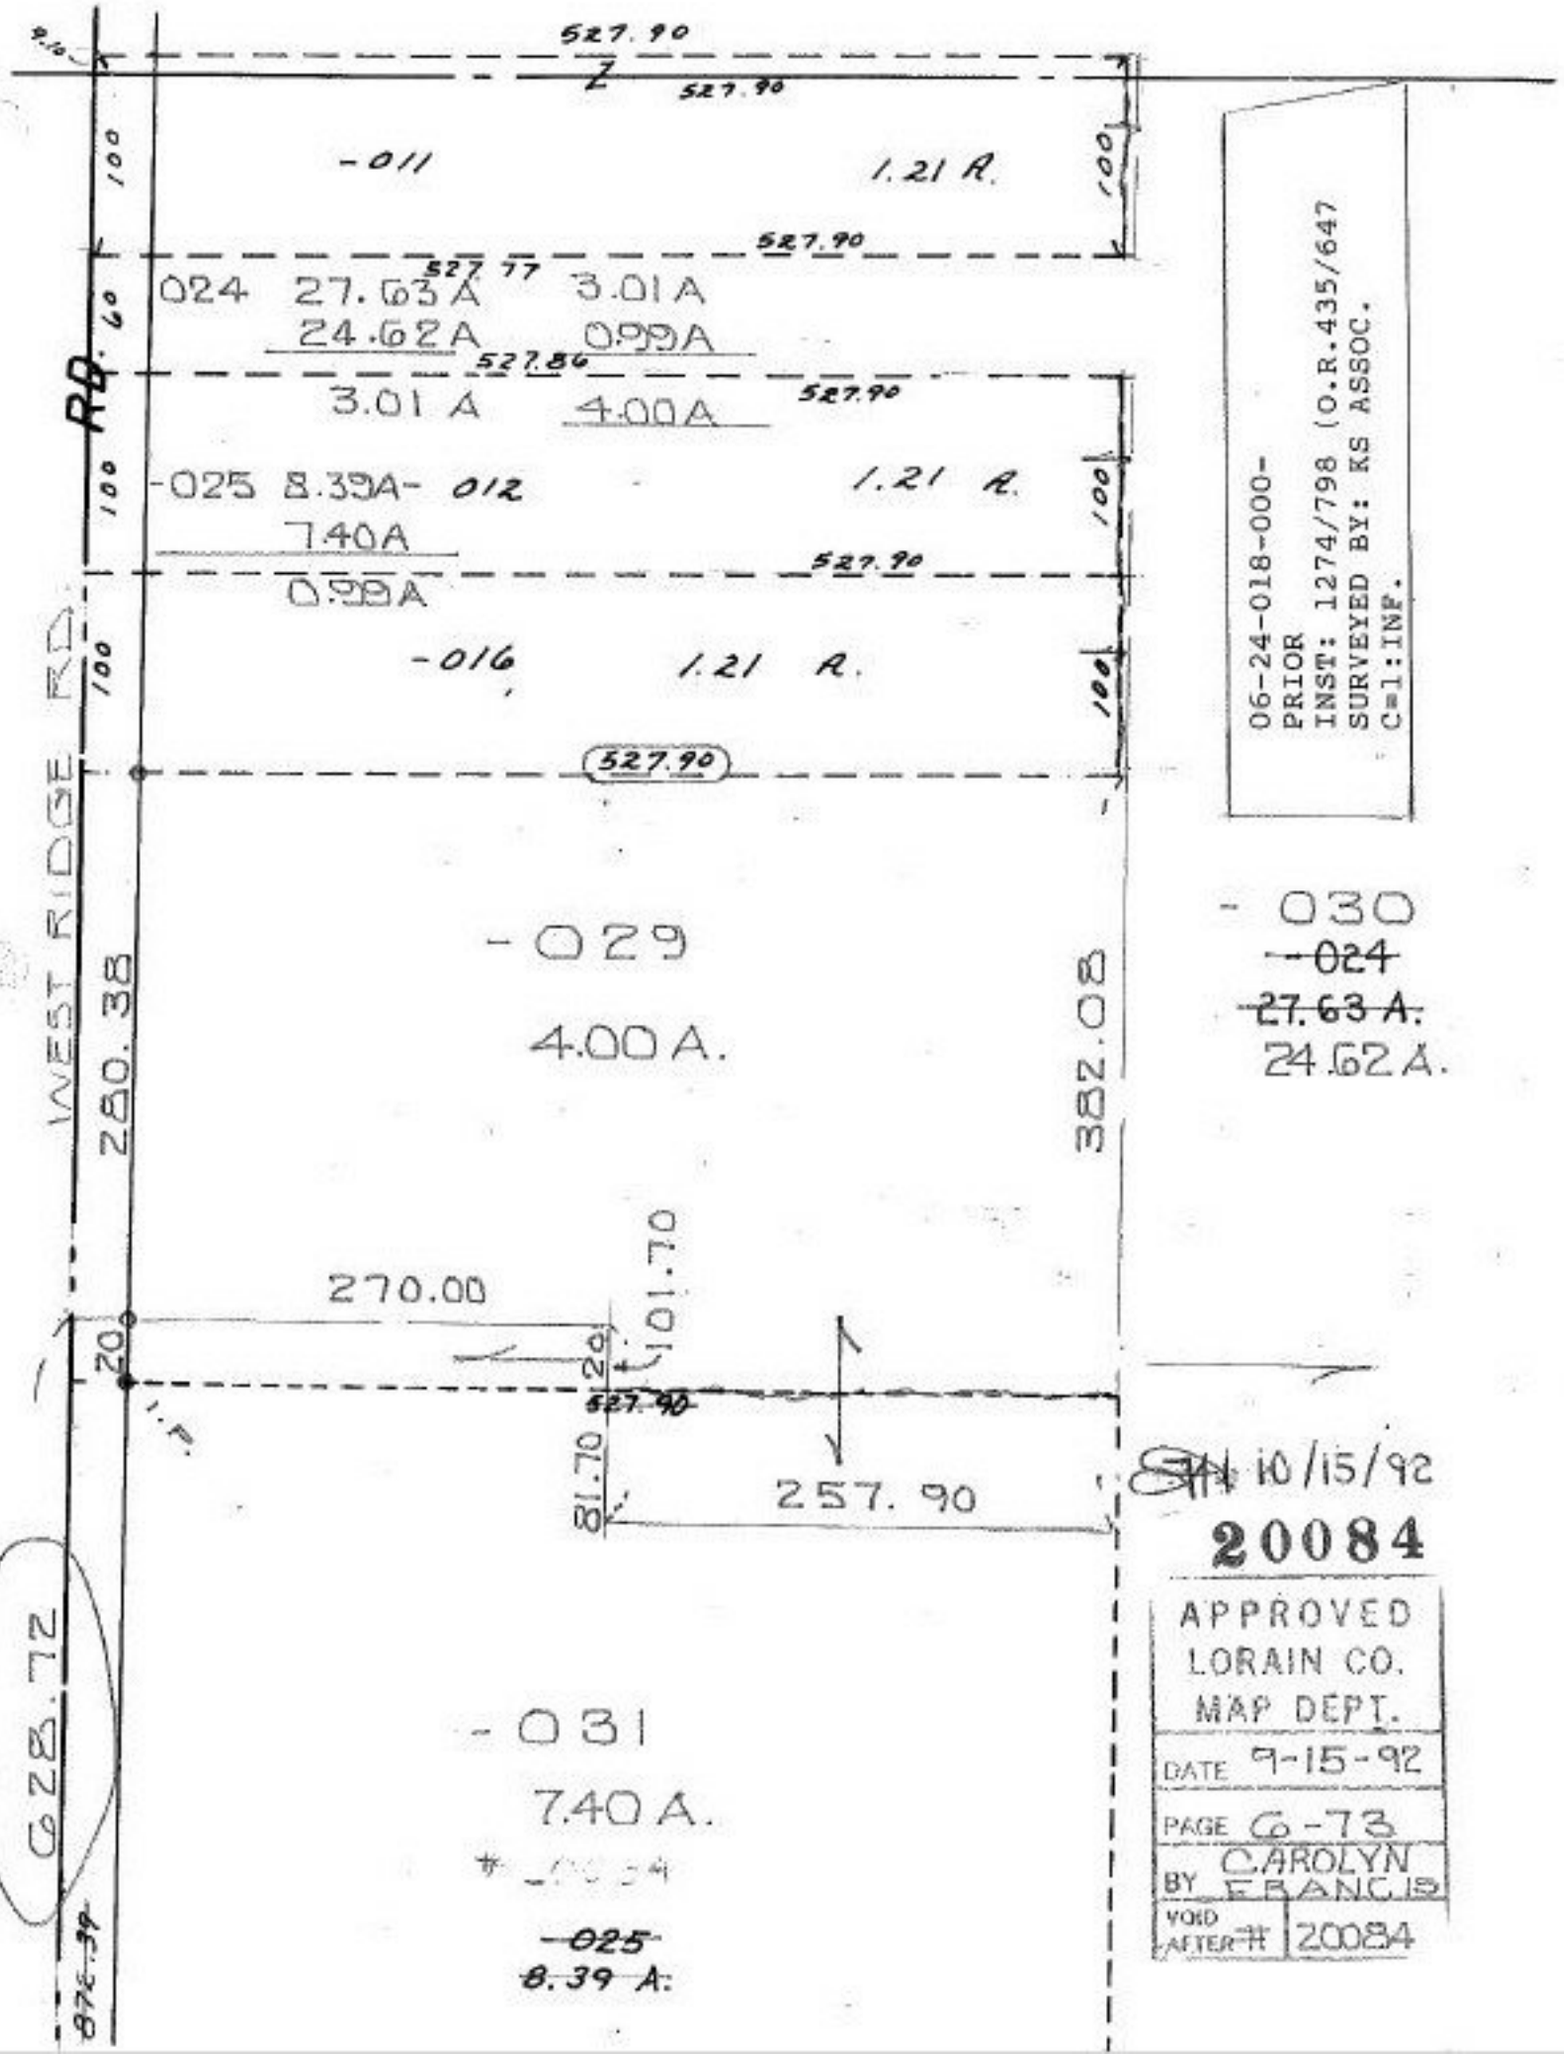
527.90
527.90
-011
1.21 R.
100
527.90
024 27.63A 527.77 3.01A
24.62A 0.99A
527.86
3.01A 4.00A 527.90
-025 8.39A- 012
1.21 R.
7.40A
527.90
0.99A
-016
1.21 R.
527.90
RD. 60
100
WEST RIDGE RD.
280.38
-029
4.00A.
382.08
06-24-018-000-
PRIOR
INST: 1274/798 (O.R.435/647
SURVEYED BY: KS ASSOC.
C=1:INF.
-030
-024
27.63 A.
24.62A.
270.00
20
101.70
20
527.90
81.70
257.90
628.72
-031
7.40A.
-025
8.39 A:
10/15/92
20084
APPROVED
LORAIN CO.
MAP DEPT.
DATE 9-15-92
PAGE 6-73
BY CAROLYN FRANCIS
VOID AFTER # 20084