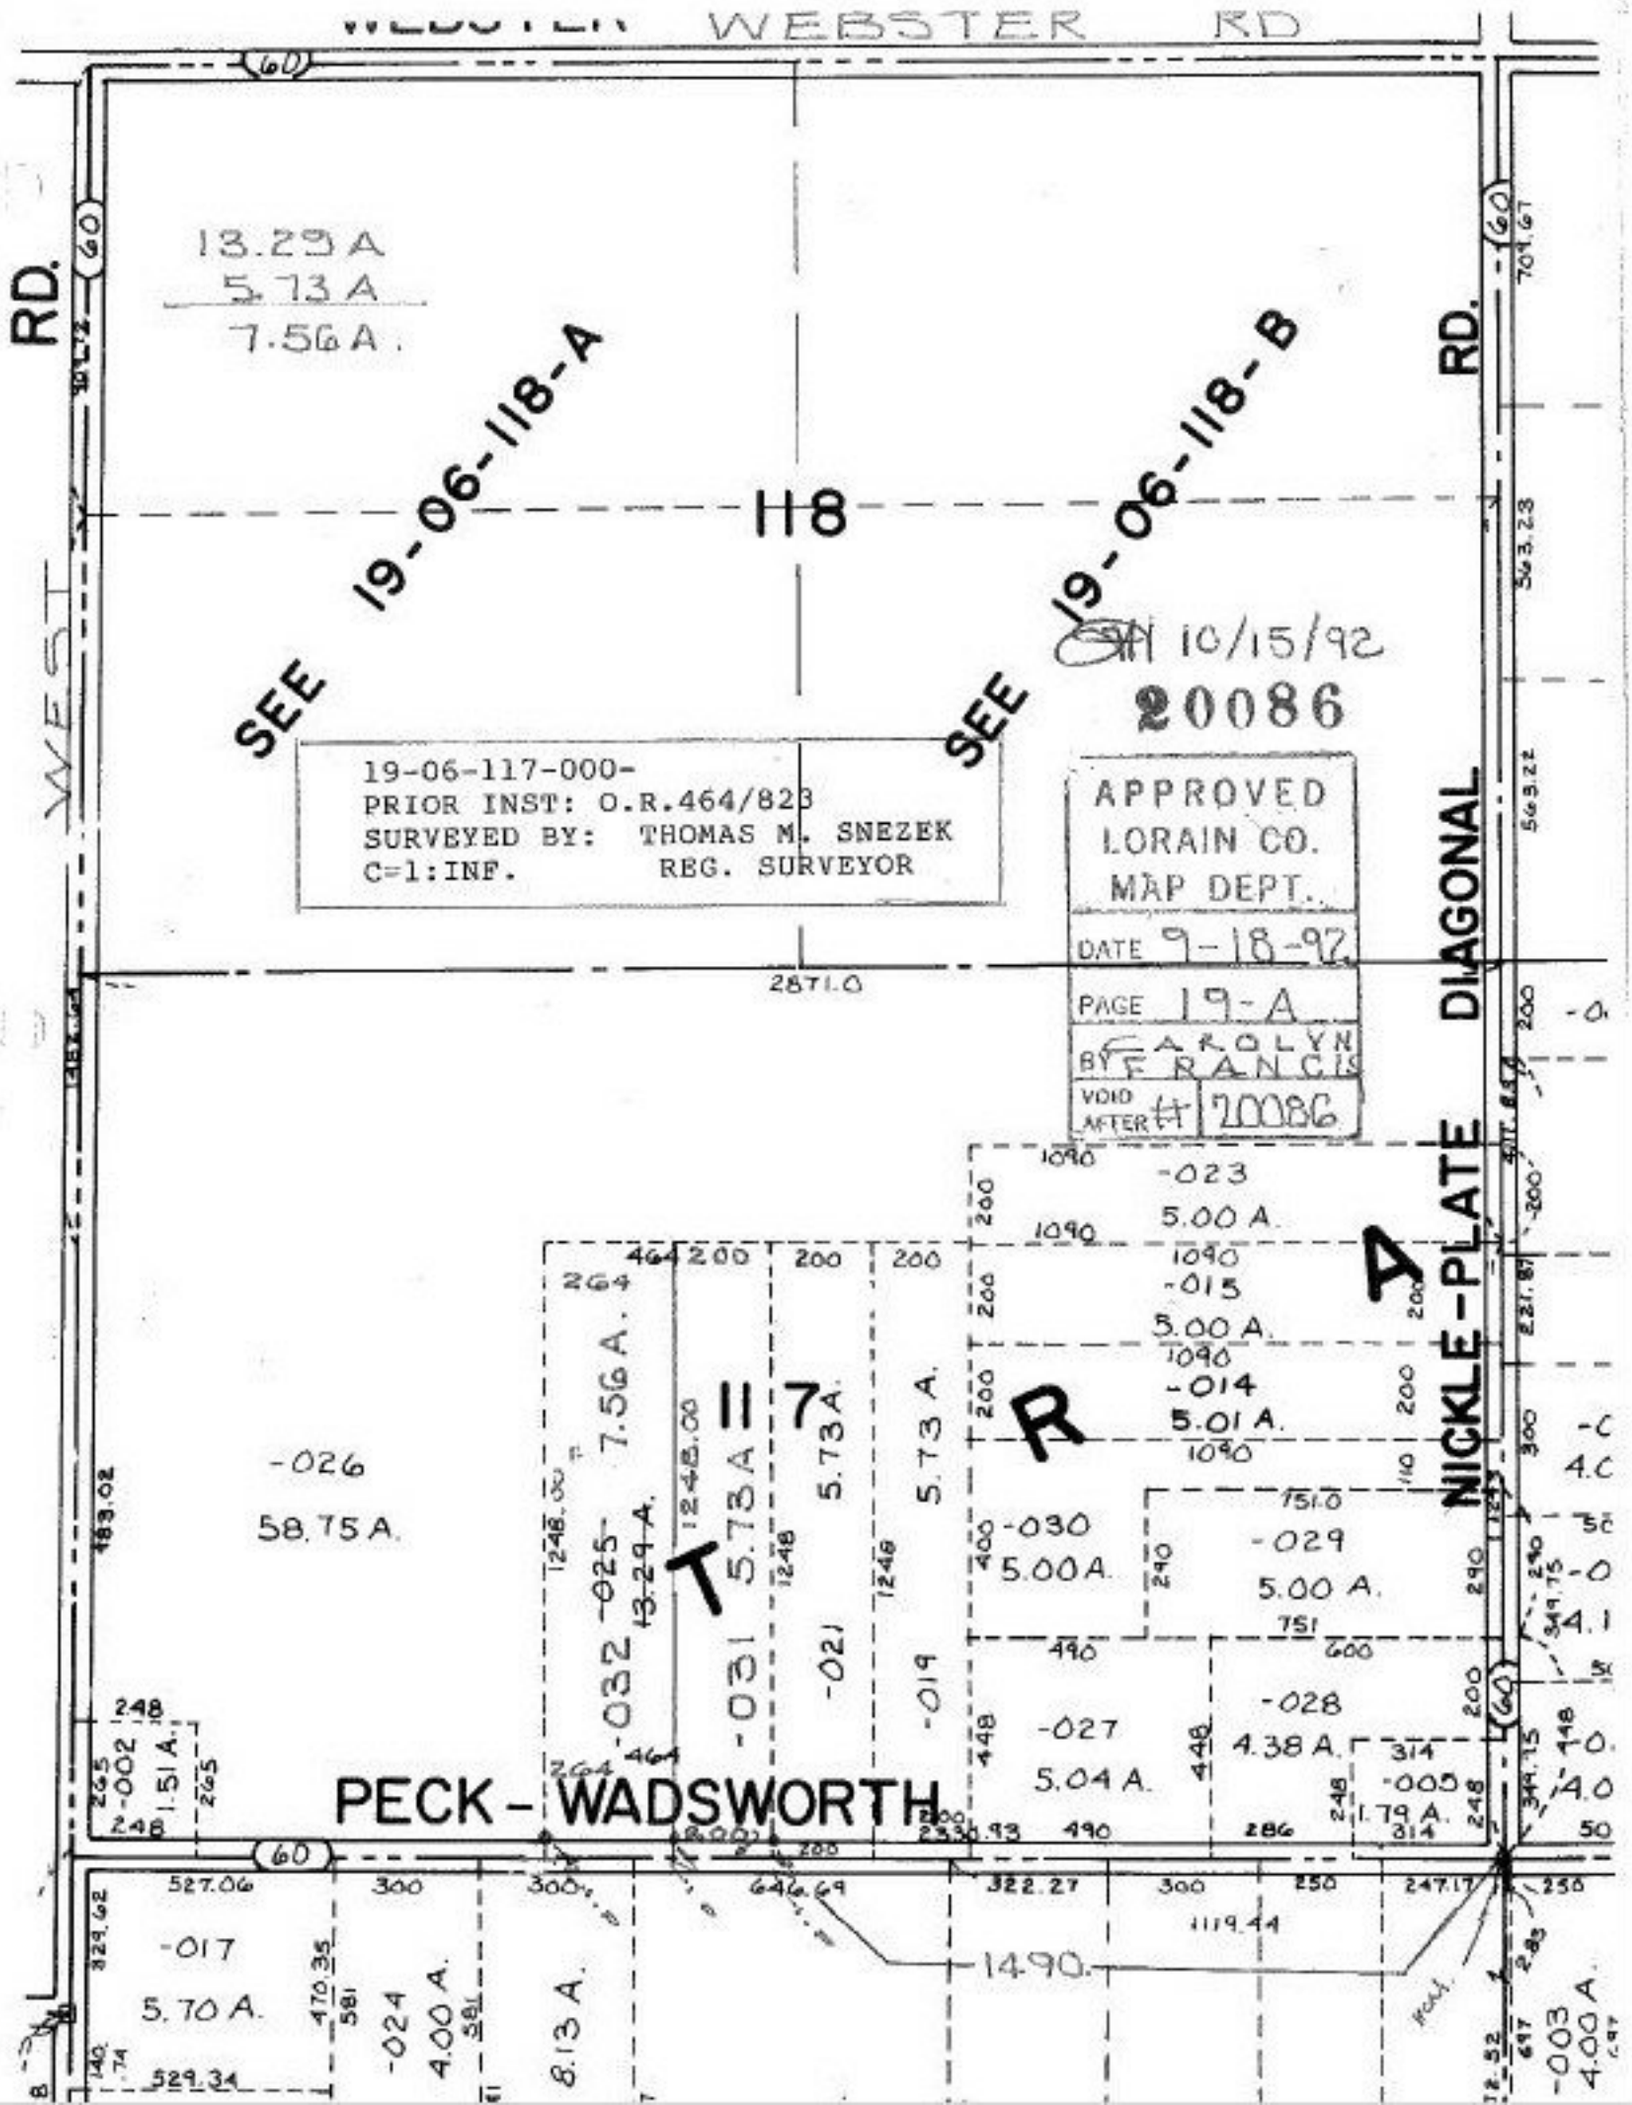
WEBSTER RD
WEST RD.
DIAGONAL RD.
NICKLE-PLATE
PECK - WADSWORTH
13.29 A
5.73 A
7.56 A.
SEE 19-06-118-A
SEE 19-06-118-B
118
T 11 7
R 4
10/15/92
20086
19-06-117-000-
PRIOR INST: O.R.464/823
SURVEYED BY: THOMAS M. SNEZEK
C=1:INF. REG. SURVEYOR
APPROVED
LORAIN CO.
MAP DEPT.
DATE 9-18-92
PAGE 19-A
BY CAROLYN FRANCIS
VOID AFTER 11 20086
-023 5.00 A.
-015 5.00 A.
-014 5.01 A.
-030 5.00A.
-029 5.00 A.
-028 4.38 A.
-027 5.04 A.
-005 1.79 A.
-026 58.75 A.
-025 13.29 A.
-032 7.56 A.
-031 5.73 A.
-021 5.73 A.
-019 5.73 A.
-002 1.51 A.
-017 5.70 A.
-024 4.00 A.
8.13 A.
-003 4.00 A.
2871.0
1490.