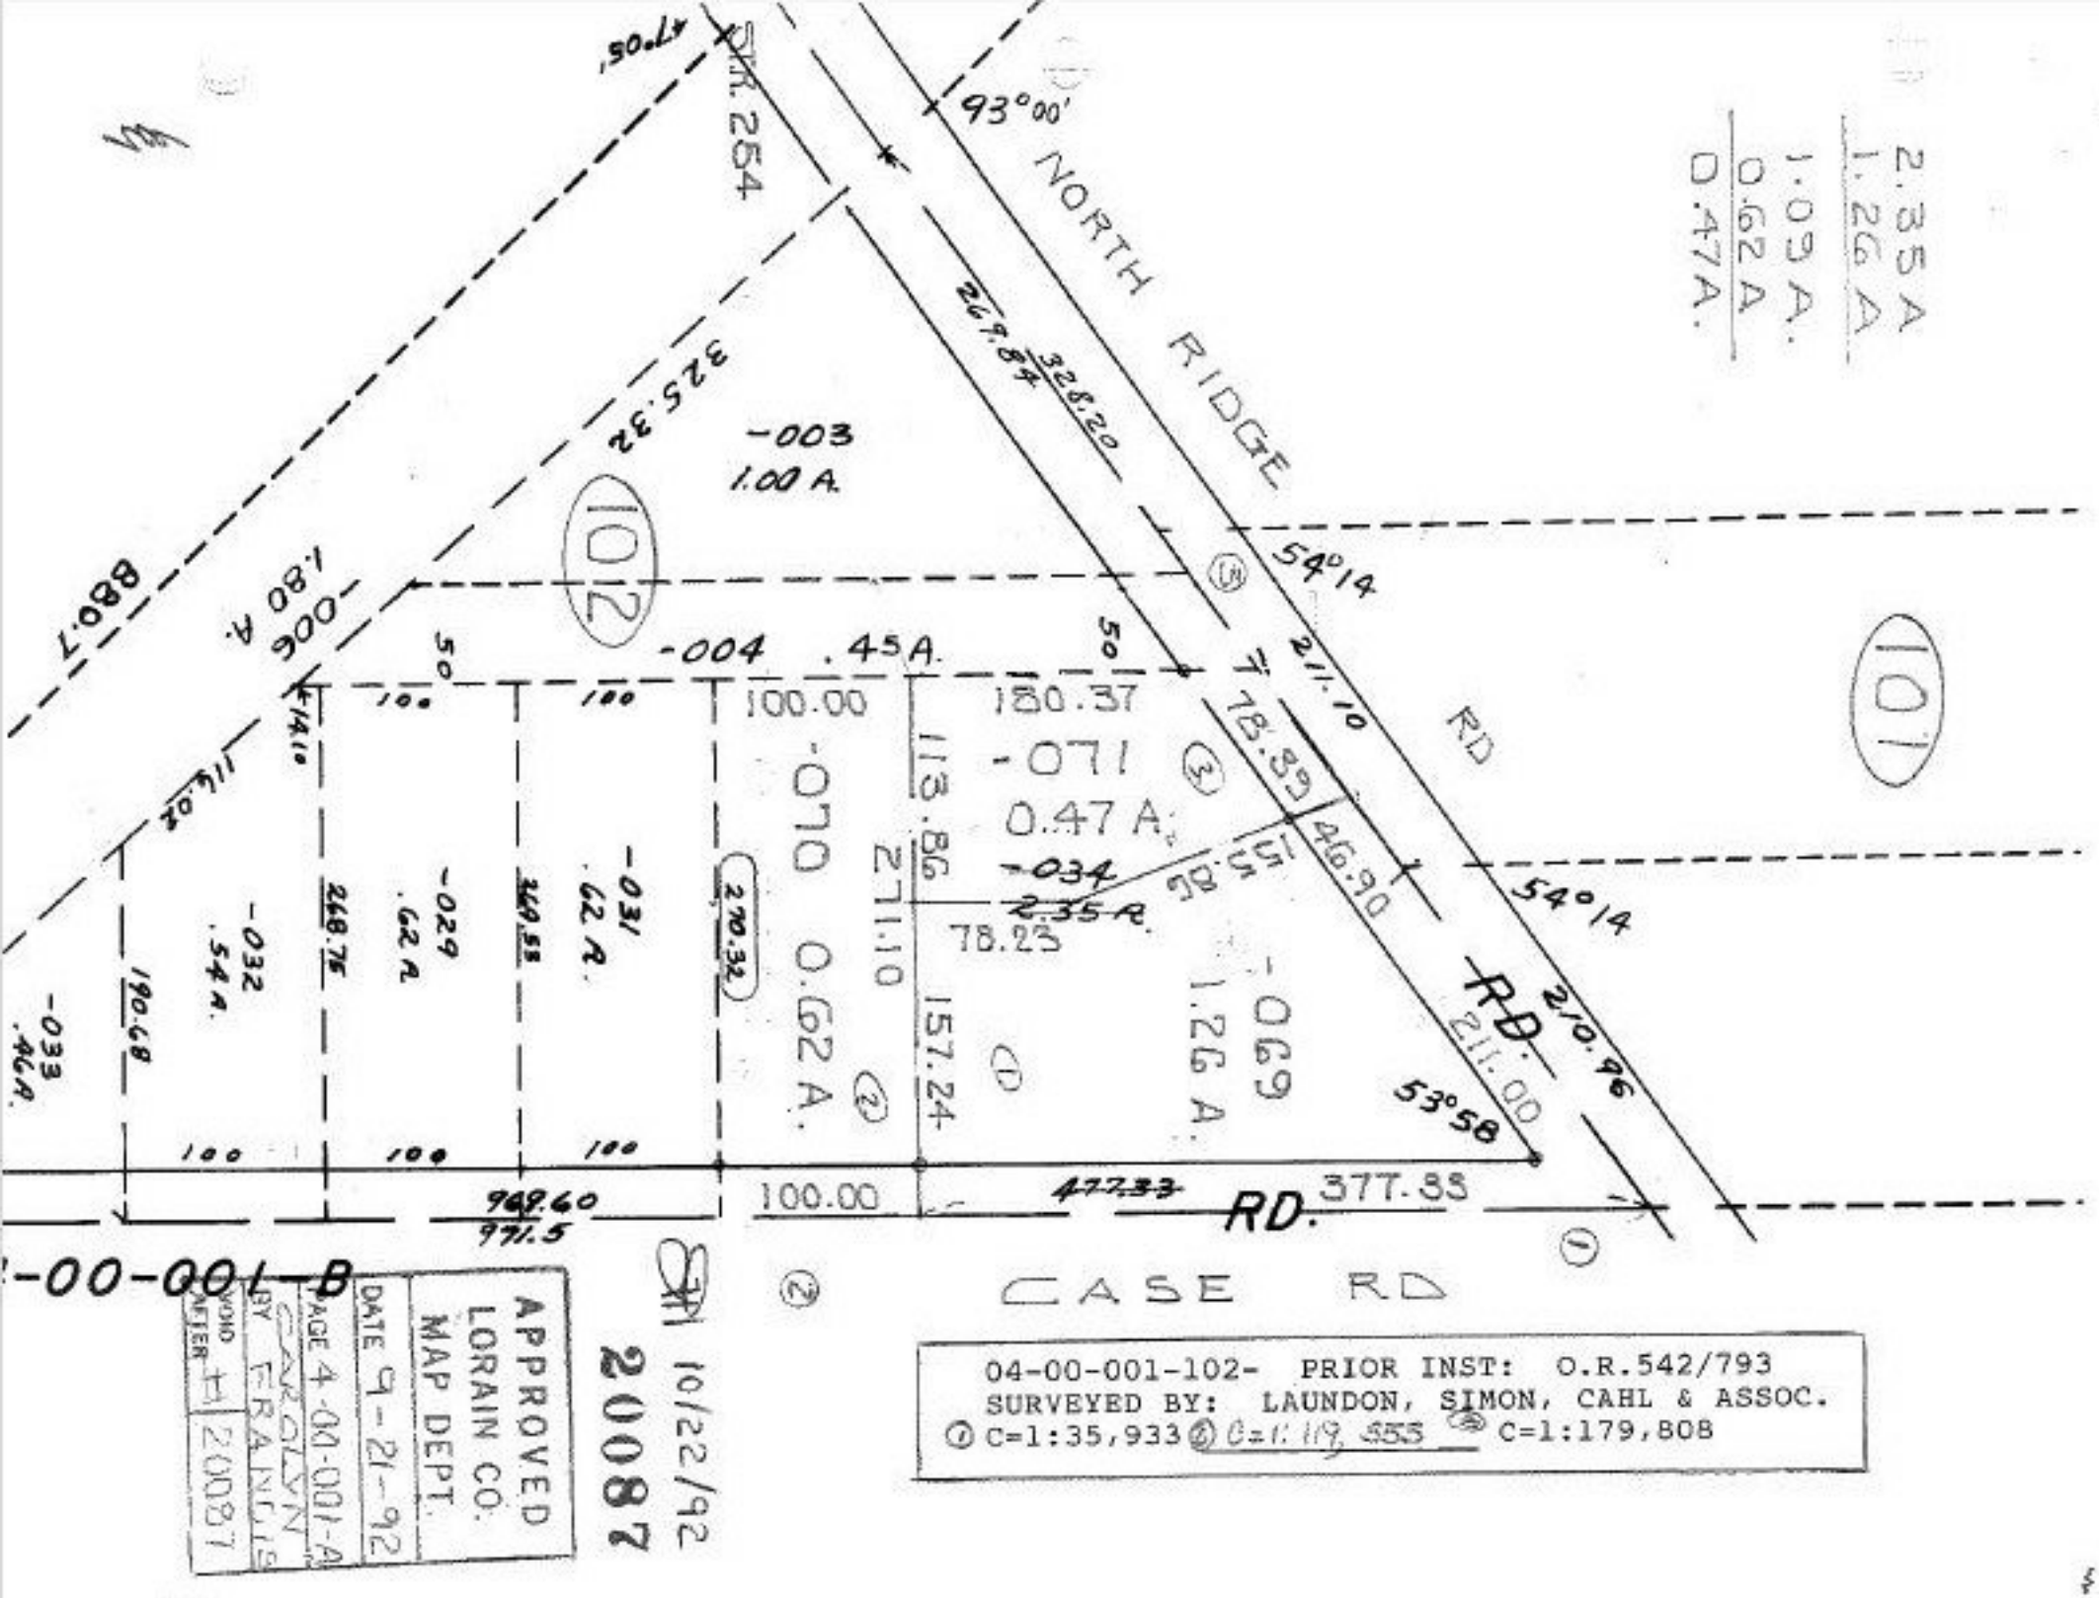
2.35 A.
1.26 A.
1.09 A.
0.62 A.
0.47 A.
93°00'
NORTH RIDGE
RT. 254
269.89
328.20
325.32
880.7
-003
1.00 A.
102
101
-004 .45 A.
54°14
211.10
RD
180.37
-071
0.47 A.
-034
2.35 A.
78.23
46.90
-070 0.62 A.
-069
1.26 A.
-029 .62 A.
-031 .62 A.
-032 .54 A.
-033 .46 A.
113.86
271.10
157.24
210.96
211.00
53°58
RD.
377.33
CASE RD
100.00
948.60
971.5
APPROVED
LORAIN CO.
MAP DEPT.
DATE 9-21-92
PAGE 4-00-001-A
BY CAROLYN FRANCIS
VOID AFTER 11
20087
10/22/92
20087
04-00-001-102- PRIOR INST: O.R.542/793
SURVEYED BY: LAUNDON, SIMON, CAHL & ASSOC.
① C=1:35,933 ② C=1:119,455 ③ C=1:179,808