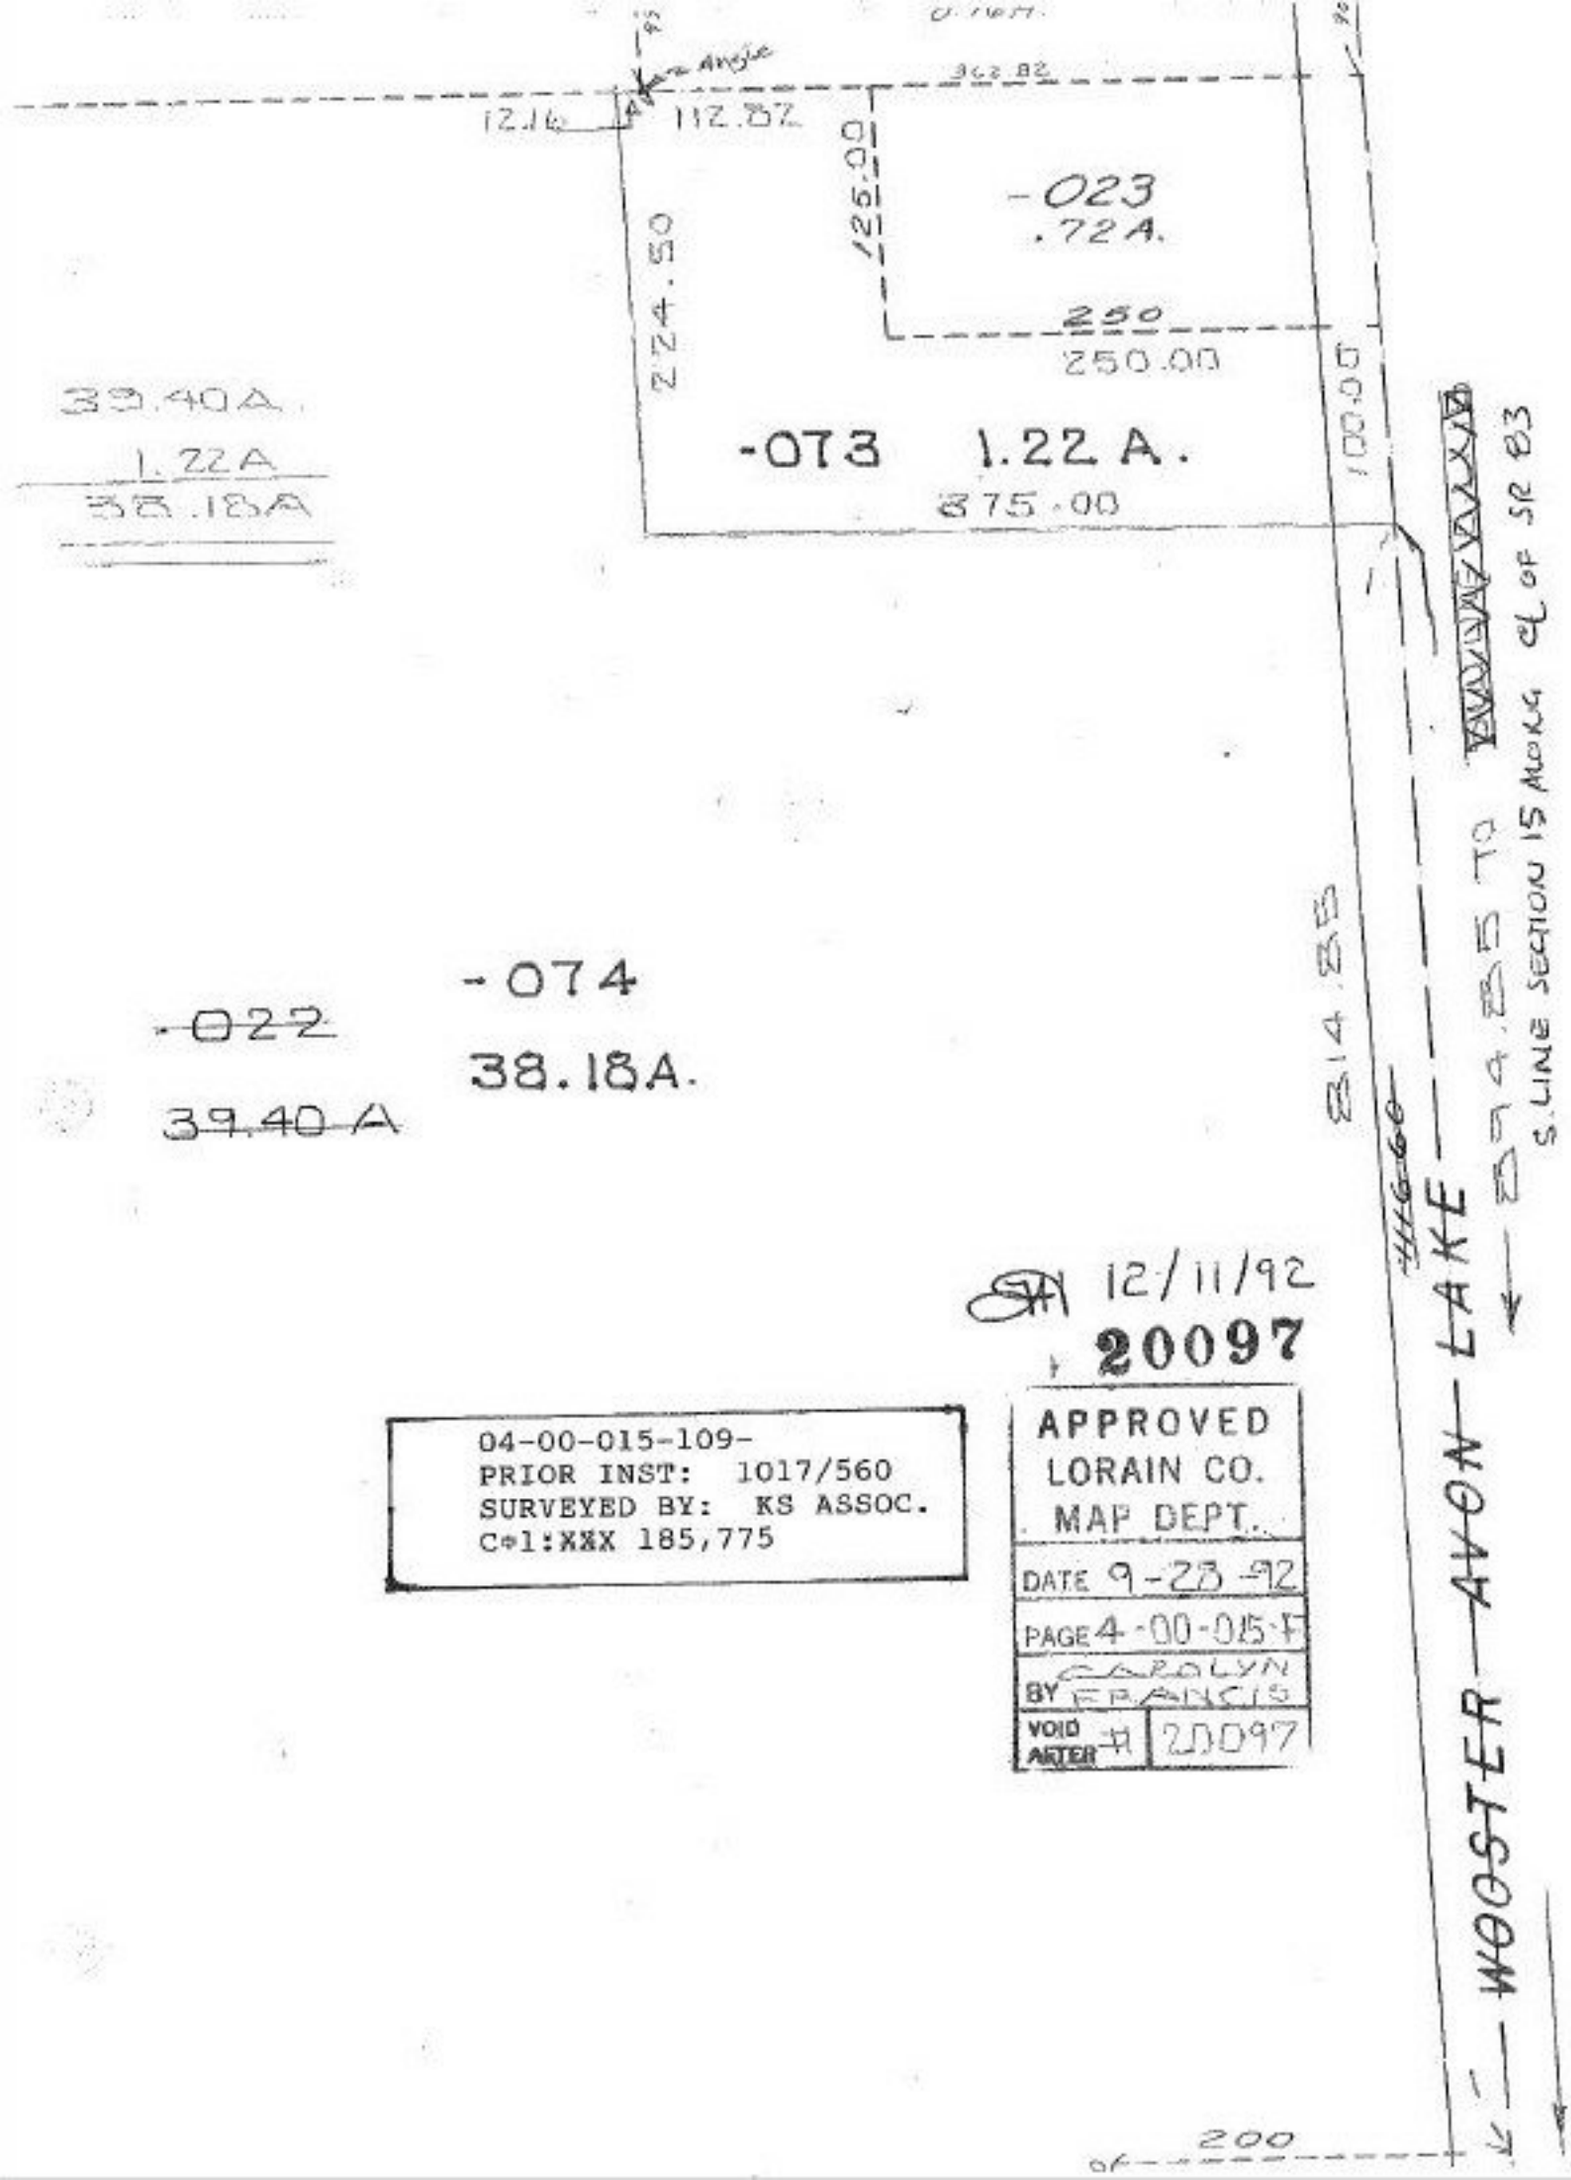

12/11/92

20097

04-00-015-109-
PRIOR INST: 1017/560
SURVEYED BY: KS ASSOC.
C#1:XXX 185,775

APPROVED
LORAIN CO.
MAP DEPT.
DATE 9-23-92
PAGE 4-00-015-F
BY CAROLYN FRANCIS
VOID AFTER 11 20097