SEE 1

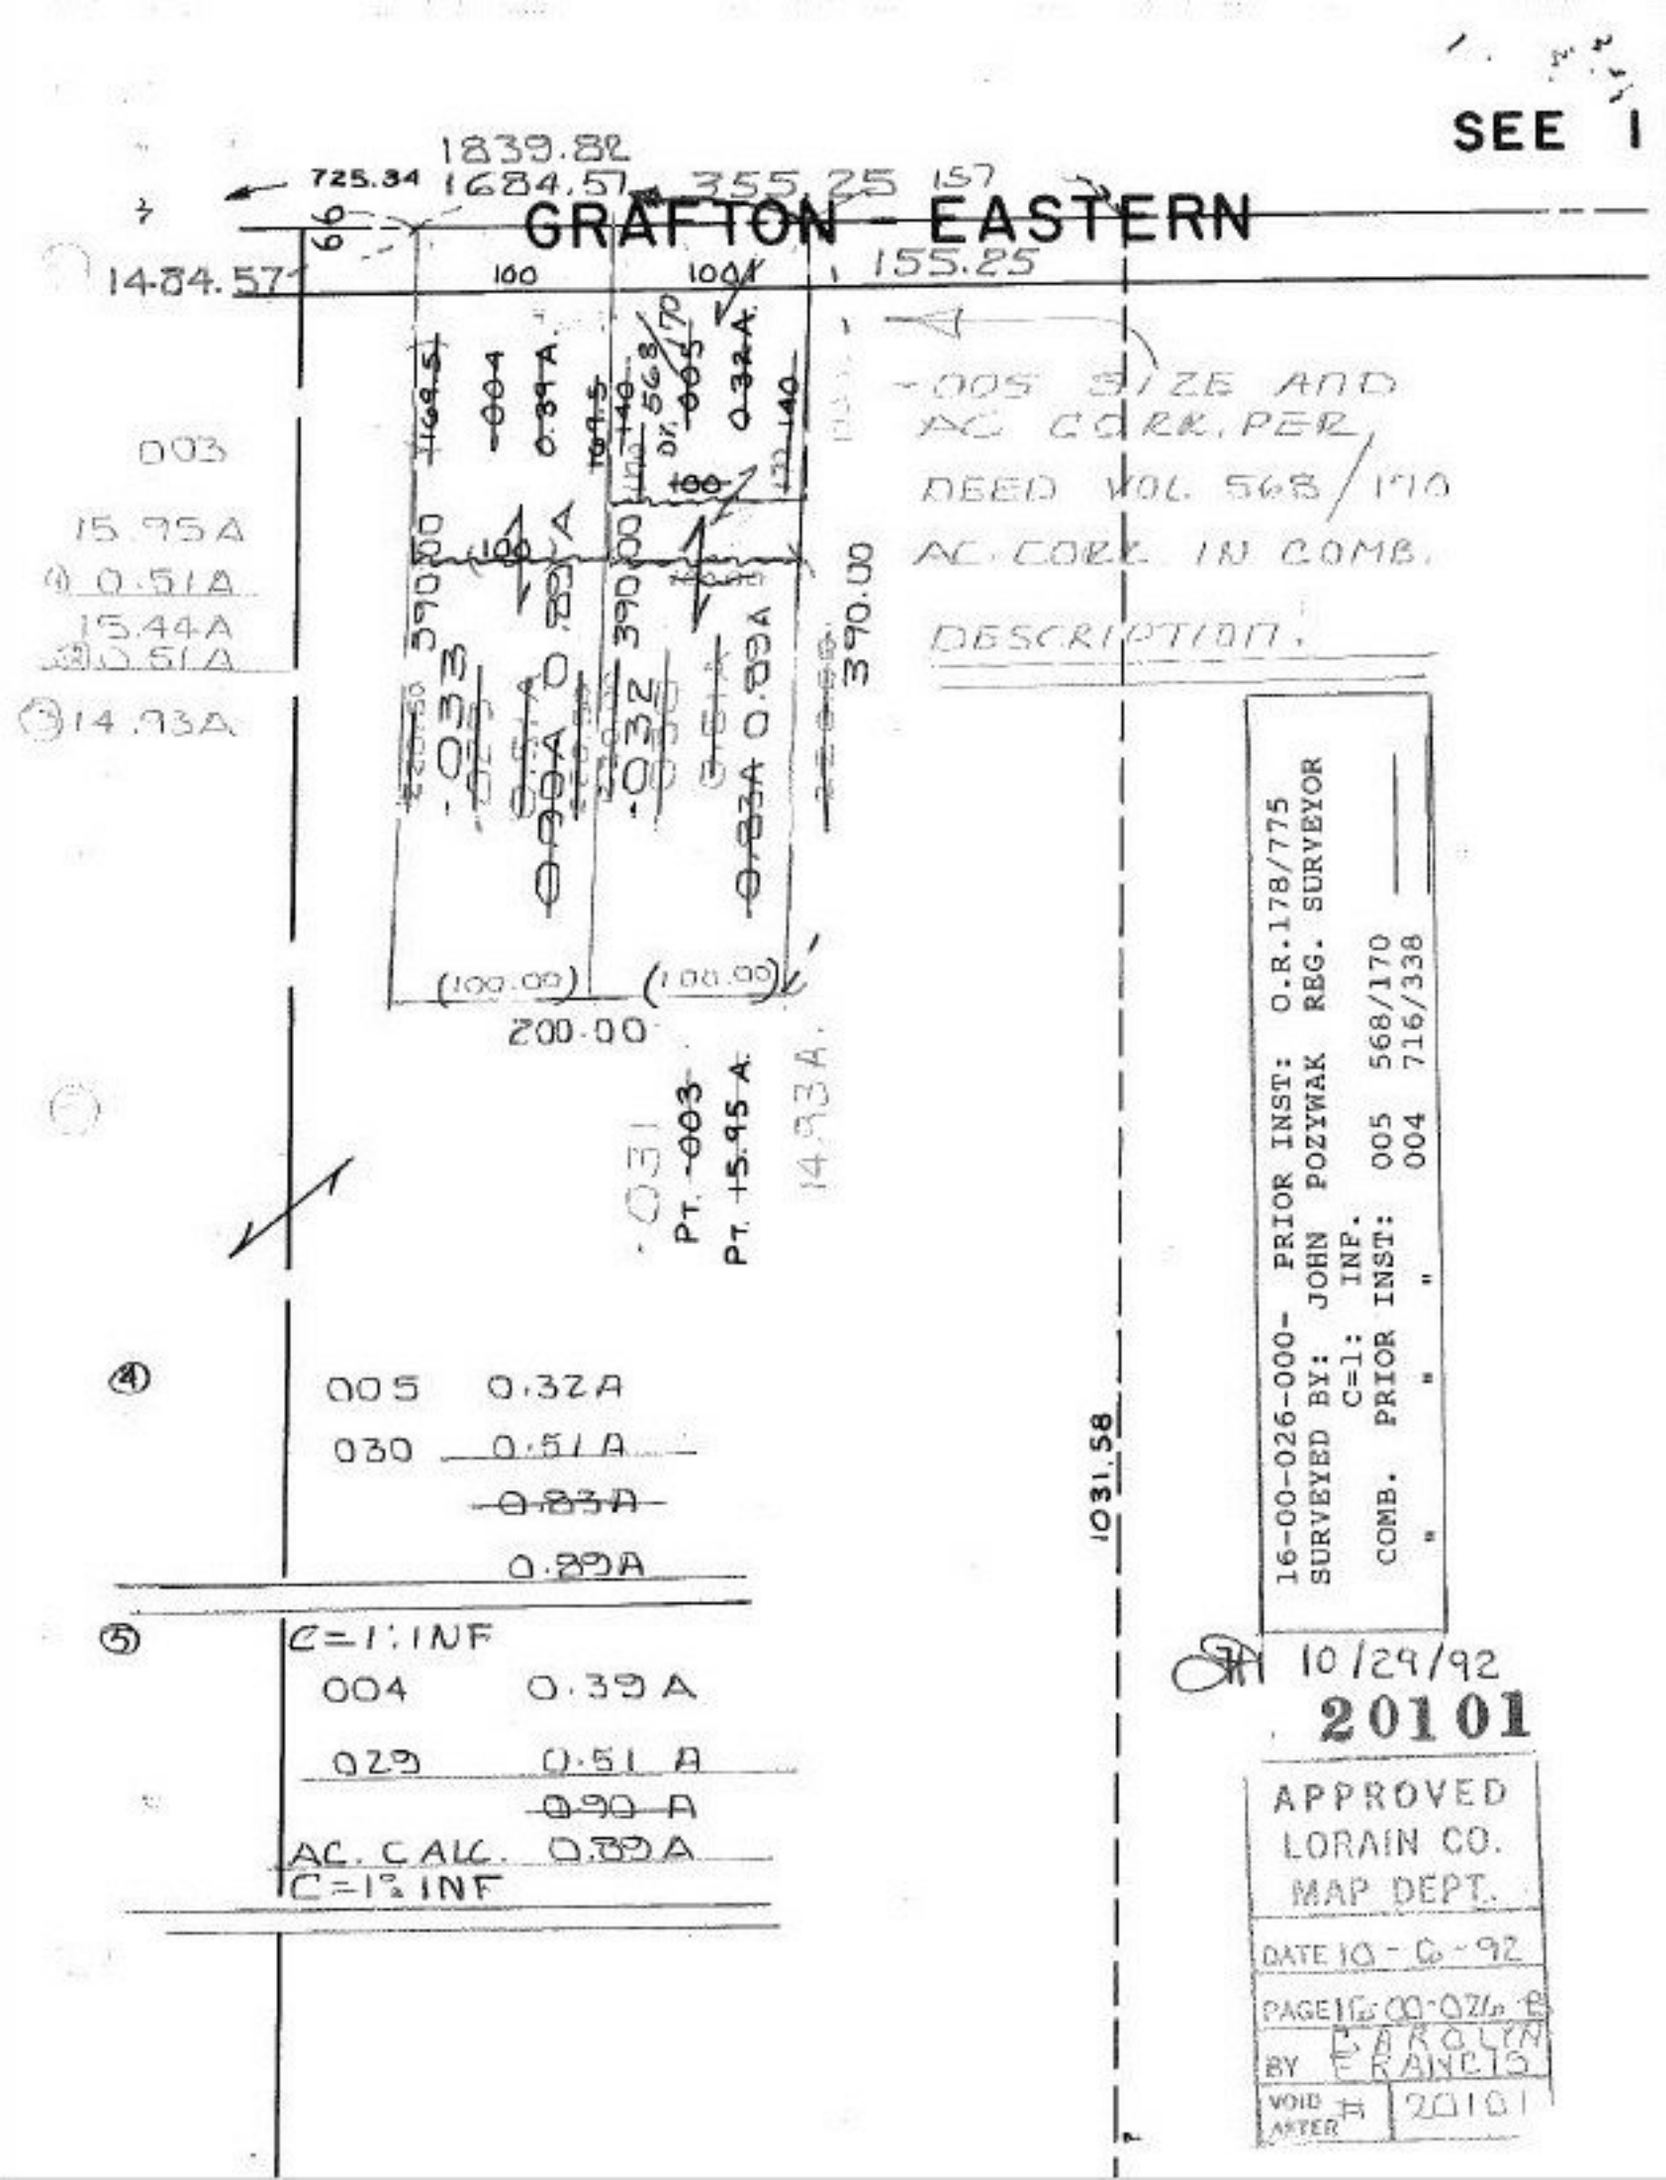

④ 005 0.32A
030 0.51A
~~0.83A~~
0.83A

⑤ C=1: INF
004 0.39A
029 0.51A
~~0.90A~~
AC. CALC. 0.83A
C=1% INF