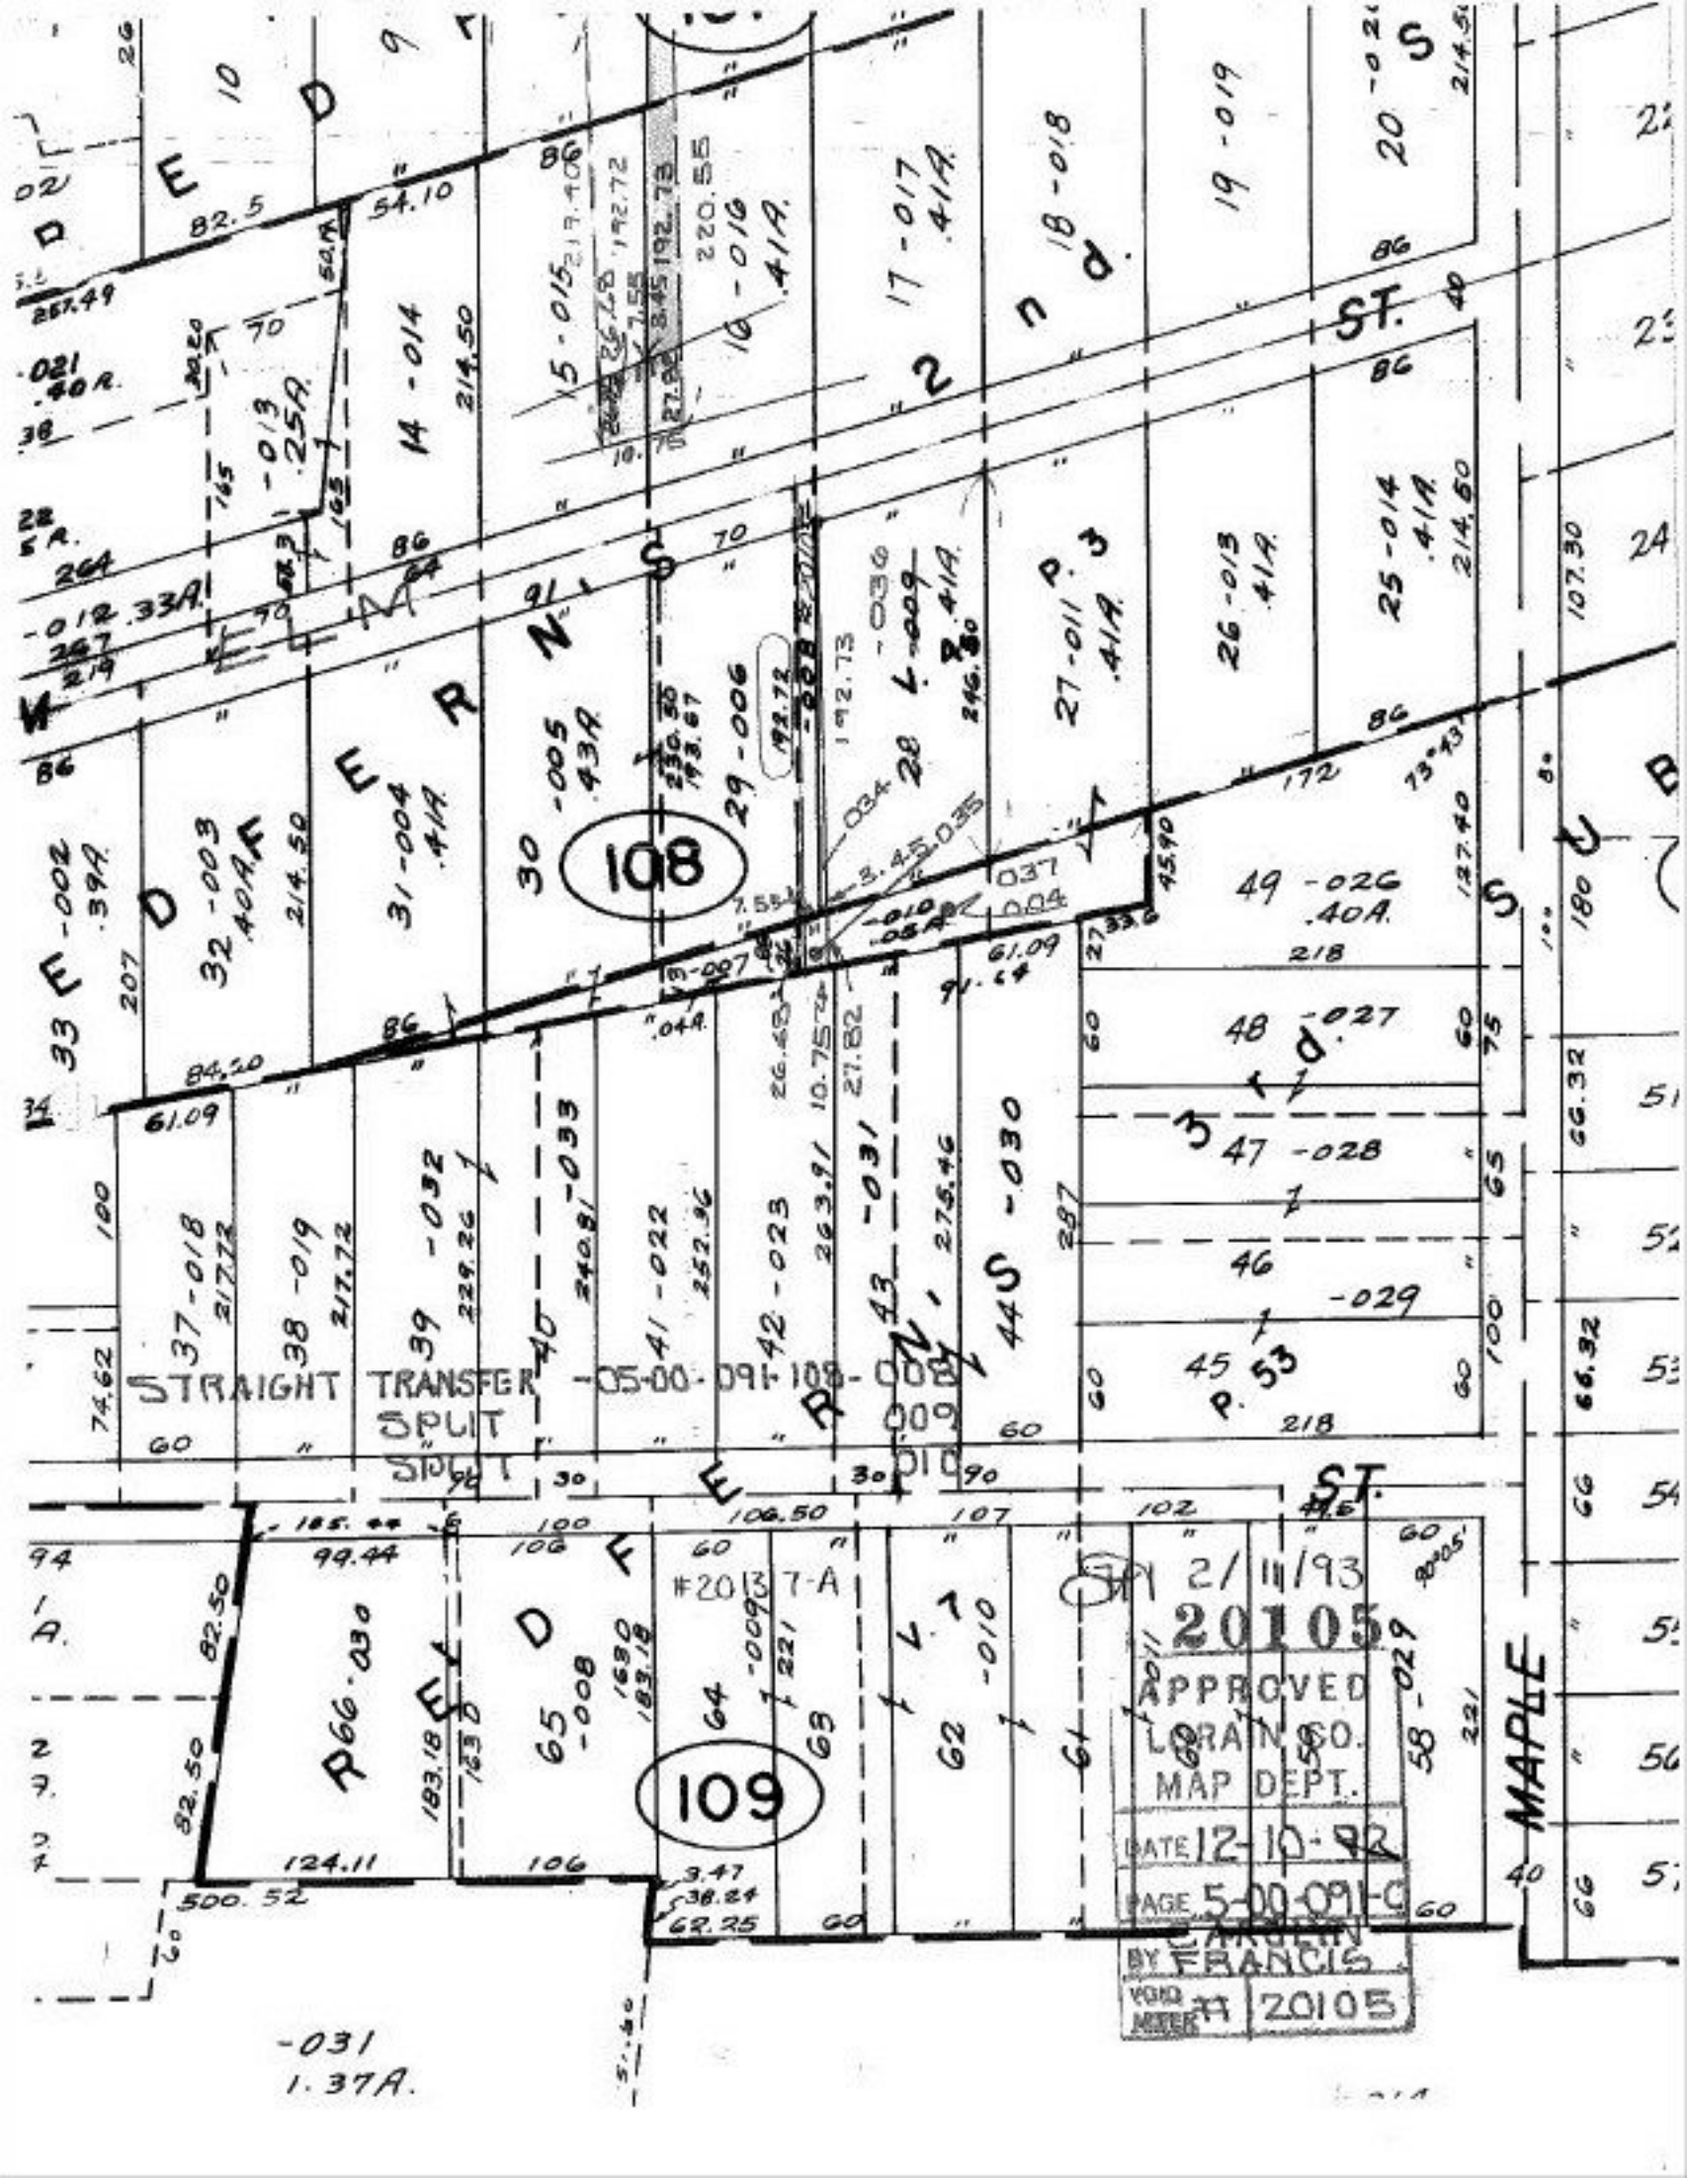

108
109
STRAIGHT TRANSFER -05-00-091-108-008
SPLIT 009
SPLIT 010
#20137-A
2/11/93
20105
APPROVED
LORAIN CO.
MAP DEPT.
DATE 12-10-92
PAGE 5-00-091-C
BY CARGLIN FRANCIS
VOID MEMO # 20105
MAPLE
ST.