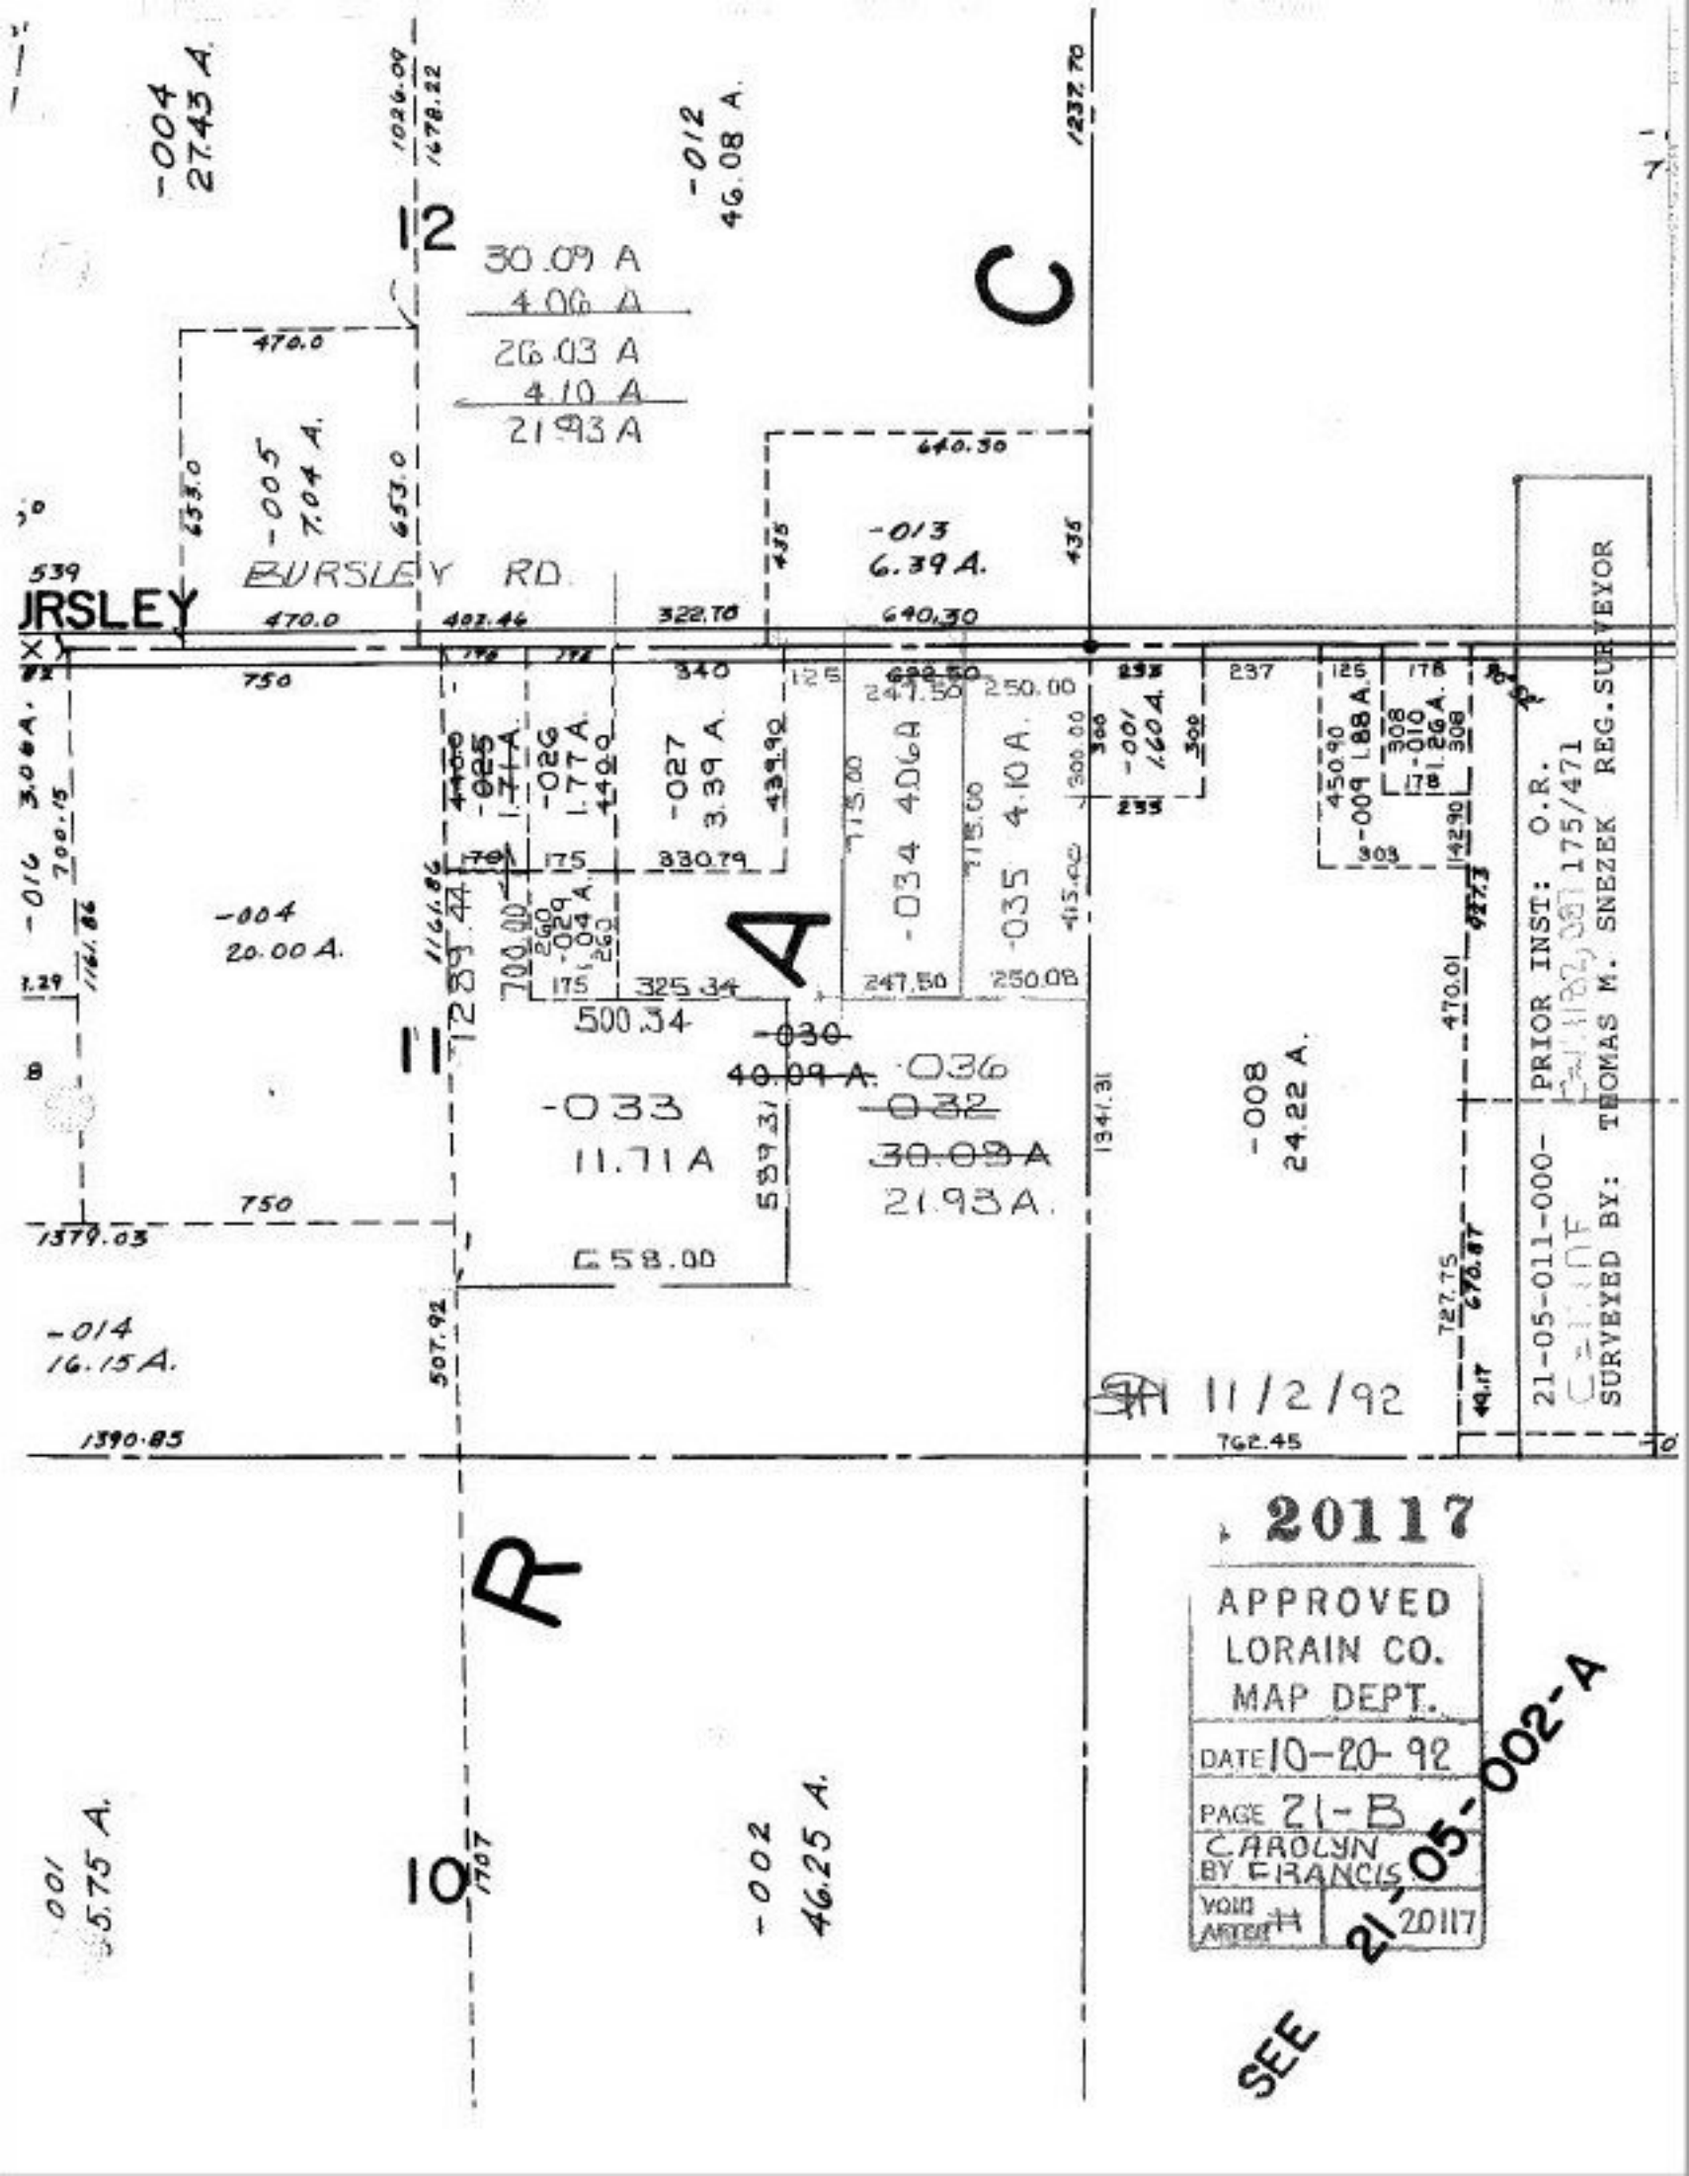

-004
27.43 A.
-012
46.08 A.
12
30.09 A
4.06 A
26.03 A
4.10 A
21.93 A
C
-005
7.04 A.
-013
6.39 A.
BURSLEY RD.
URSLEY
-004
20.00 A.
-027
3.39 A.
-034 4.06 A
-035 4.10 A.
-001
1.60 A.
-009 1.88 A.
-008
24.22 A.
A
11
-033
11.71 A
-036
21.93 A.
-014
16.15 A.
11/2/92
R
10
-002
46.25 A.
21-05-011-000- PRIOR INST: O.R. 175/471
SURVEYED BY: THOMAS M. SNEZEK REG. SURVEYOR
20117
APPROVED
LORAIN CO.
MAP DEPT.
DATE 10-20-92
PAGE 21-B
CAROLYN
BY FRANCIS
VOID AFTER
20117
SEE 21-05-002-A