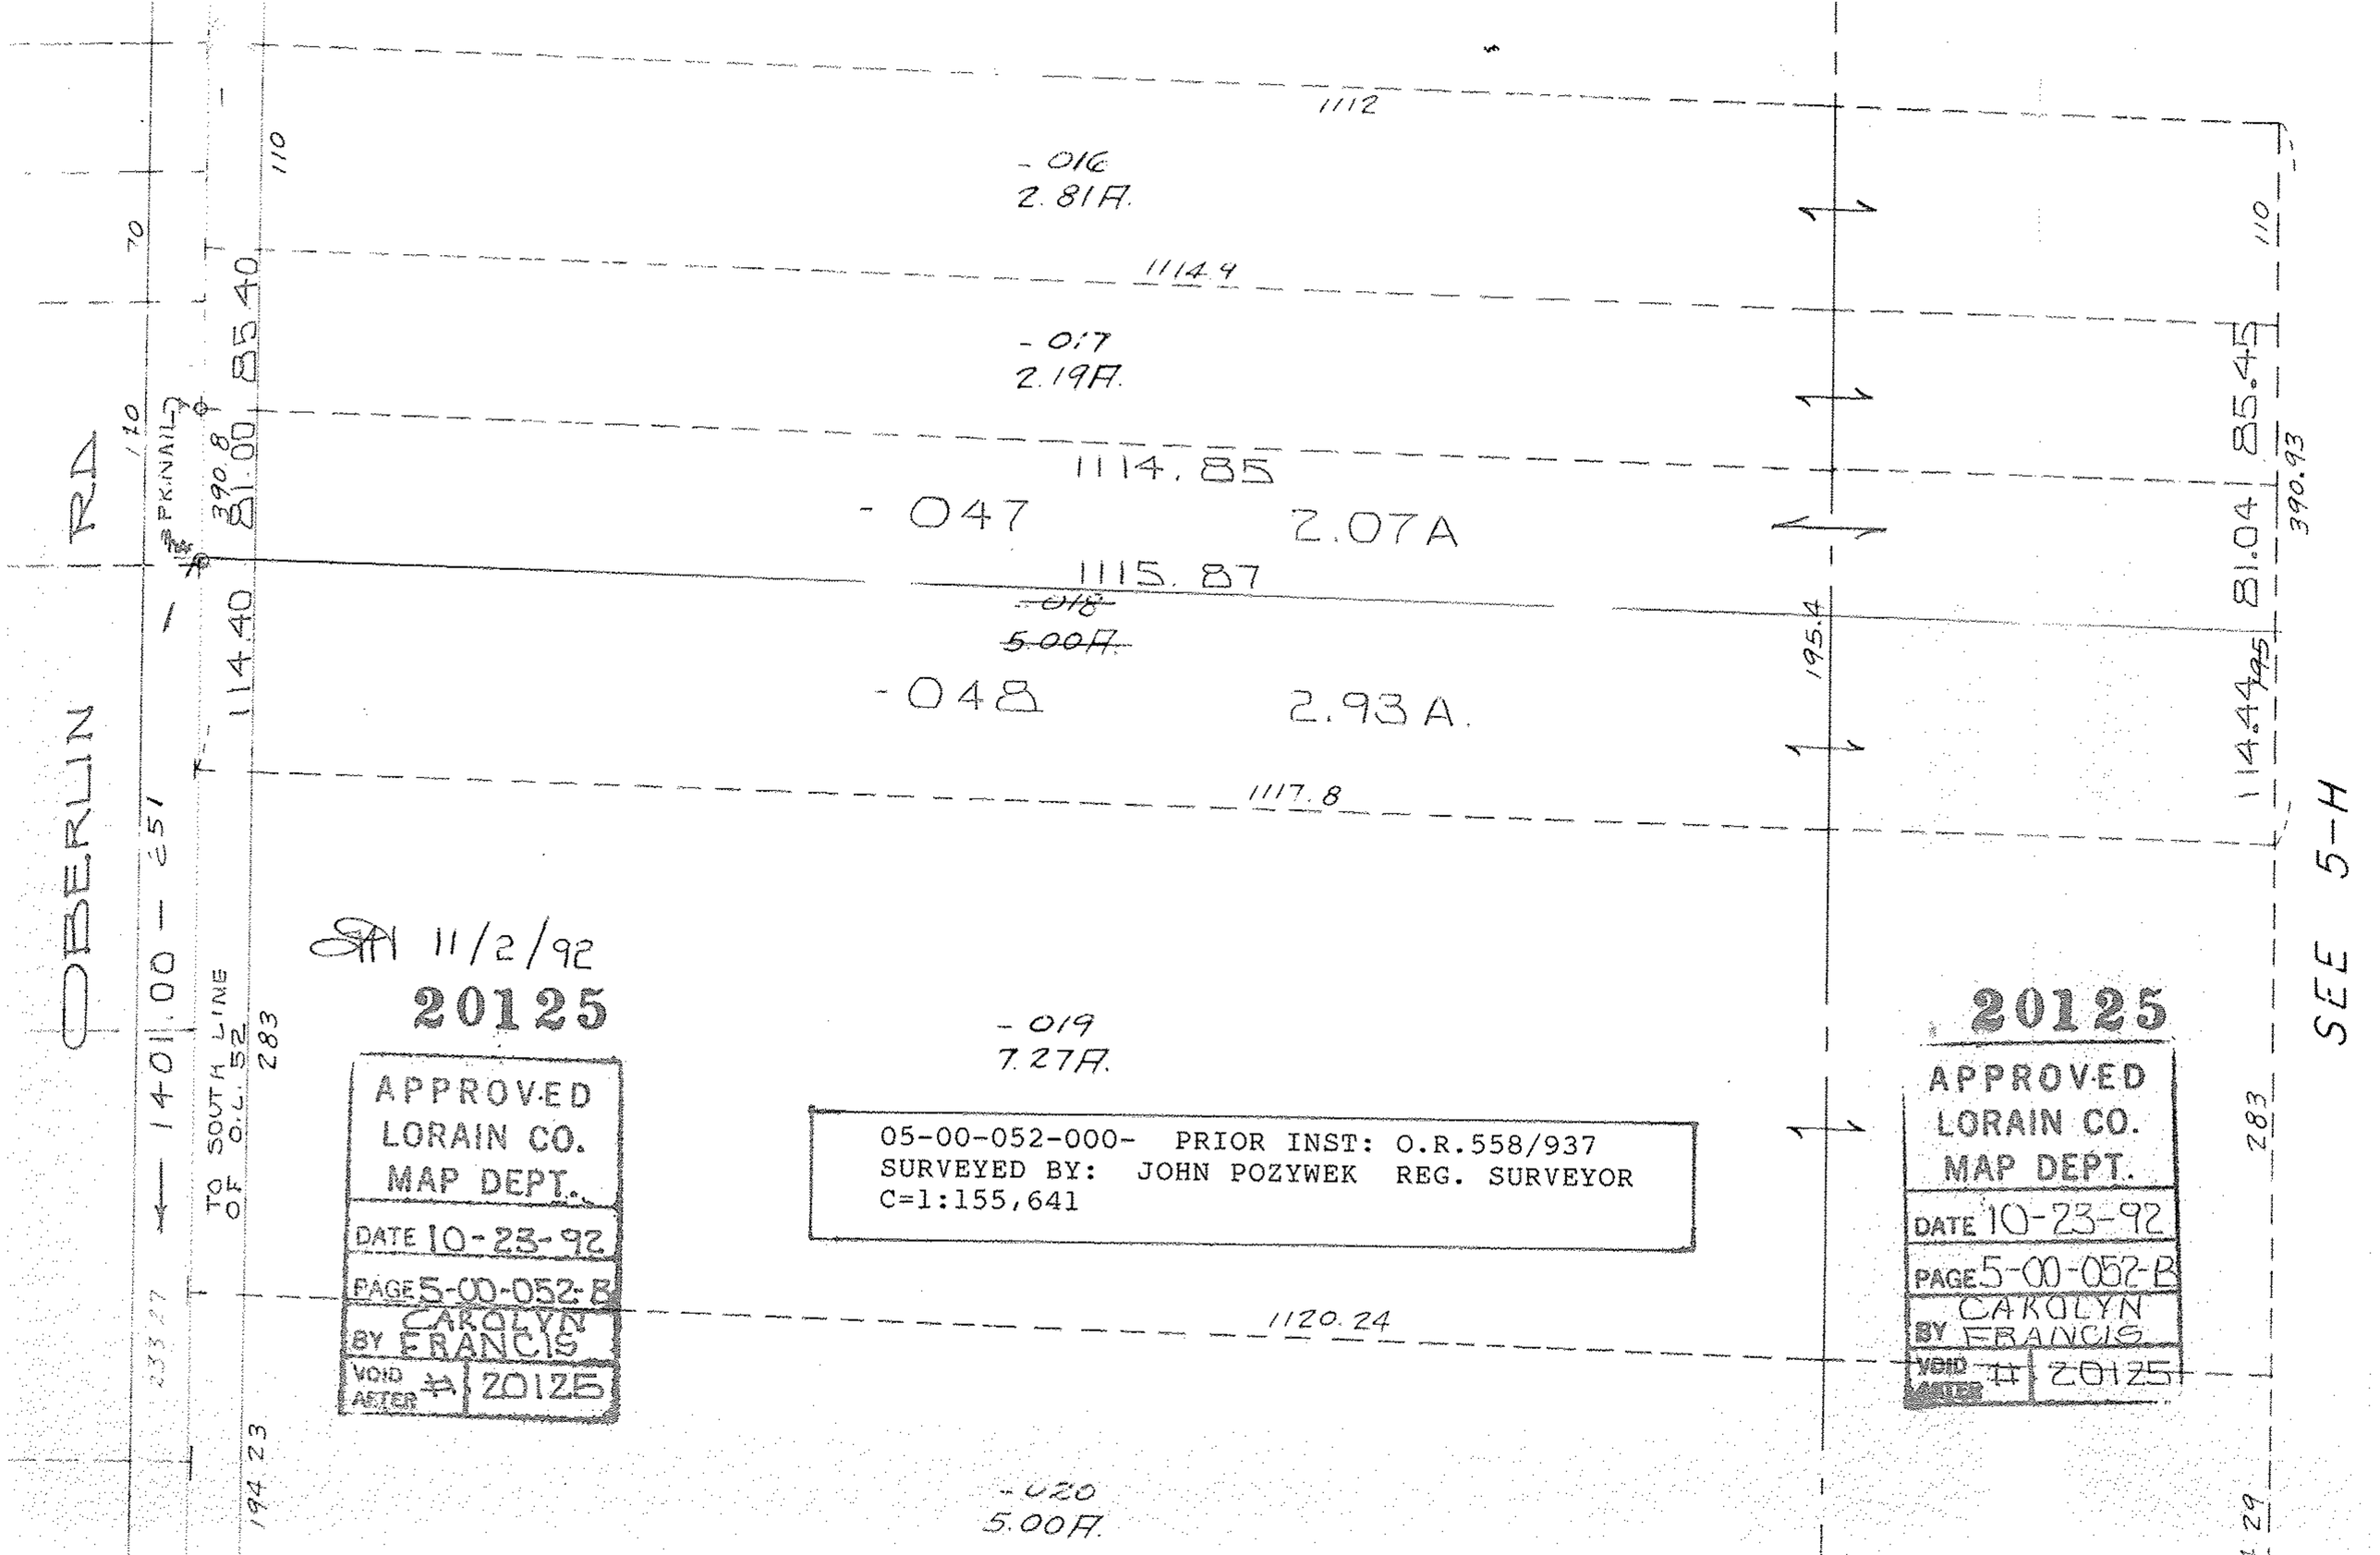

OBERLIN RD
1401.00 - 251
TO SOUTH LINE OF O.L. 52
PK NAIL
390.8
85.40
81.00
114.40
110
70
283
233.27
194.23
1112
-016
2.81A.
1114.9
-017
2.19A.
1114.85
-047
2.07A
1115.87
-018
5.00A.
-048
2.93A.
1117.8
-019
7.27A.
1120.24
-020
5.00A.
195.4
110
85.45
81.04
114.44
390.93
283
SEE 5-H
11/2/92
20125
APPROVED
LORAIN CO.
MAP DEPT.
DATE 10-23-92
PAGE 5-00-052-B
BY CAROLYN FRANCIS
VOID AFTER # 20125
05-00-052-000- PRIOR INST: O.R.558/937
SURVEYED BY: JOHN POZYWEK REG. SURVEYOR
C=1:155,641
20125
APPROVED
LORAIN CO.
MAP DEPT.
DATE 10-23-92
PAGE 5-00-052-B
BY CAROLYN FRANCIS
VOID AFTER # 20125