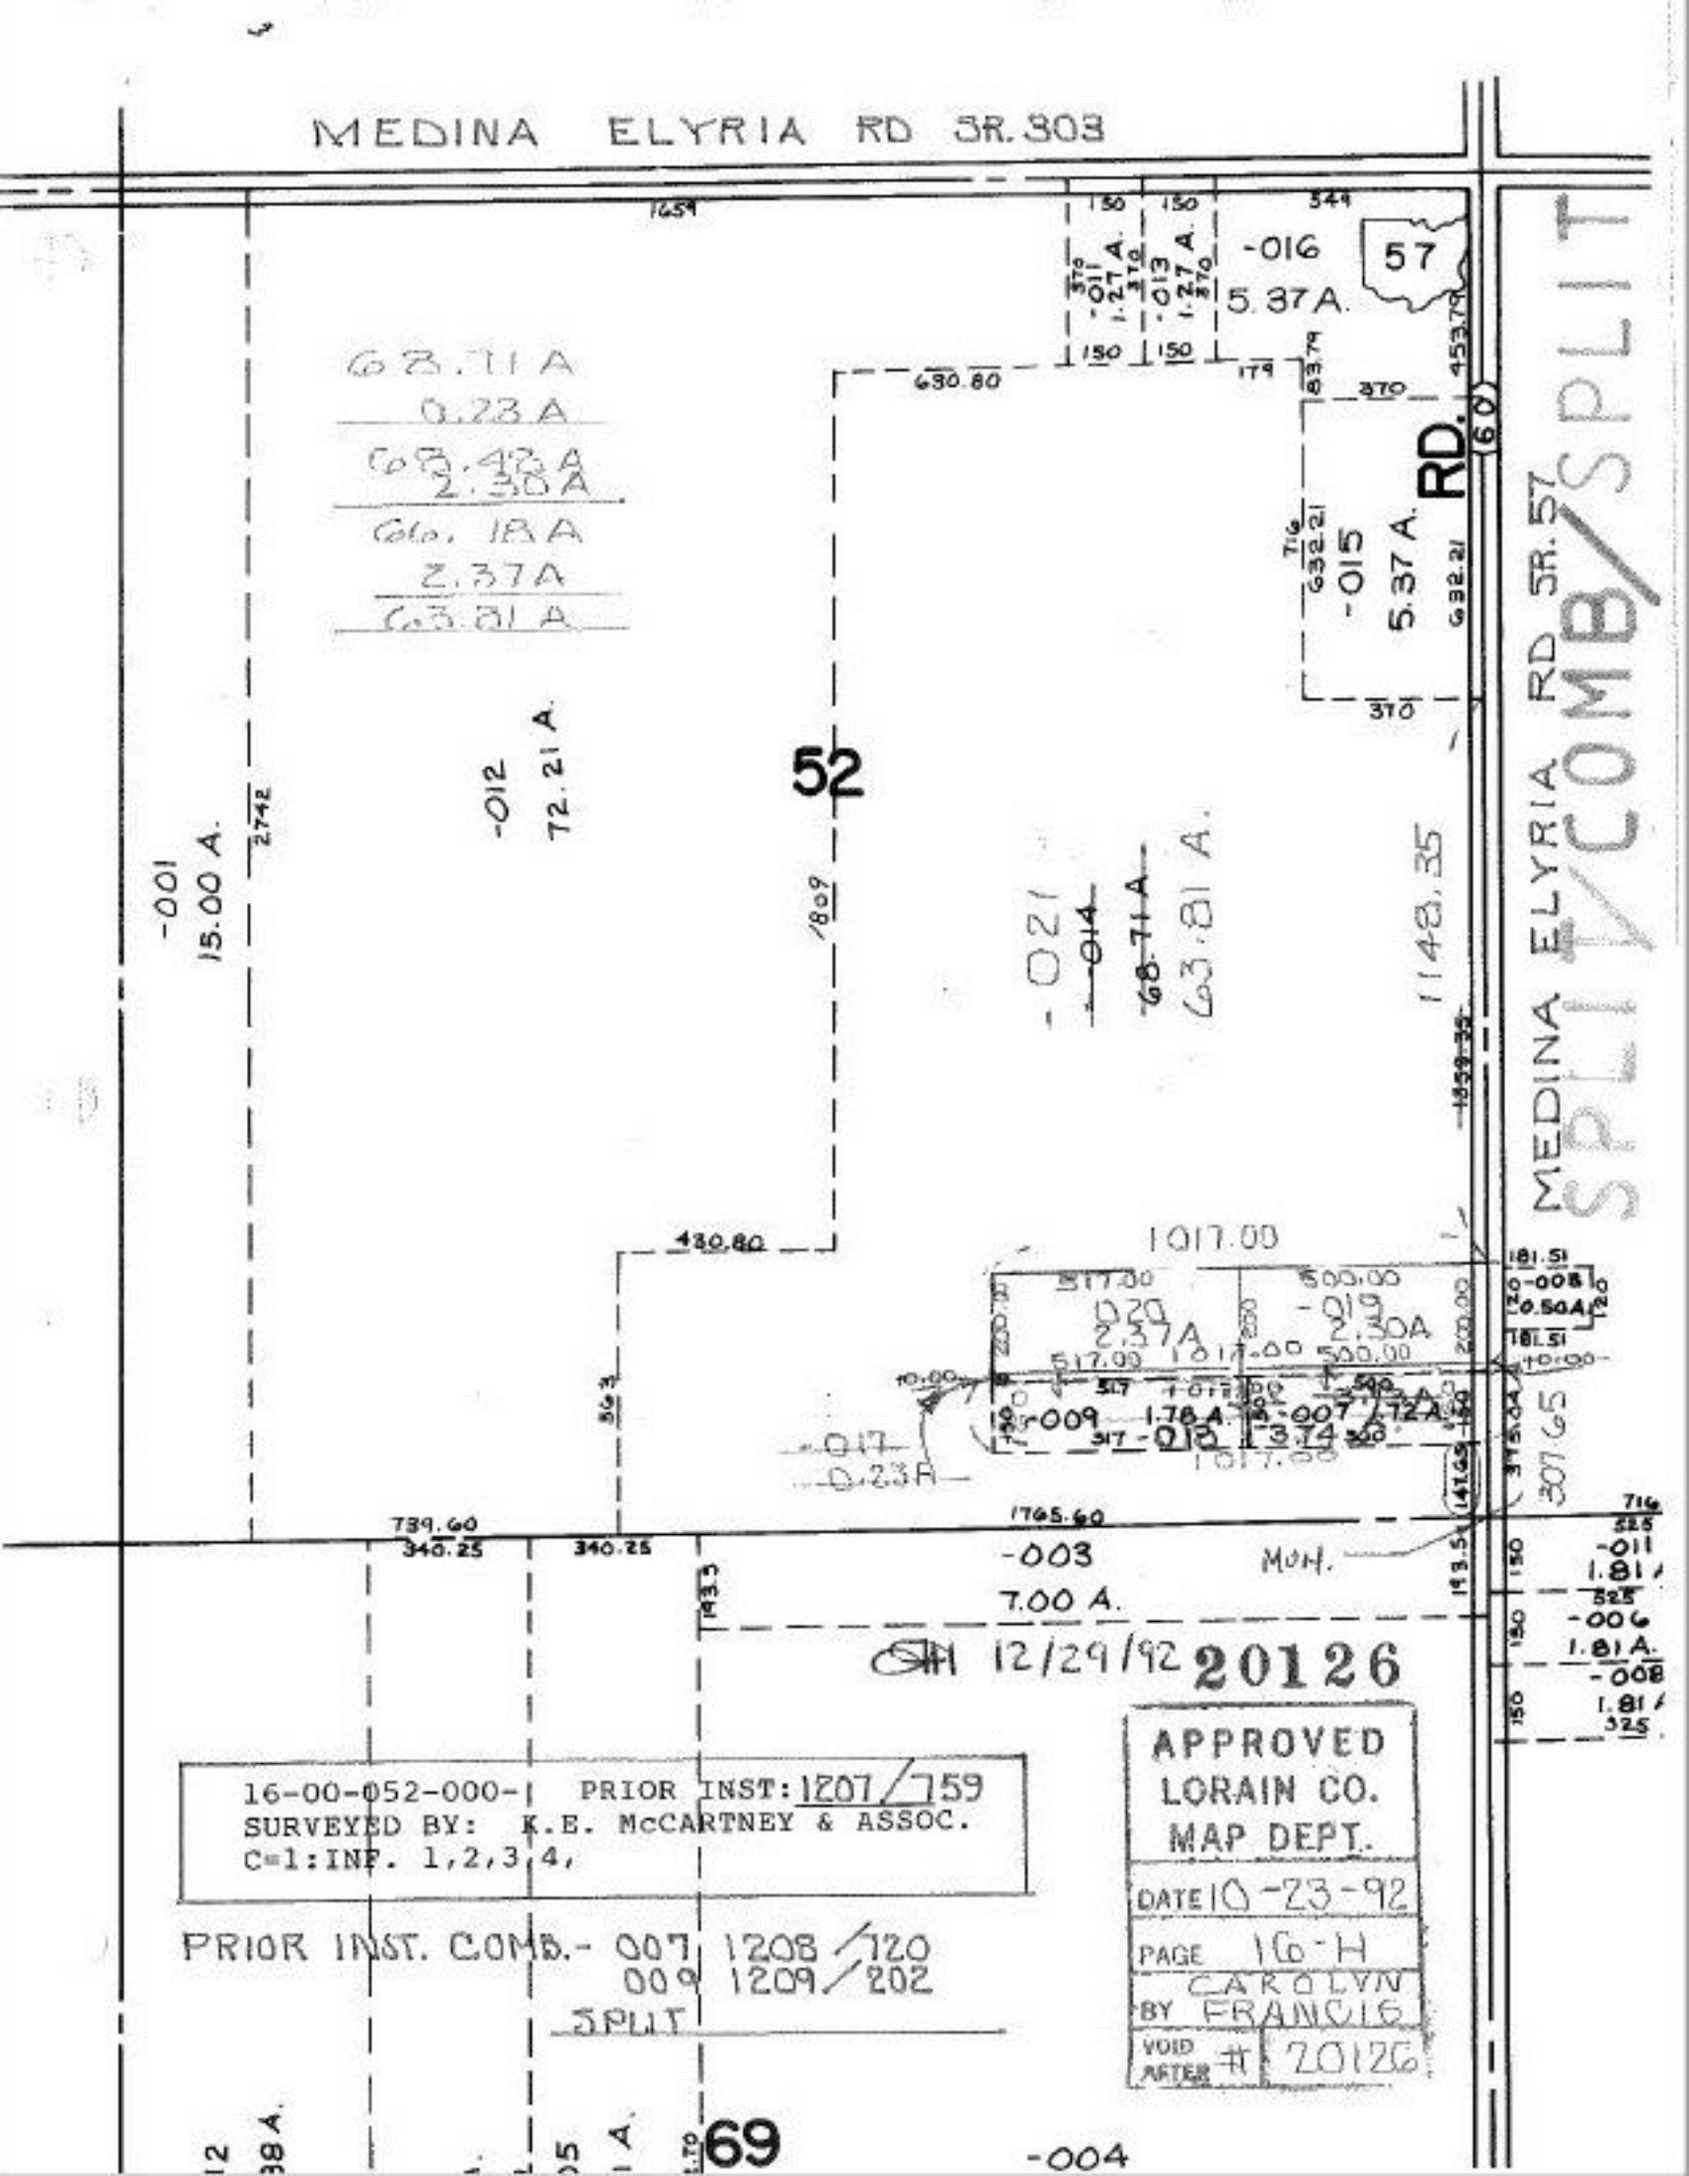
MEDINA ELYRIA RD SR.303
MEDINA ELYRIA RD SR.57
SPLIT/COMB/SPLIT
57
52
69
-016
5.37 A.
-015
5.37 A.
RD.
-012
72.21 A.
-001
15.00 A.
-021
-014
68.71 A.
63.81 A.
68.71 A
0.23 A
68.48 A
2.38 A
66.10 A
2.37 A
63.81 A
-020
2.37 A
-019
2.30 A
-009
1.78 A.
-007
1.72 A.
-017
0.23 A
-003
7.00 A.
-004
1148.35
1017.00
739.60
340.25
1745.60
307.65
MON.
12/29/92 20126
16-00-052-000-1 PRIOR INST: 1207/759
SURVEYED BY: K.E. McCARTNEY & ASSOC.
C=1:INF. 1,2,3,4,
PRIOR INST. COMB.- 007 1208/120
009 1209/202
SPLIT
APPROVED
LORAIN CO.
MAP DEPT.
DATE 10-23-92
PAGE 16-H
BY CAROLYN FRANCIS
VOID AFTER # 20126