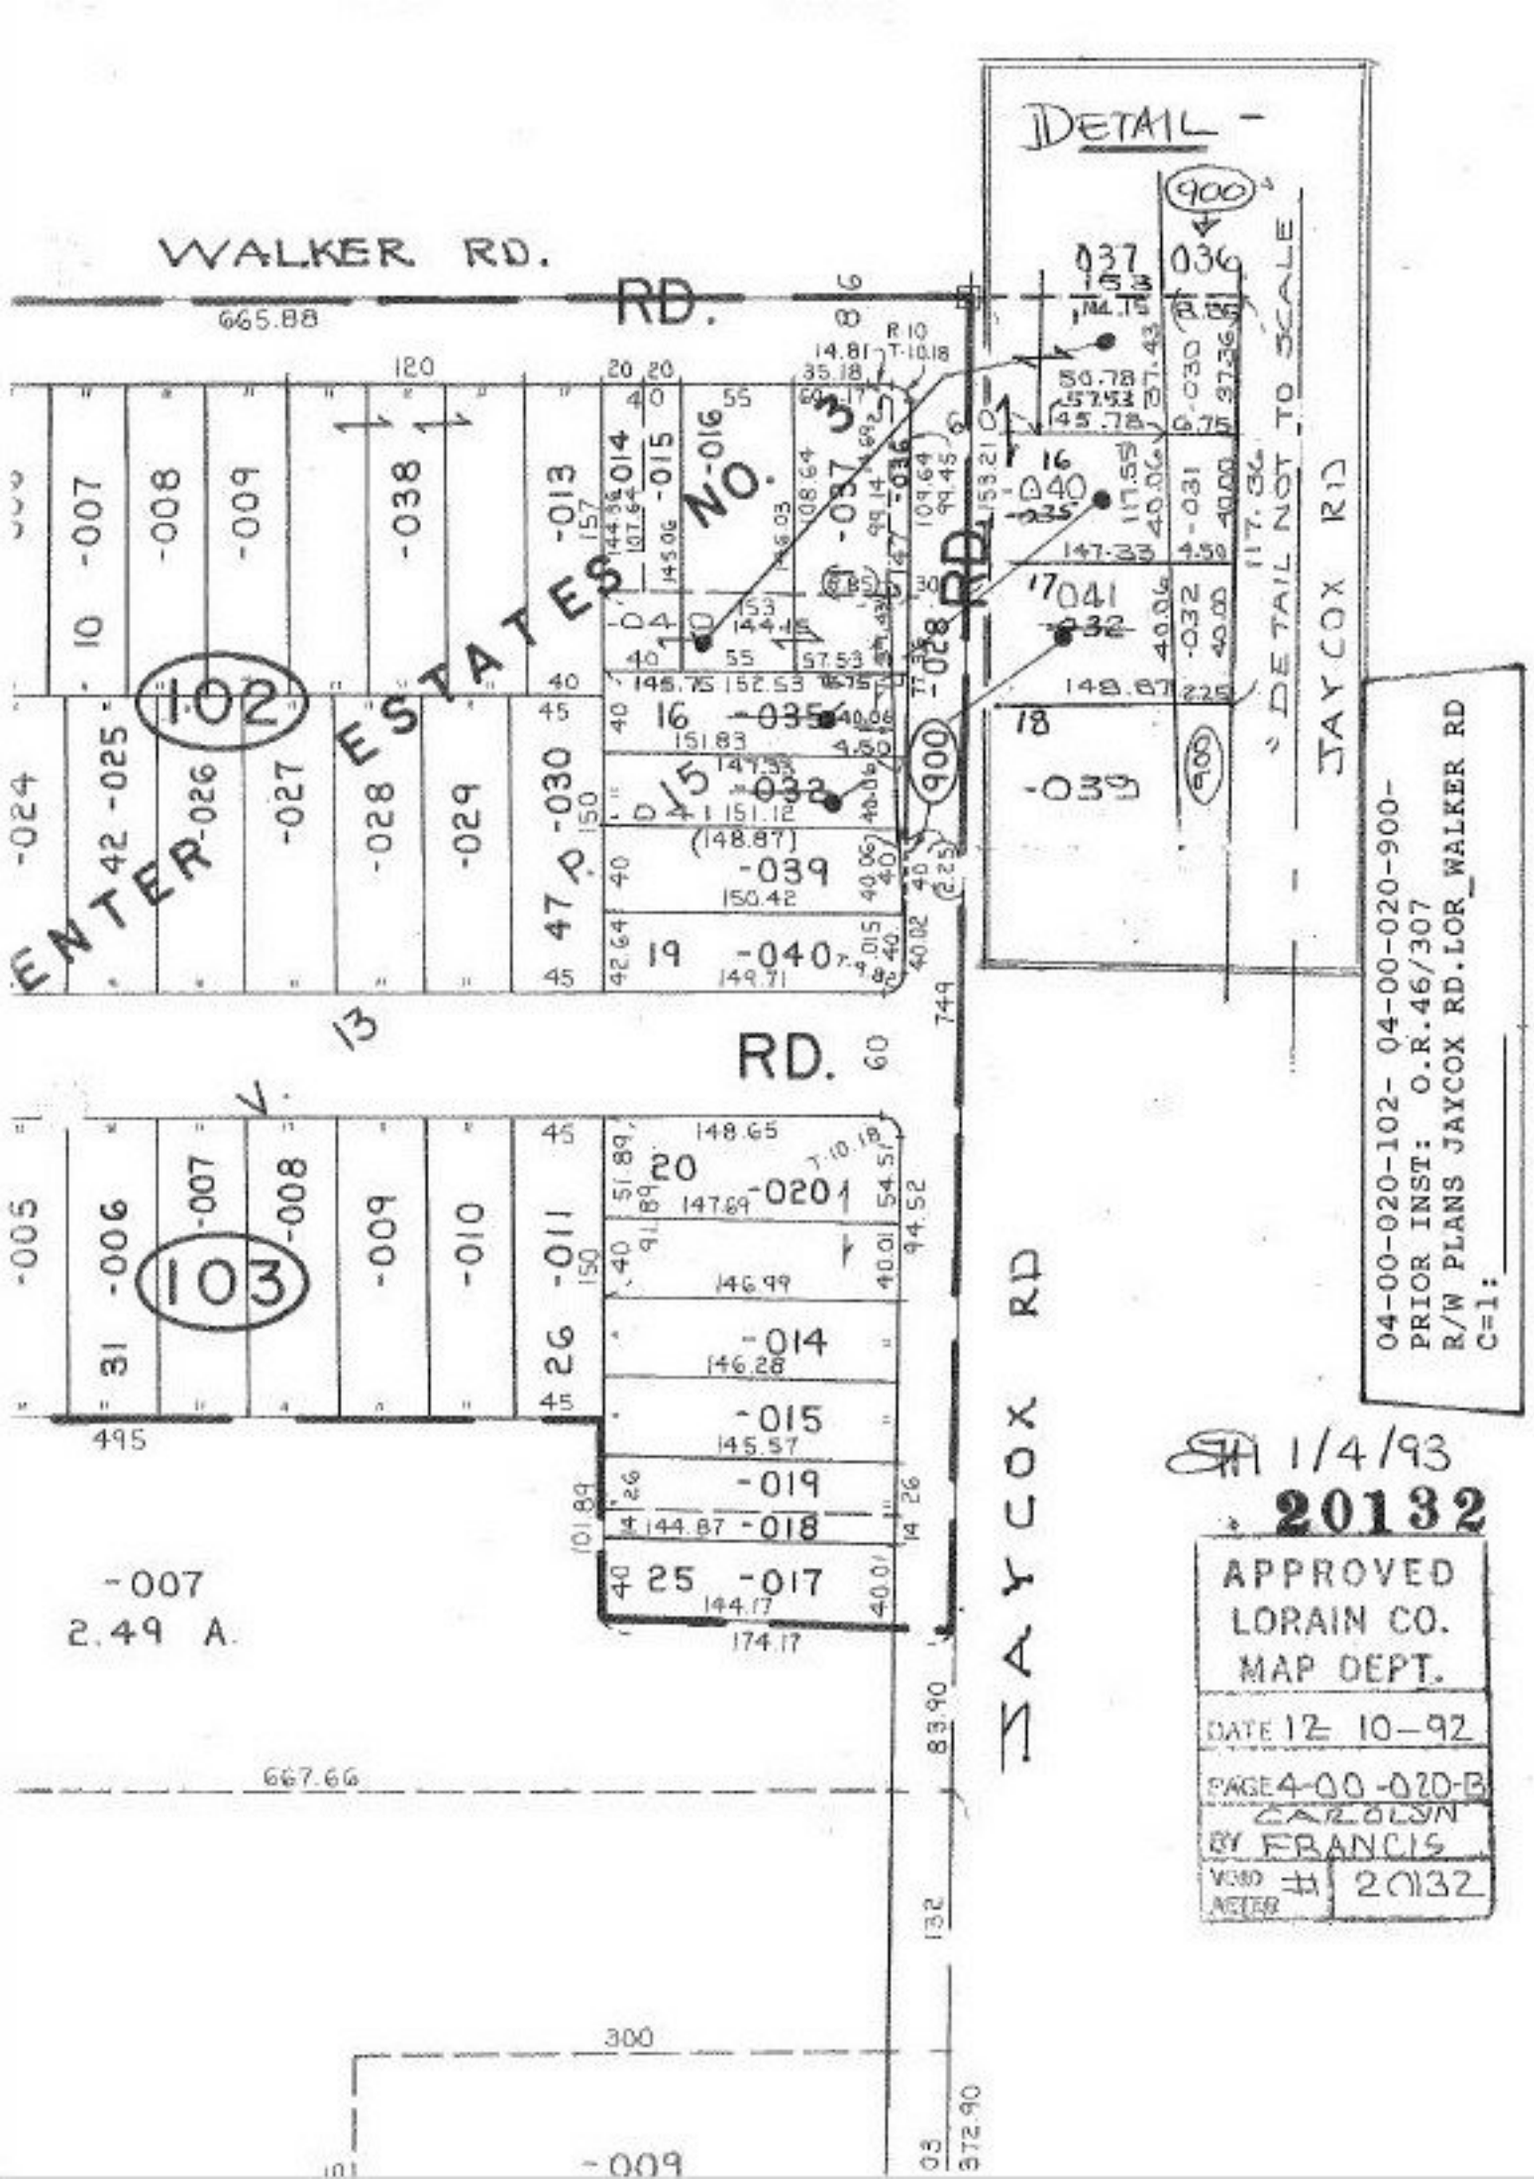
WALKER RD.
RD.
665.88
DETAIL -
NOT TO SCALE
JAYCOX RD
ENTER
ESTATES NO. 3
102
103
-007
-008
-009
-010
-011
-013
-014
-015
-016
-017
-018
-019
-020
-021
-025
-026
-027
-028
-029
-030
-031
-032
-035
-036
-037
-038
-039
-040
-041
-900
RD.
JAYCOX RD
667.66
300
-007
2.49 A.
-009
04-00-020-102- 04-00-020-900-
PRIOR INST: O.R.46/307
R/W PLANS JAYCOX RD.LOR_WALKER RD
C=1:
1/4/93
20132
APPROVED
LORAIN CO.
MAP DEPT.
DATE 12-10-92
PAGE 4-00-020-B
CAROLYN
BY FRANCIS
VOID AFTER # 20132