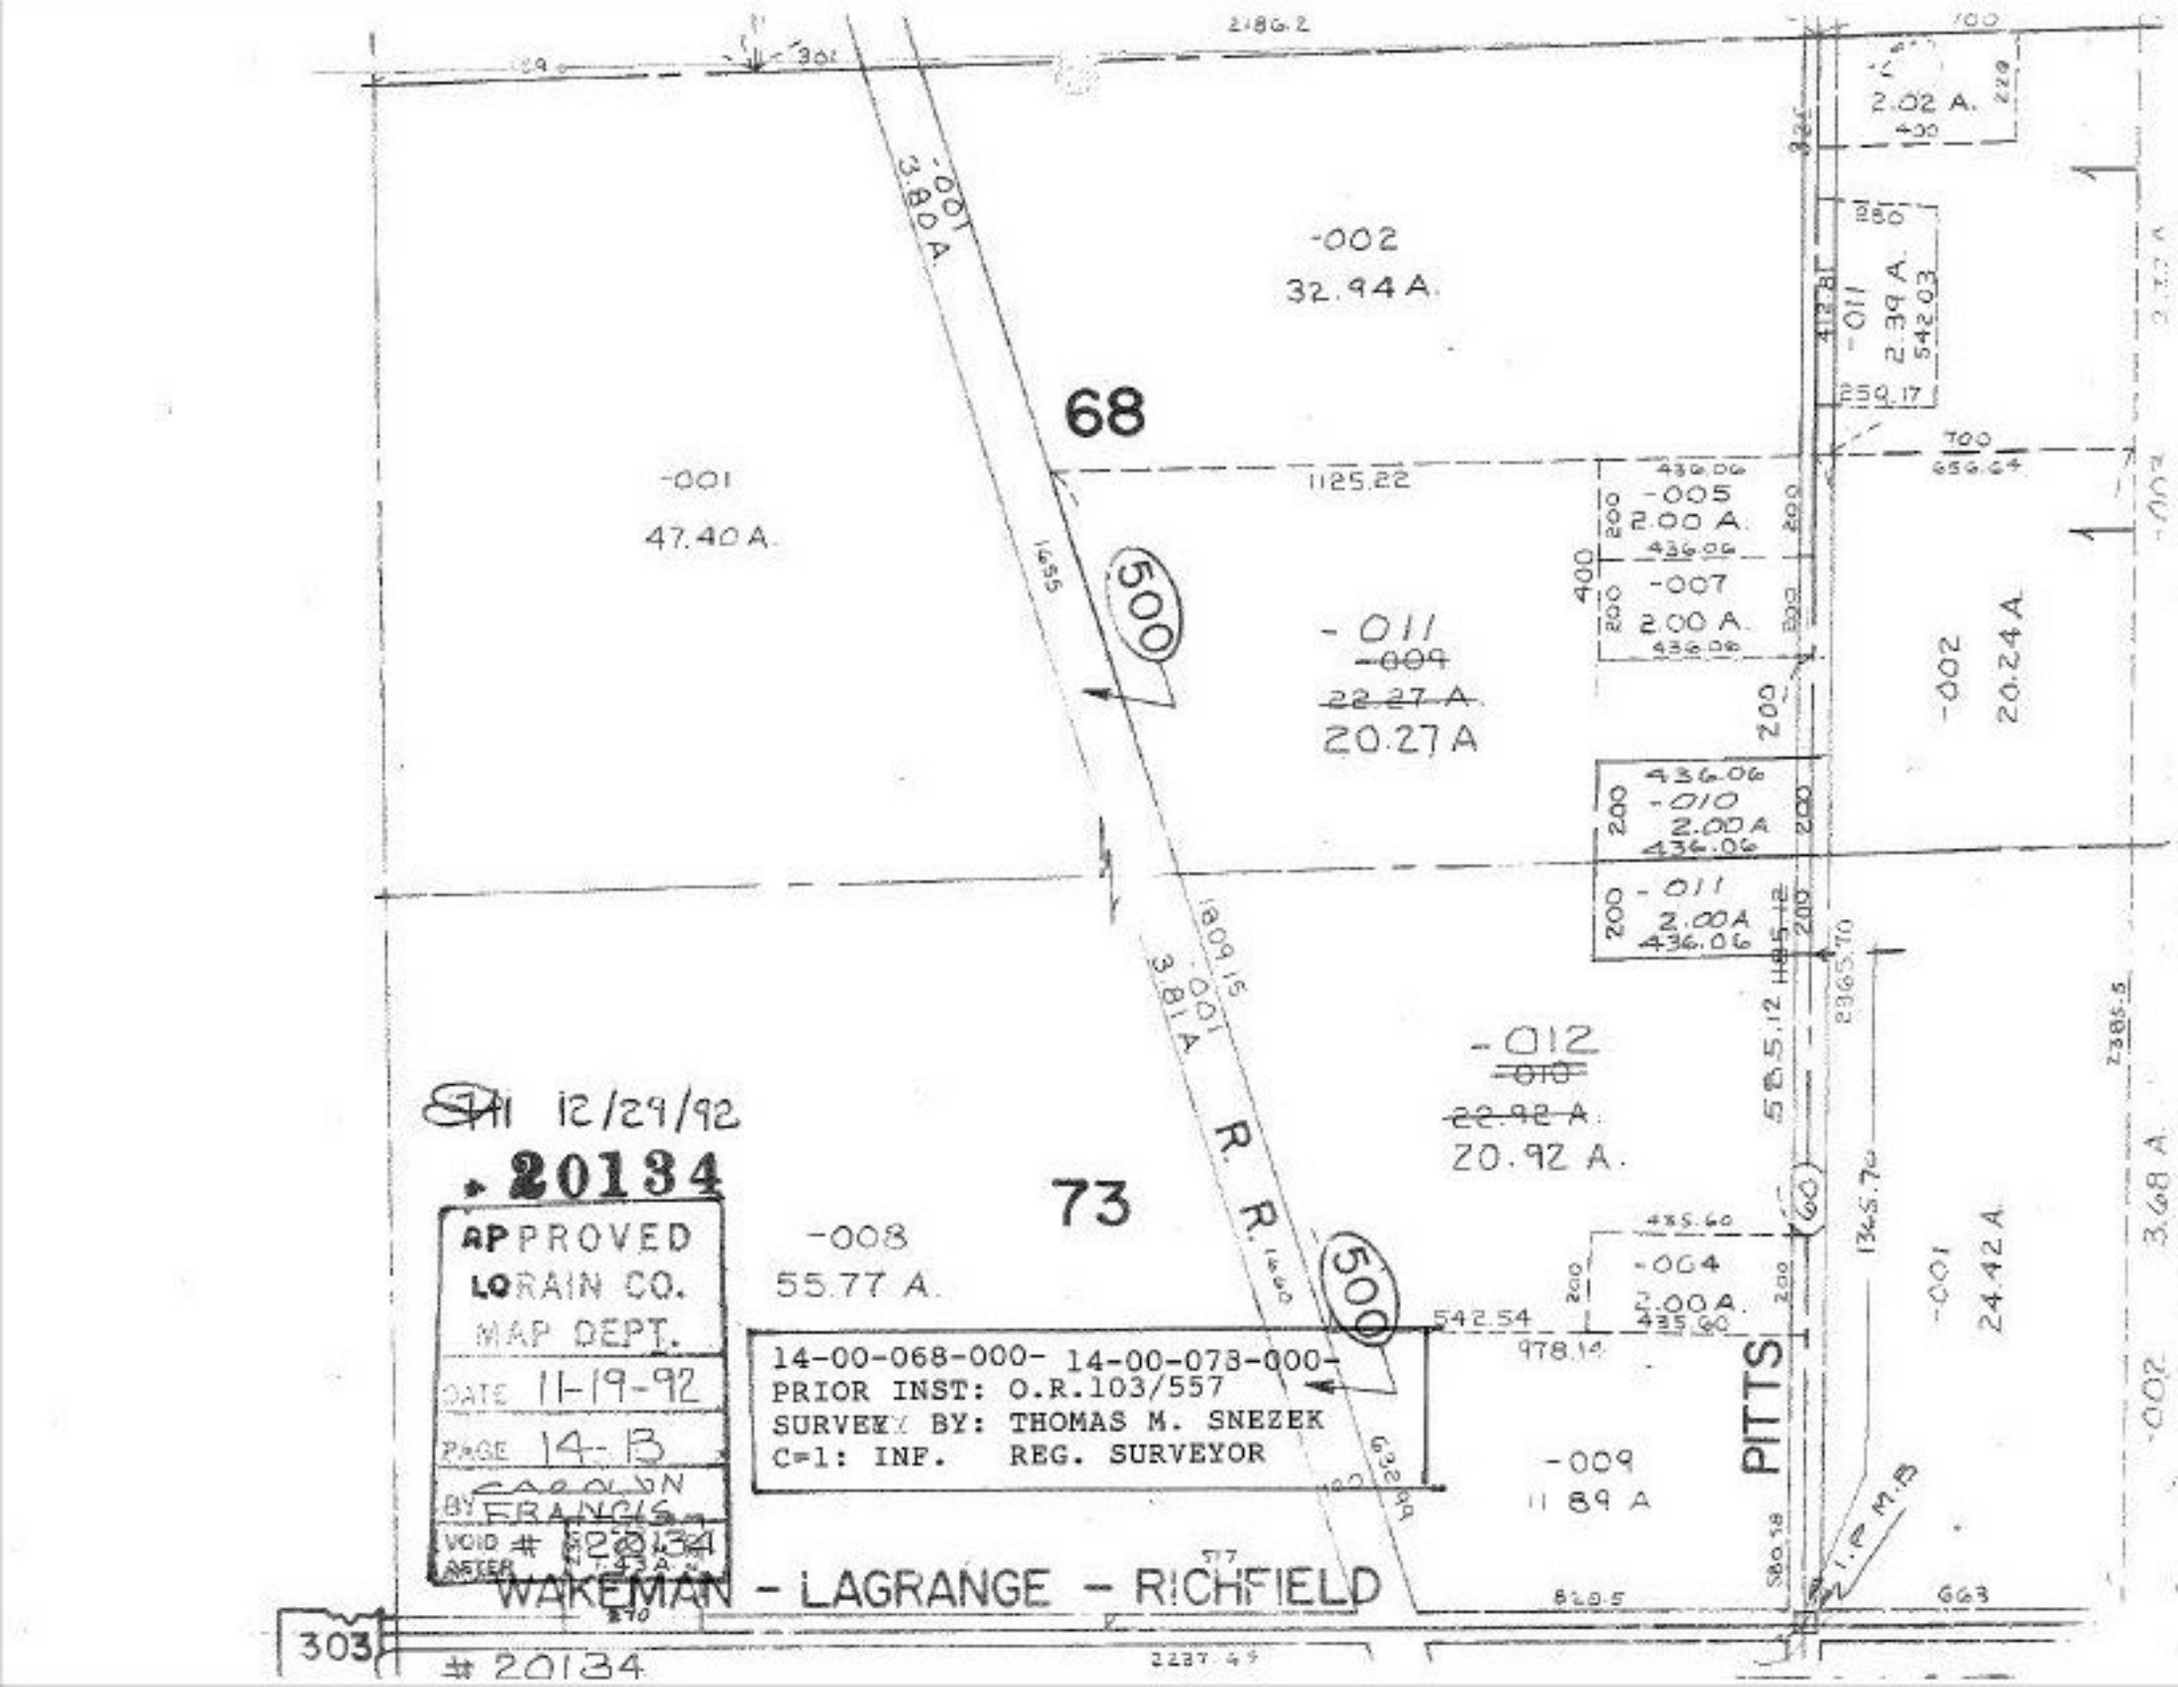
68
73
-001
47.40 A.
-002
32.94 A.
-001
3.80 A.
-011
-009
22.27 A
20.27 A
-005
2.00 A.
-007
2.00 A.
-010
2.00 A.
-011
2.00 A.
-002
20.24 A
-012
-010
22.92 A.
20.92 A.
-008
55.77 A.
-004
2.00 A.
-001
24.42 A.
-009
11.89 A
-011
2.39 A.
2.02 A.
500
R. R.
PITTS
WAKEMAN - LAGRANGE - RICHFIELD
303
1125.22
542.54
978.14
1809.15
2186.2
2287.45
820.5
663
1345.70
2365.70
2385.5
3.68 A.
12/29/92
20134
APPROVED
LORAIN CO.
MAP DEPT.
DATE 11-19-92
PAGE 14-B
BY FRANCIS
VOID # 20134
AFTER 1993
14-00-068-000- 14-00-078-000-
PRIOR INST: O.R.103/557
SURVEYED BY: THOMAS M. SNEZEK
C=1: INF. REG. SURVEYOR
# 20134