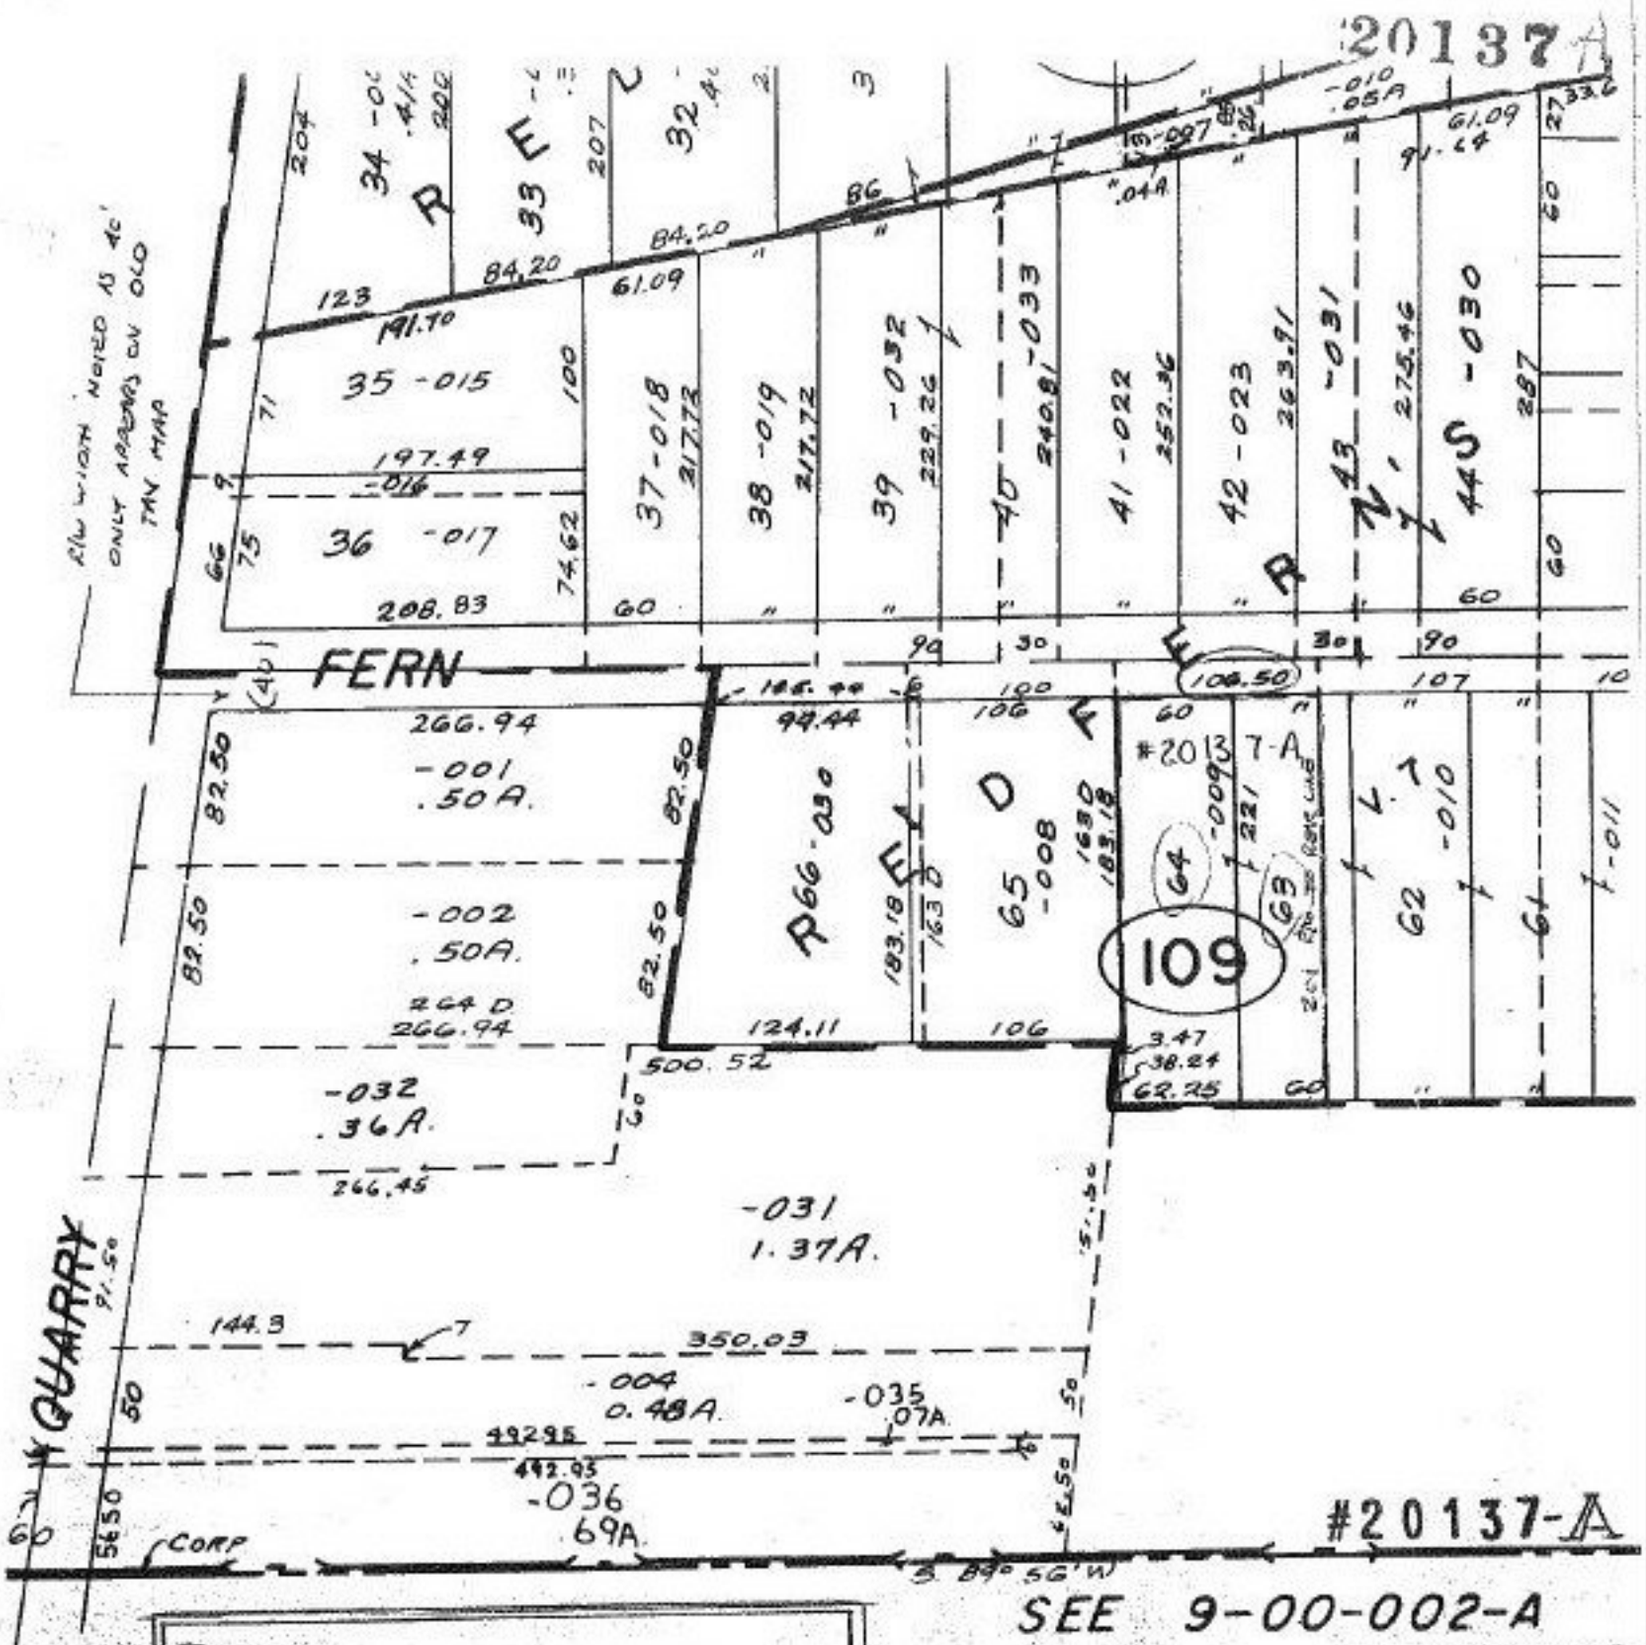

REF. –
P.V. 7 Pg. 53
PLAT REDFERN'S 3RD ALLOT.

DV 682/577

OLD TAX MAP

OR VOL 995, P. 940

PARCEL SIZE CORRECTION

APPROVED
LORAIN CO.
MAP DEPT.

DATE 3-13-95

PAGE 5-00-091-C

BY T. McNair

20137-A