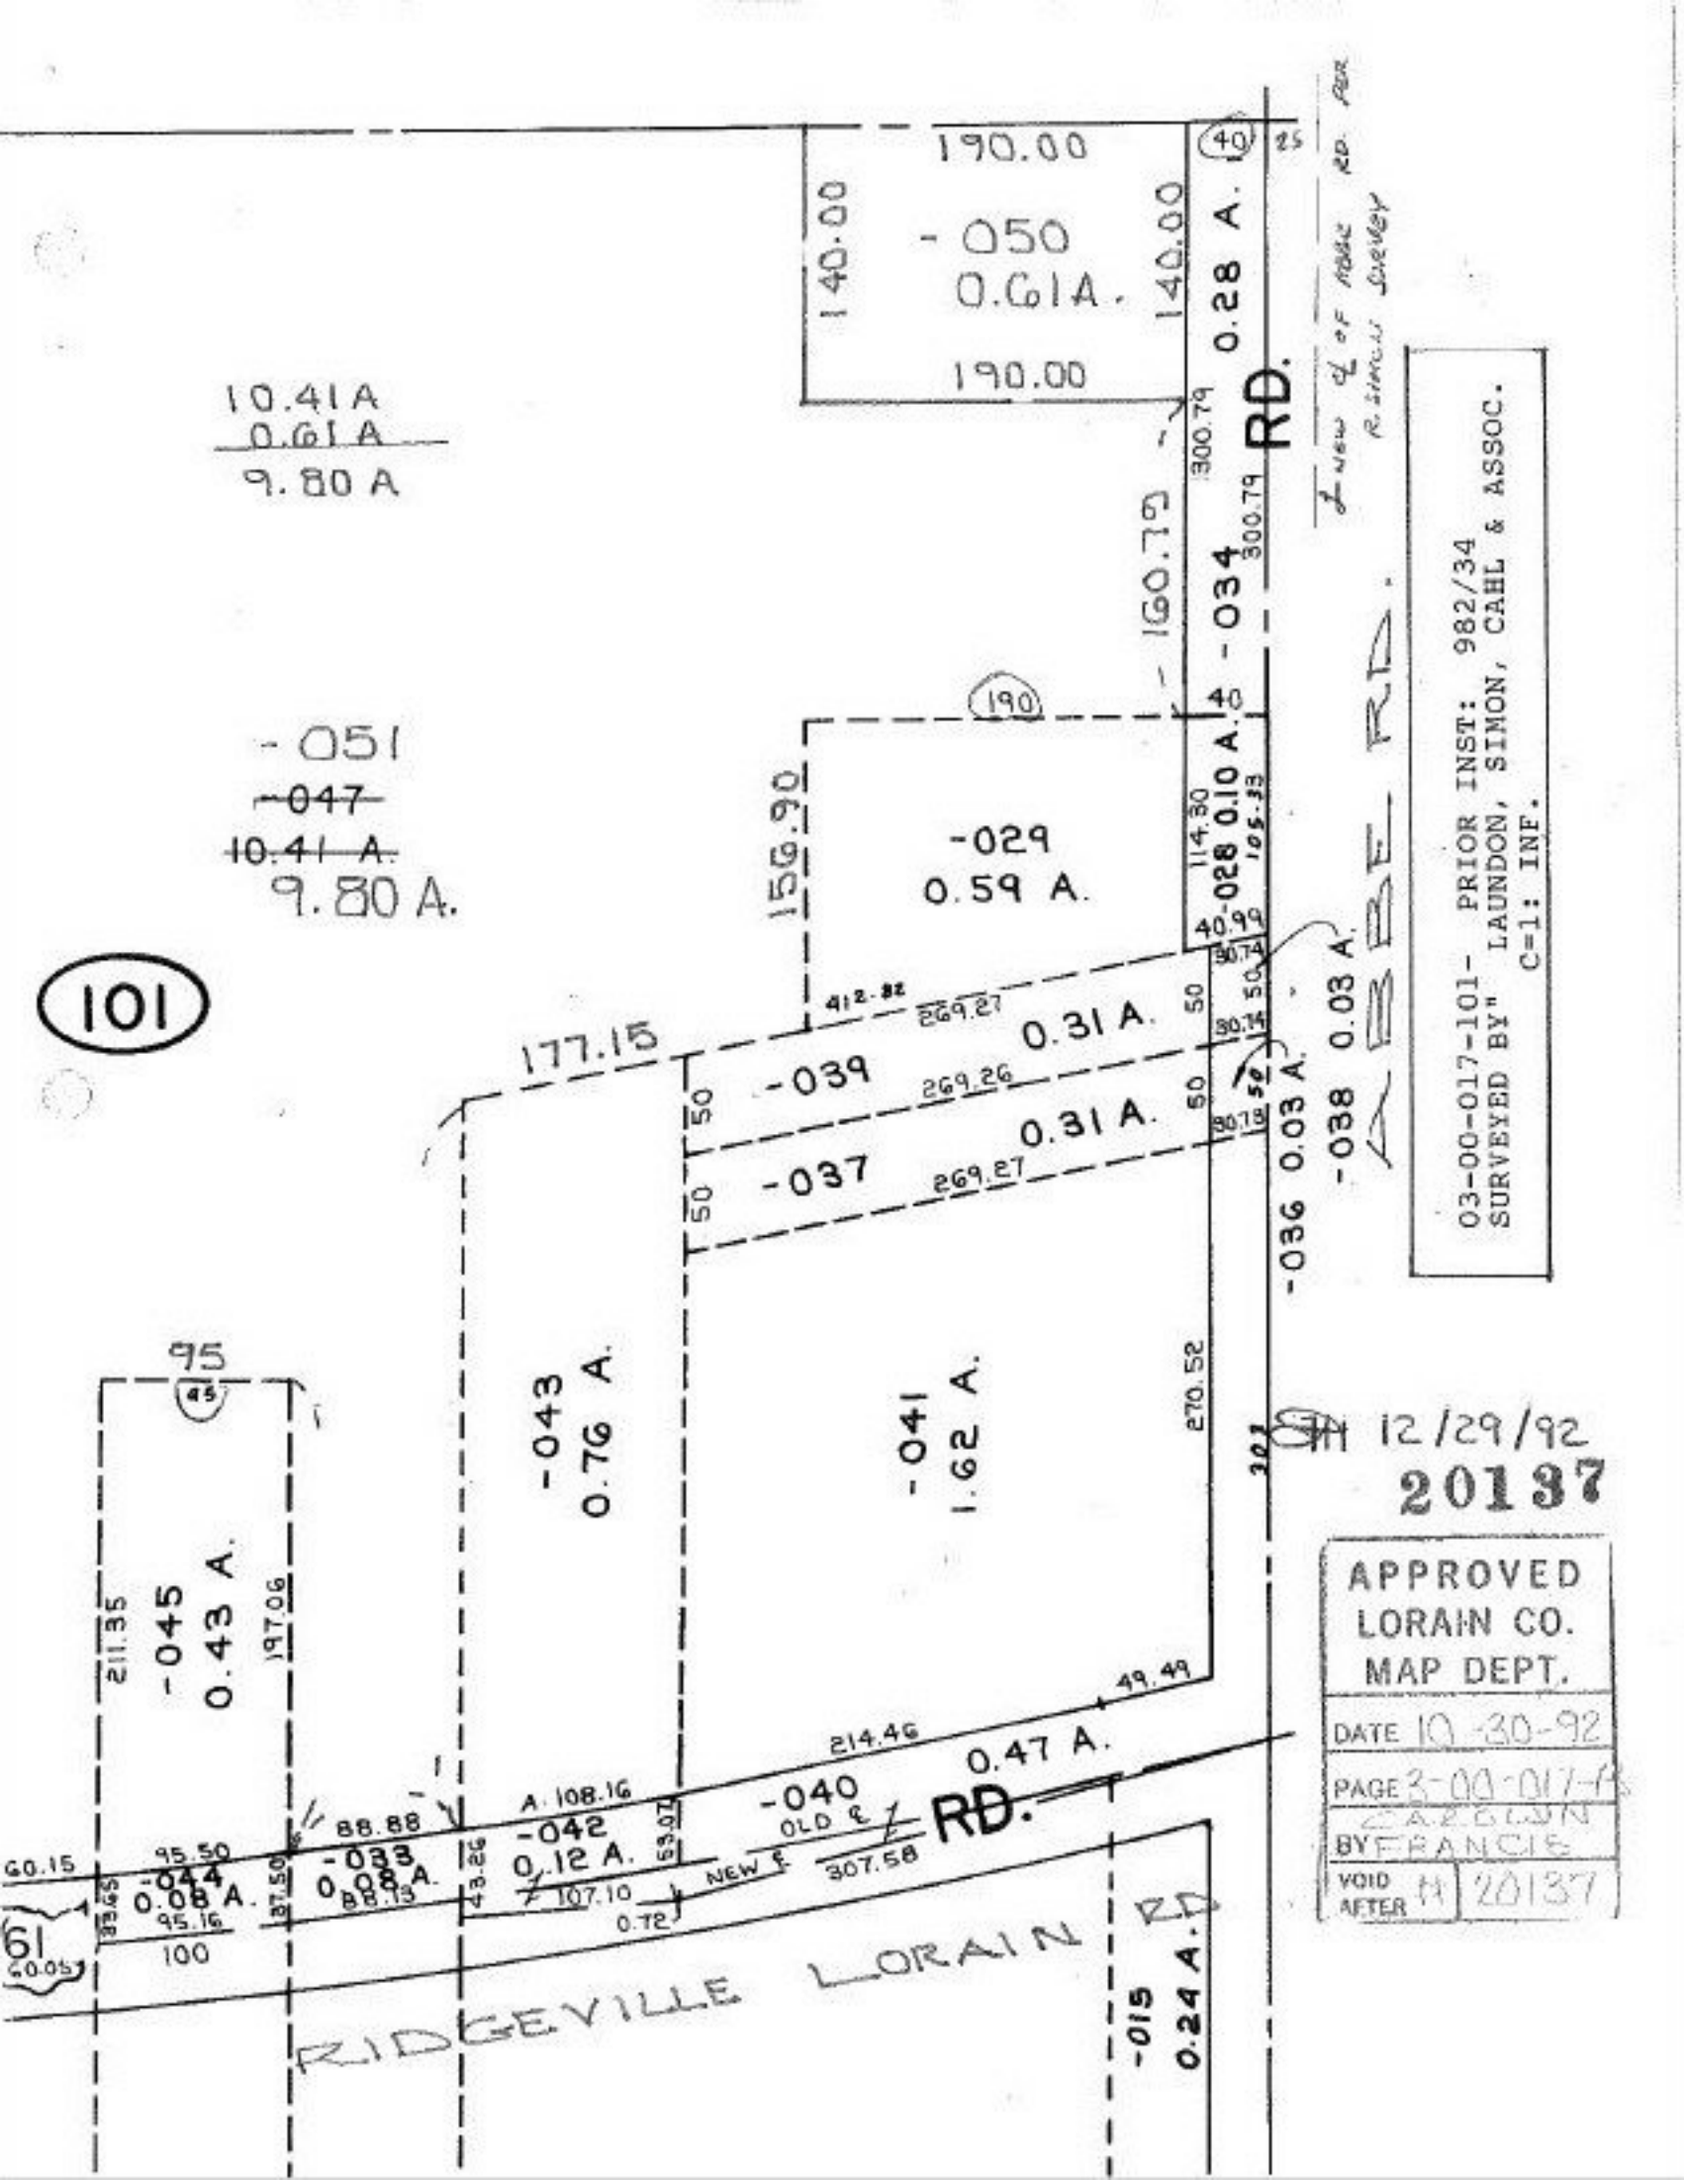
190.00
-050
0.61A.
190.00
140.00
140.00
40
25
0.28 A.
RD.
10.41A
0.61A
9.80 A
300.79
300.79
-034
160.79
190
-051
-047
10.41 A.
9.80 A.
-029
0.59 A.
159.90
114.30
-028 0.10 A.
105.33
40.00
30.74
50
30.74
50
30.78
50
412.82
269.27
177.15
-039
269.26
0.31 A.
-037
269.27
0.31 A.
50
50
50
50
LABREE RD.
-038 0.03 A.
-036 0.03 A.
101
95
45
-043
0.76 A.
-041
1.62 A.
270.52
211.35
-045
0.43 A.
197.06
49.49
214.46
0.47 A.
A. 108.16
-042
0.12 A.
53.97
-040
OLD ℄
RD.
NEW ℄
307.58
0.72
88.88
107.10
60.15
95.50
-044
0.08 A.
89.45
95.16
100
-033
0.08 A.
88.13
43.26
37.50
61
50.05
RIDGEVILLE LORAIN RD.
-015
0.24 A.
12/29/92
20137
APPROVED
LORAIN CO.
MAP DEPT.
DATE 10-30-92
PAGE 3-00-017-F
BY FRANCIS
VOID AFTER 11 20137