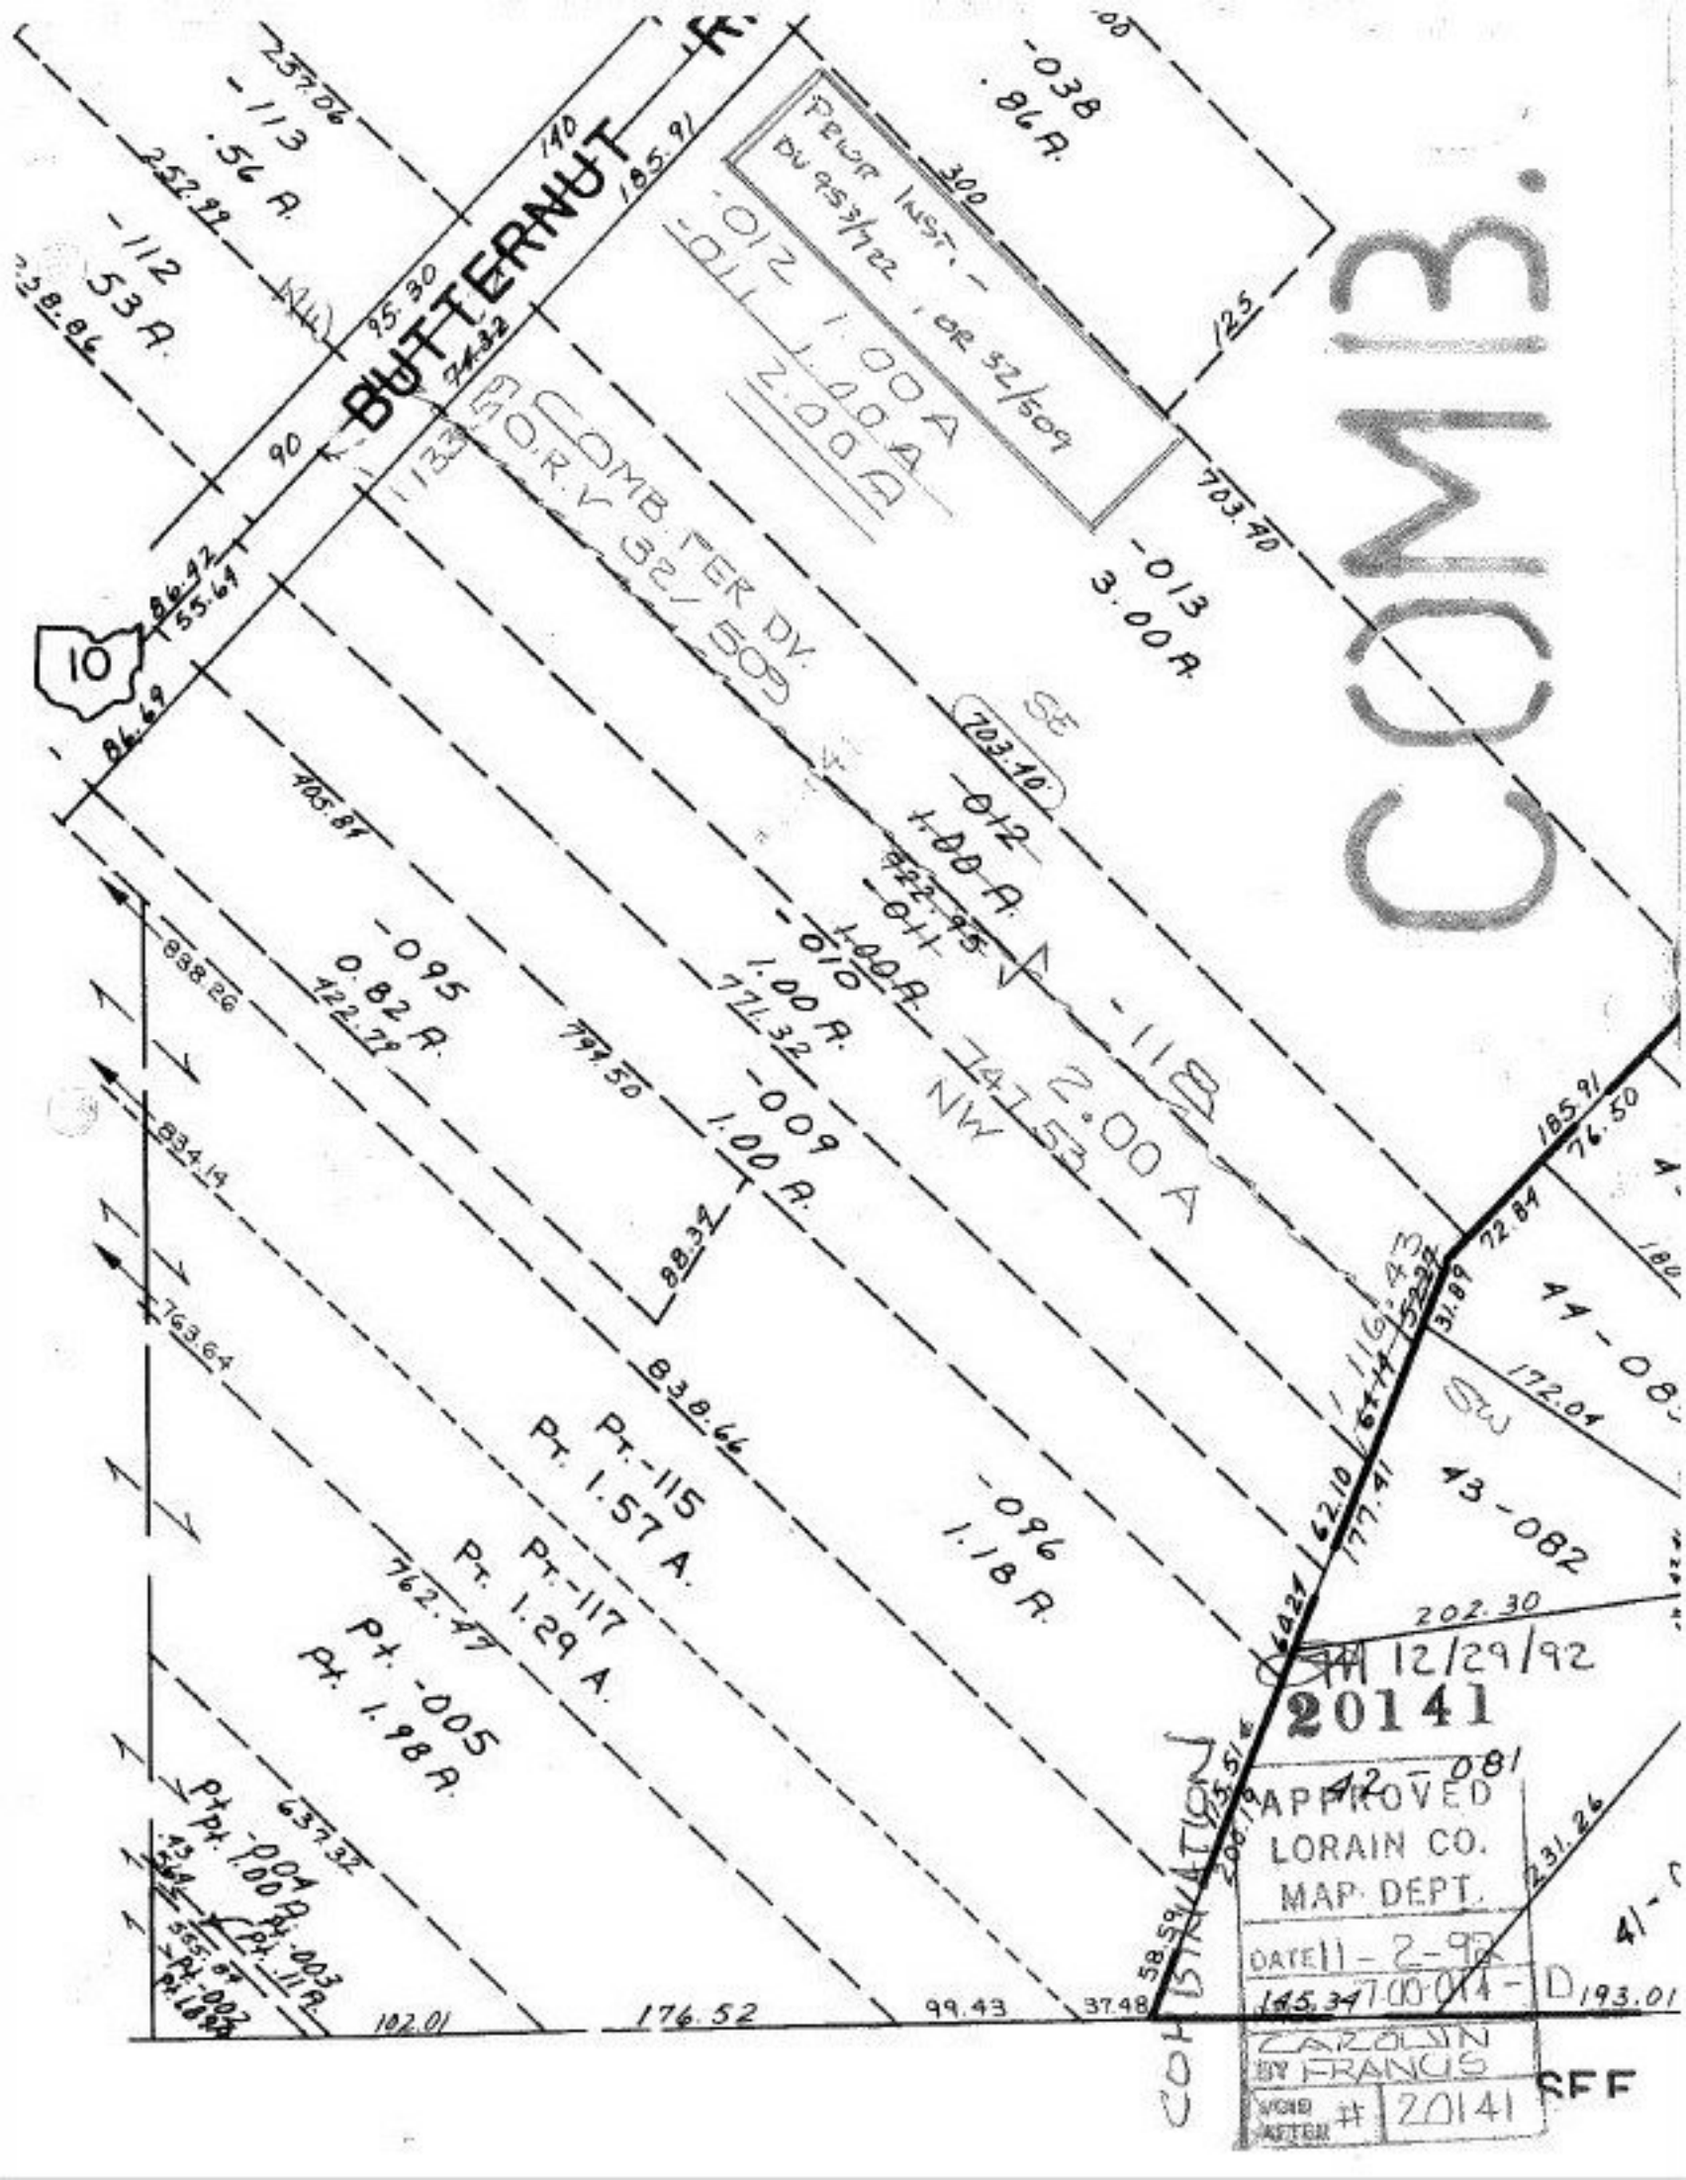

BUTTERNUT
COMB. PER DV.
O.R.V. 32/509
PRIOR INST. - DV 953/722, OR 32/509
-038
.86 A.
-012
1.00 A
-011
1.00 A
2.00 A
-013
3.00 A.
-012
1.00 A.
-011
1.00 A.
-010
1.00 A.
-009
1.00 A.
-095
0.82 A.
-118
2.00 A
747.53
NW
-096
1.18 A.
Pt.-115
Pt. 1.57 A.
Pt.-117
Pt. 1.29 A.
Pt. -005
Pt. 1.98 A.
-004
Pt. 1.00 A.
Pt. -003
Pt. -002
Pt. 1.88 A.
-113
.56 A.
-112
.53 A.
10
COM13.
12/29/92
20141
APPROVED
LORAIN CO.
MAP DEPT.
DATE 11-2-92
7-00-014-D
CAROLYN
BY FRANCIS
VOID AFTER # 20141
COMBINATION
SEE