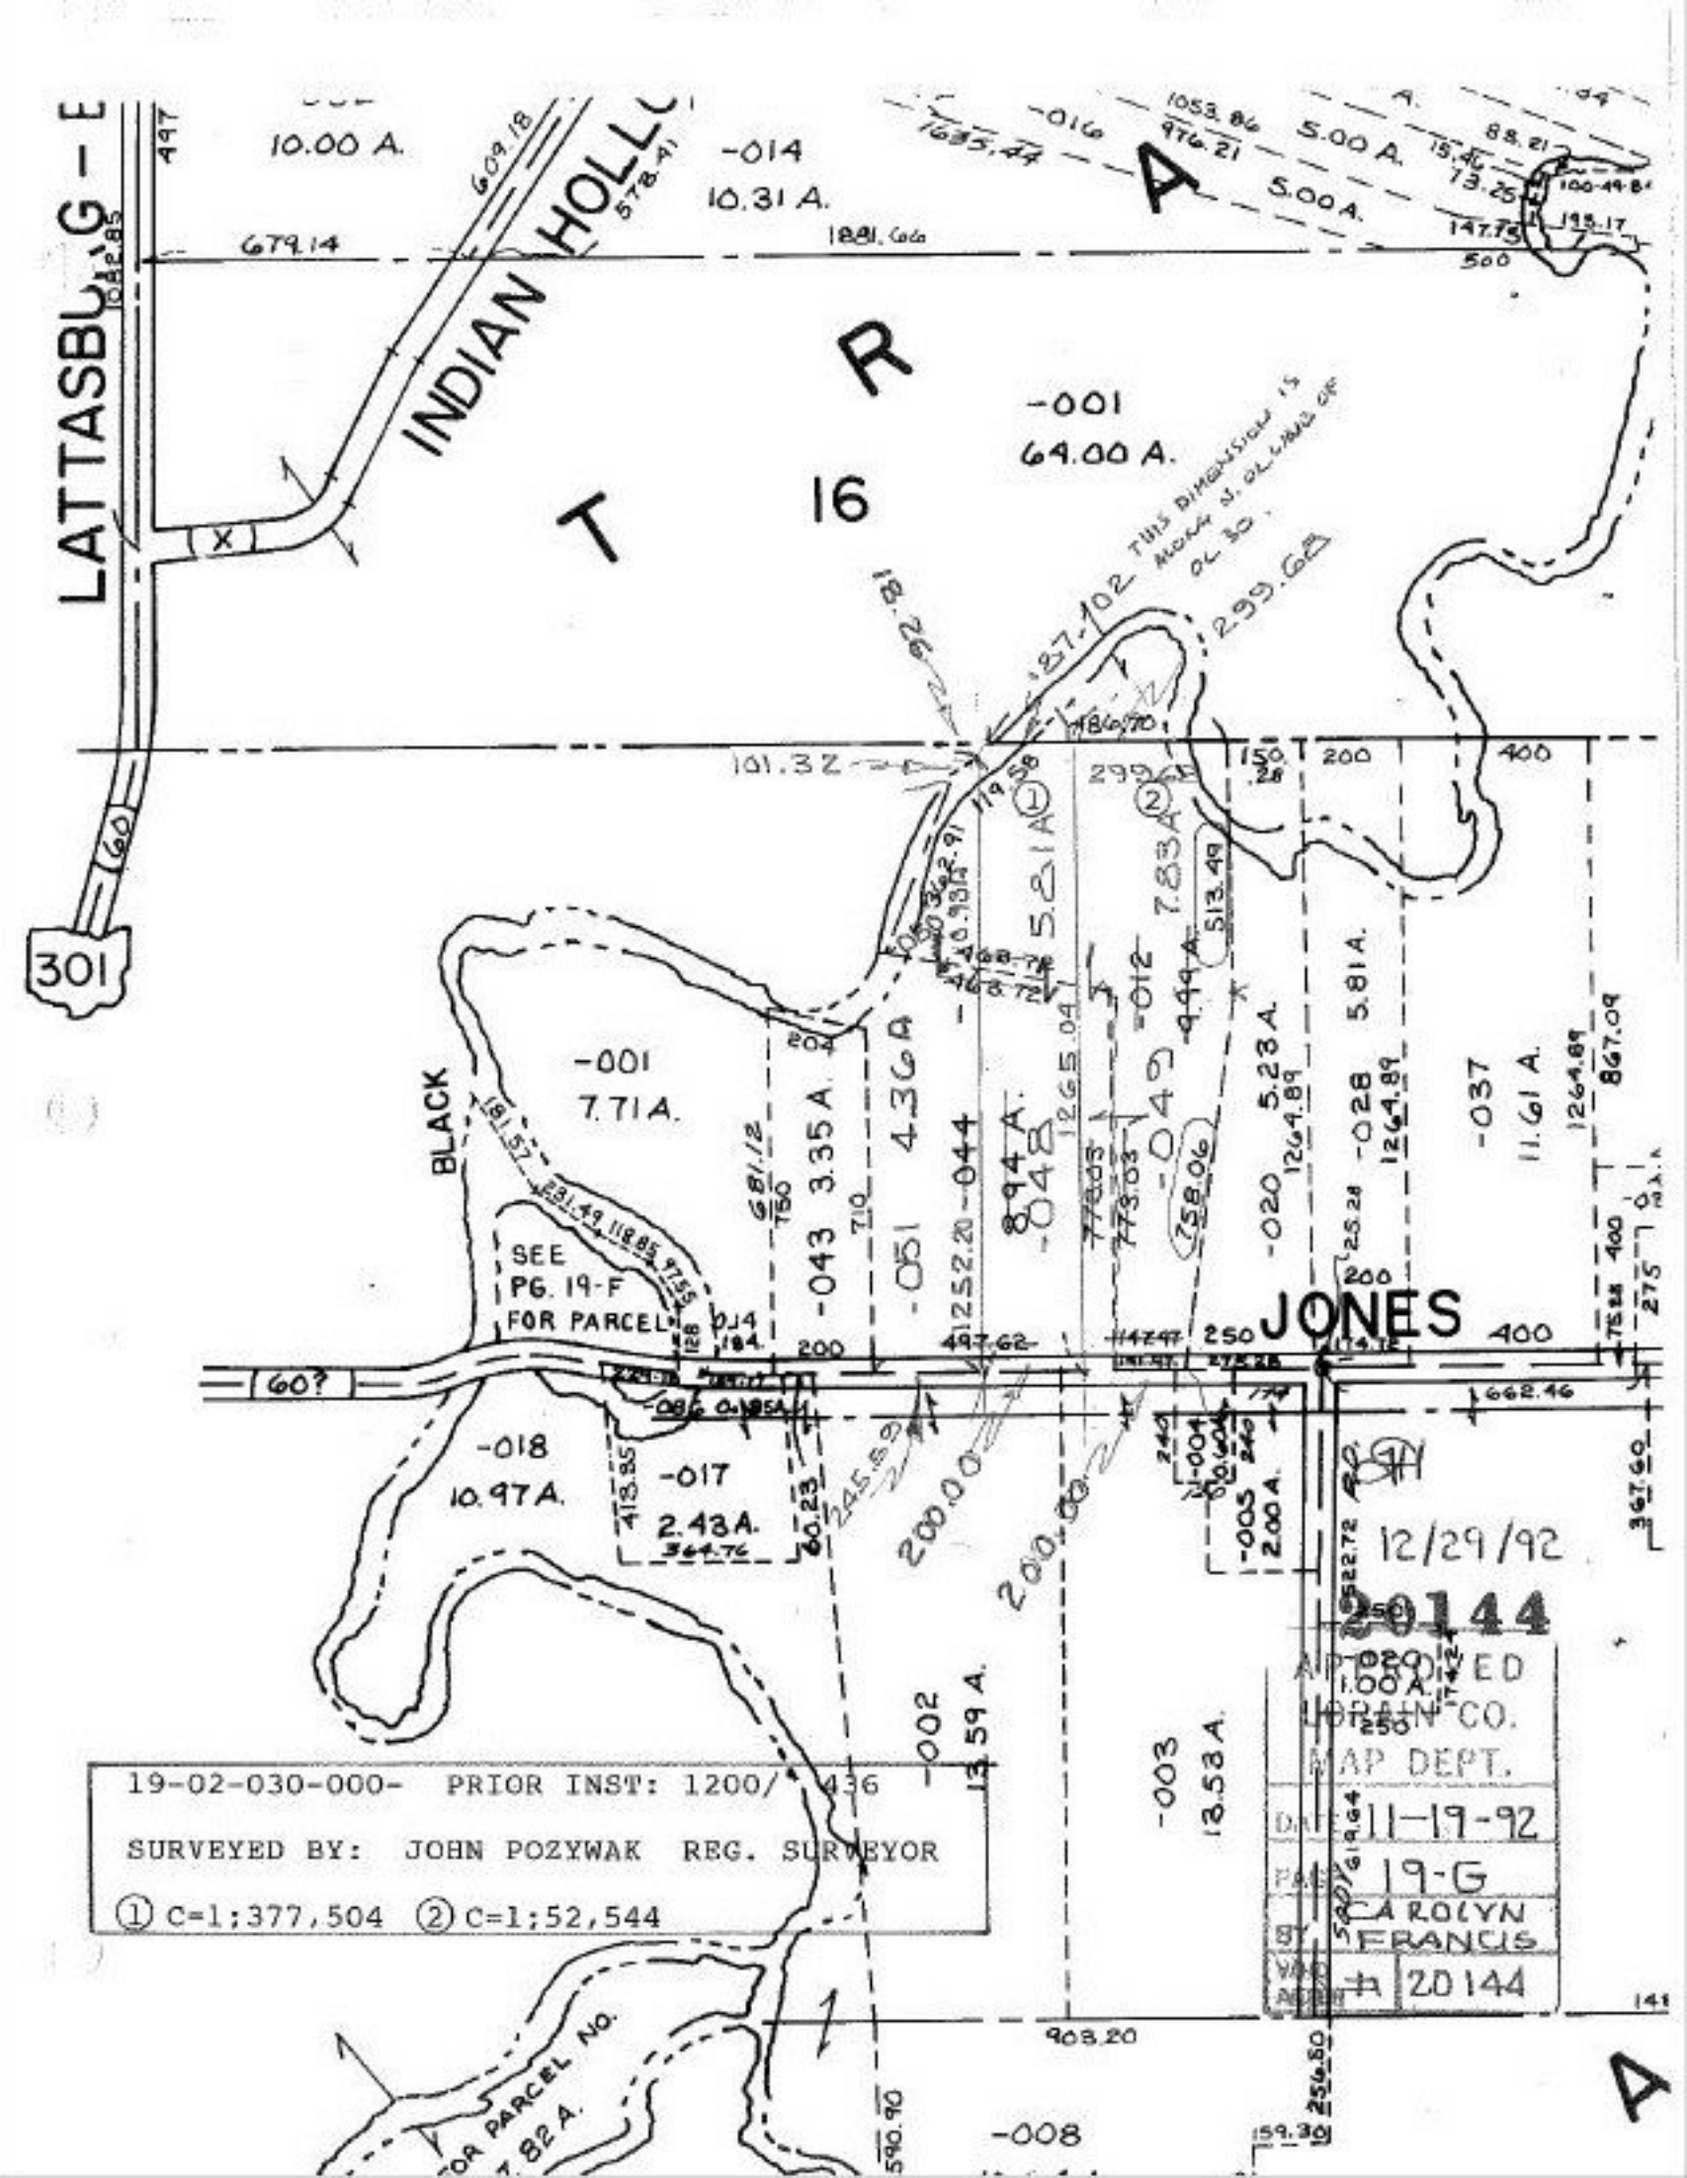
LATTASBURG - E
INDIAN HOLLO
T 16 R
10.00 A.
-014
10.31 A.
-001
64.00 A.
5.00 A.
5.00 A.
679.14
1881.66
497
609.18
578.41
1683.44
1053.86
976.21
88.21
15.46
73.25
147.75
195.17
500
100-44-8
101.32
187.102
299.68
92.81
119.58
513.49
7.83A
5.23A
5.81A
-001
7.71A.
-043 3.35A.
-044
-051 4.30A.
-048 8.94A.
-012 4.44A.
-045
-020 5.23A.
-028 5.81A.
-037 11.61A.
BLACK
SEE PG. 19-F FOR PARCEL
JONES
60?
-018
10.97A.
-017
2.43A.
-002
13.59A.
-003
13.58A.
200.00
200.00
662.46
867.09
1264.89
1252.20
758.06
773.03
760.05
12/29/92
20144
APPROVED
LORAIN CO.
MAP DEPT.
11-19-92
19-G
CAROLYN
FRANCIS
20144
19-02-030-000- PRIOR INST: 1200/ 436
SURVEYED BY: JOHN POZYWAK REG. SURVEYOR
① C=1;377,504 ② C=1;52,544
903.20
256.50
-008