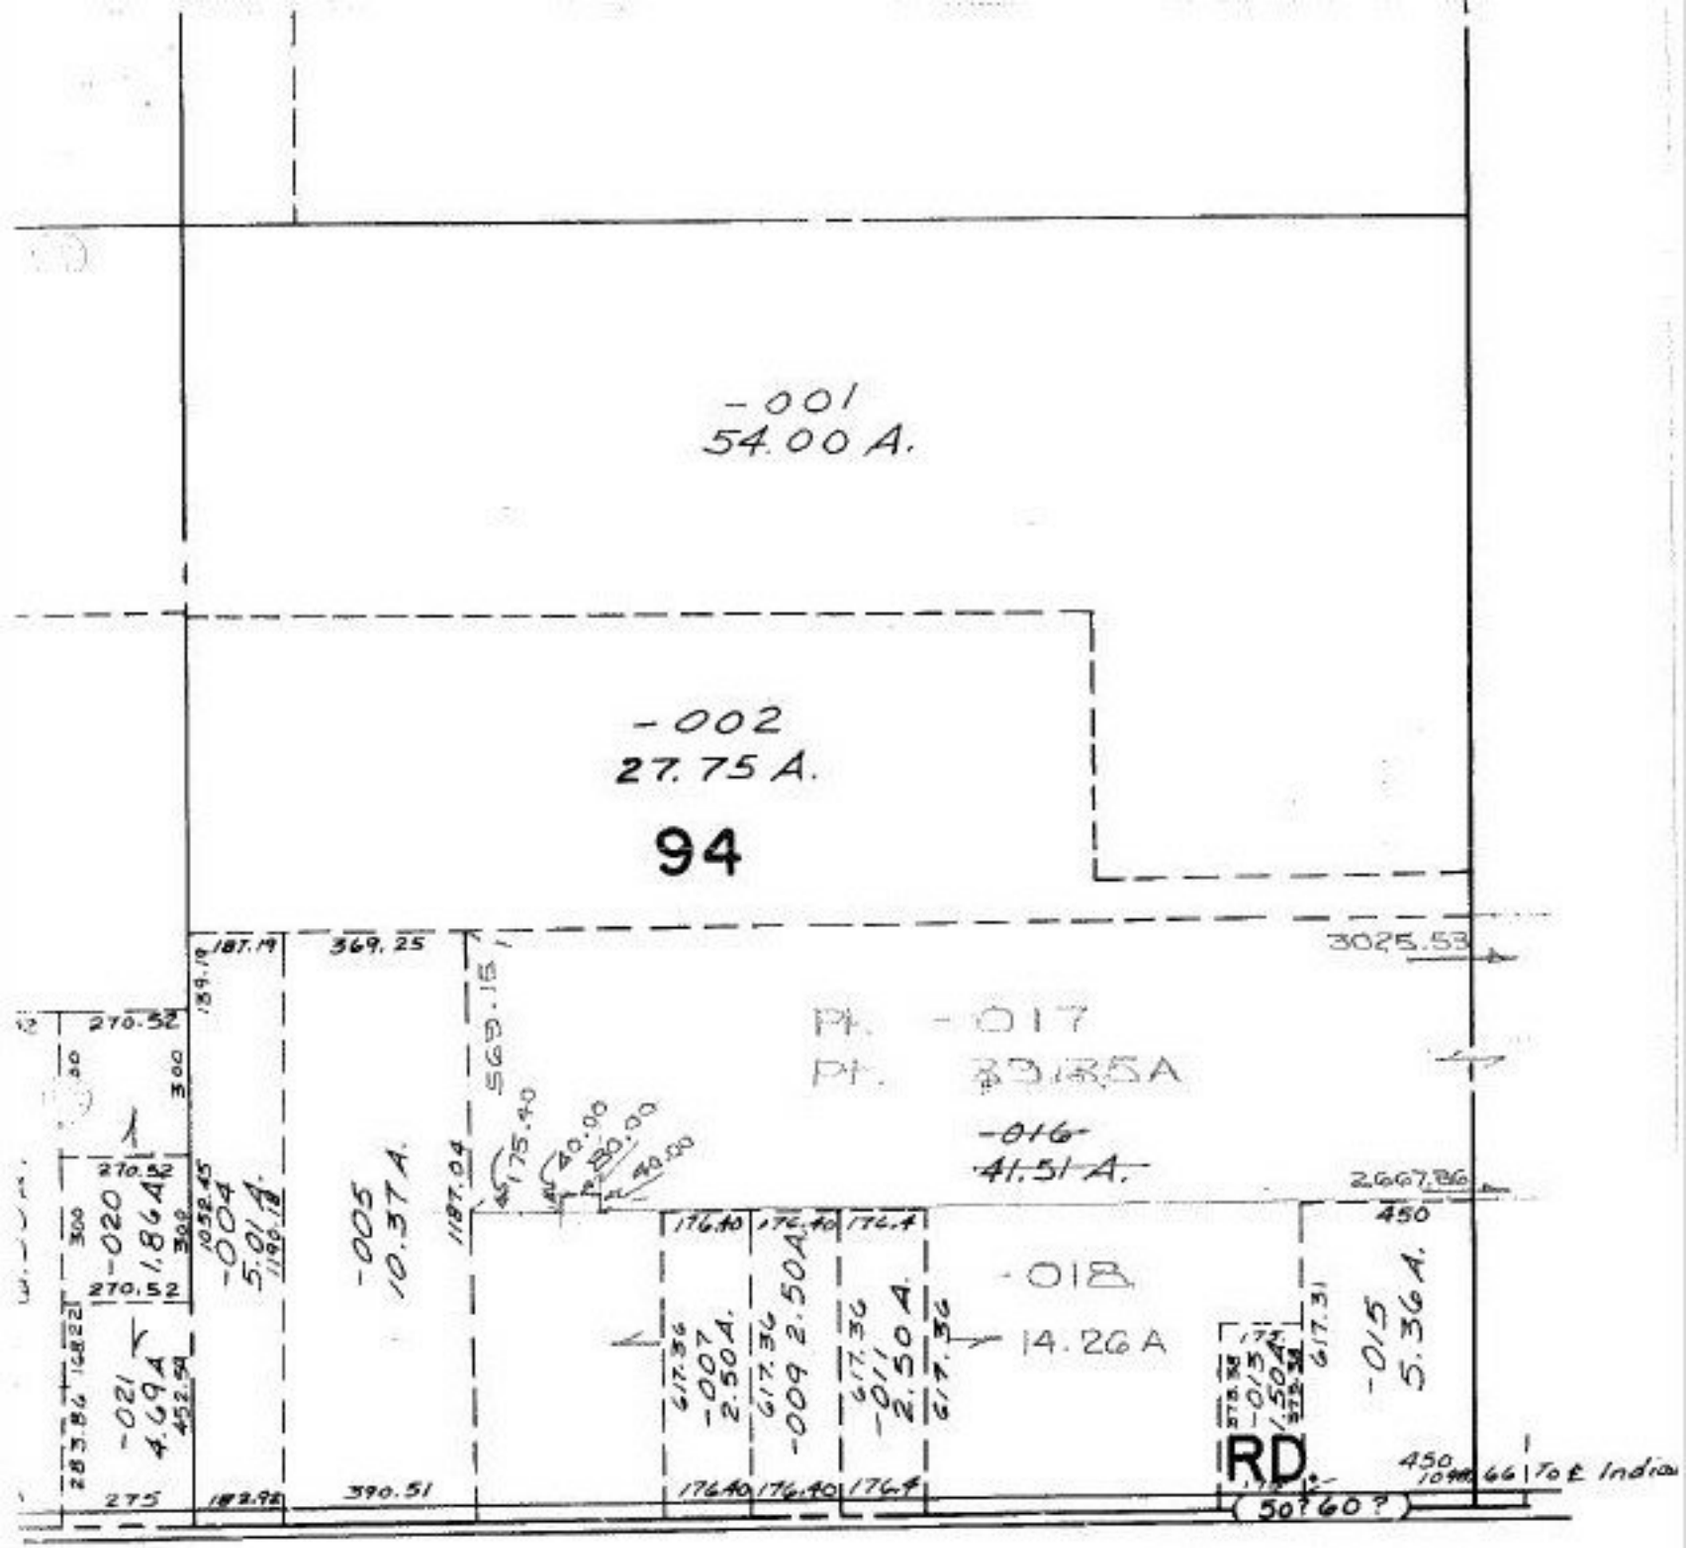

SH 12/29/92

20146

15-00-093-000- 15-00-094-000-
SURVEYED BY: LAUNDON, SIMON, CAHL & ASSOC.
PRIOR INST: 1114/723 O.R.387/43
C=1:483,287

APPROVED
LORAIN CO.
MAP DEPT.
DATE 11-16-92
PAGE 15-G
CAROLYN
BY FRANCIS
WORK ORDER # 20146

3