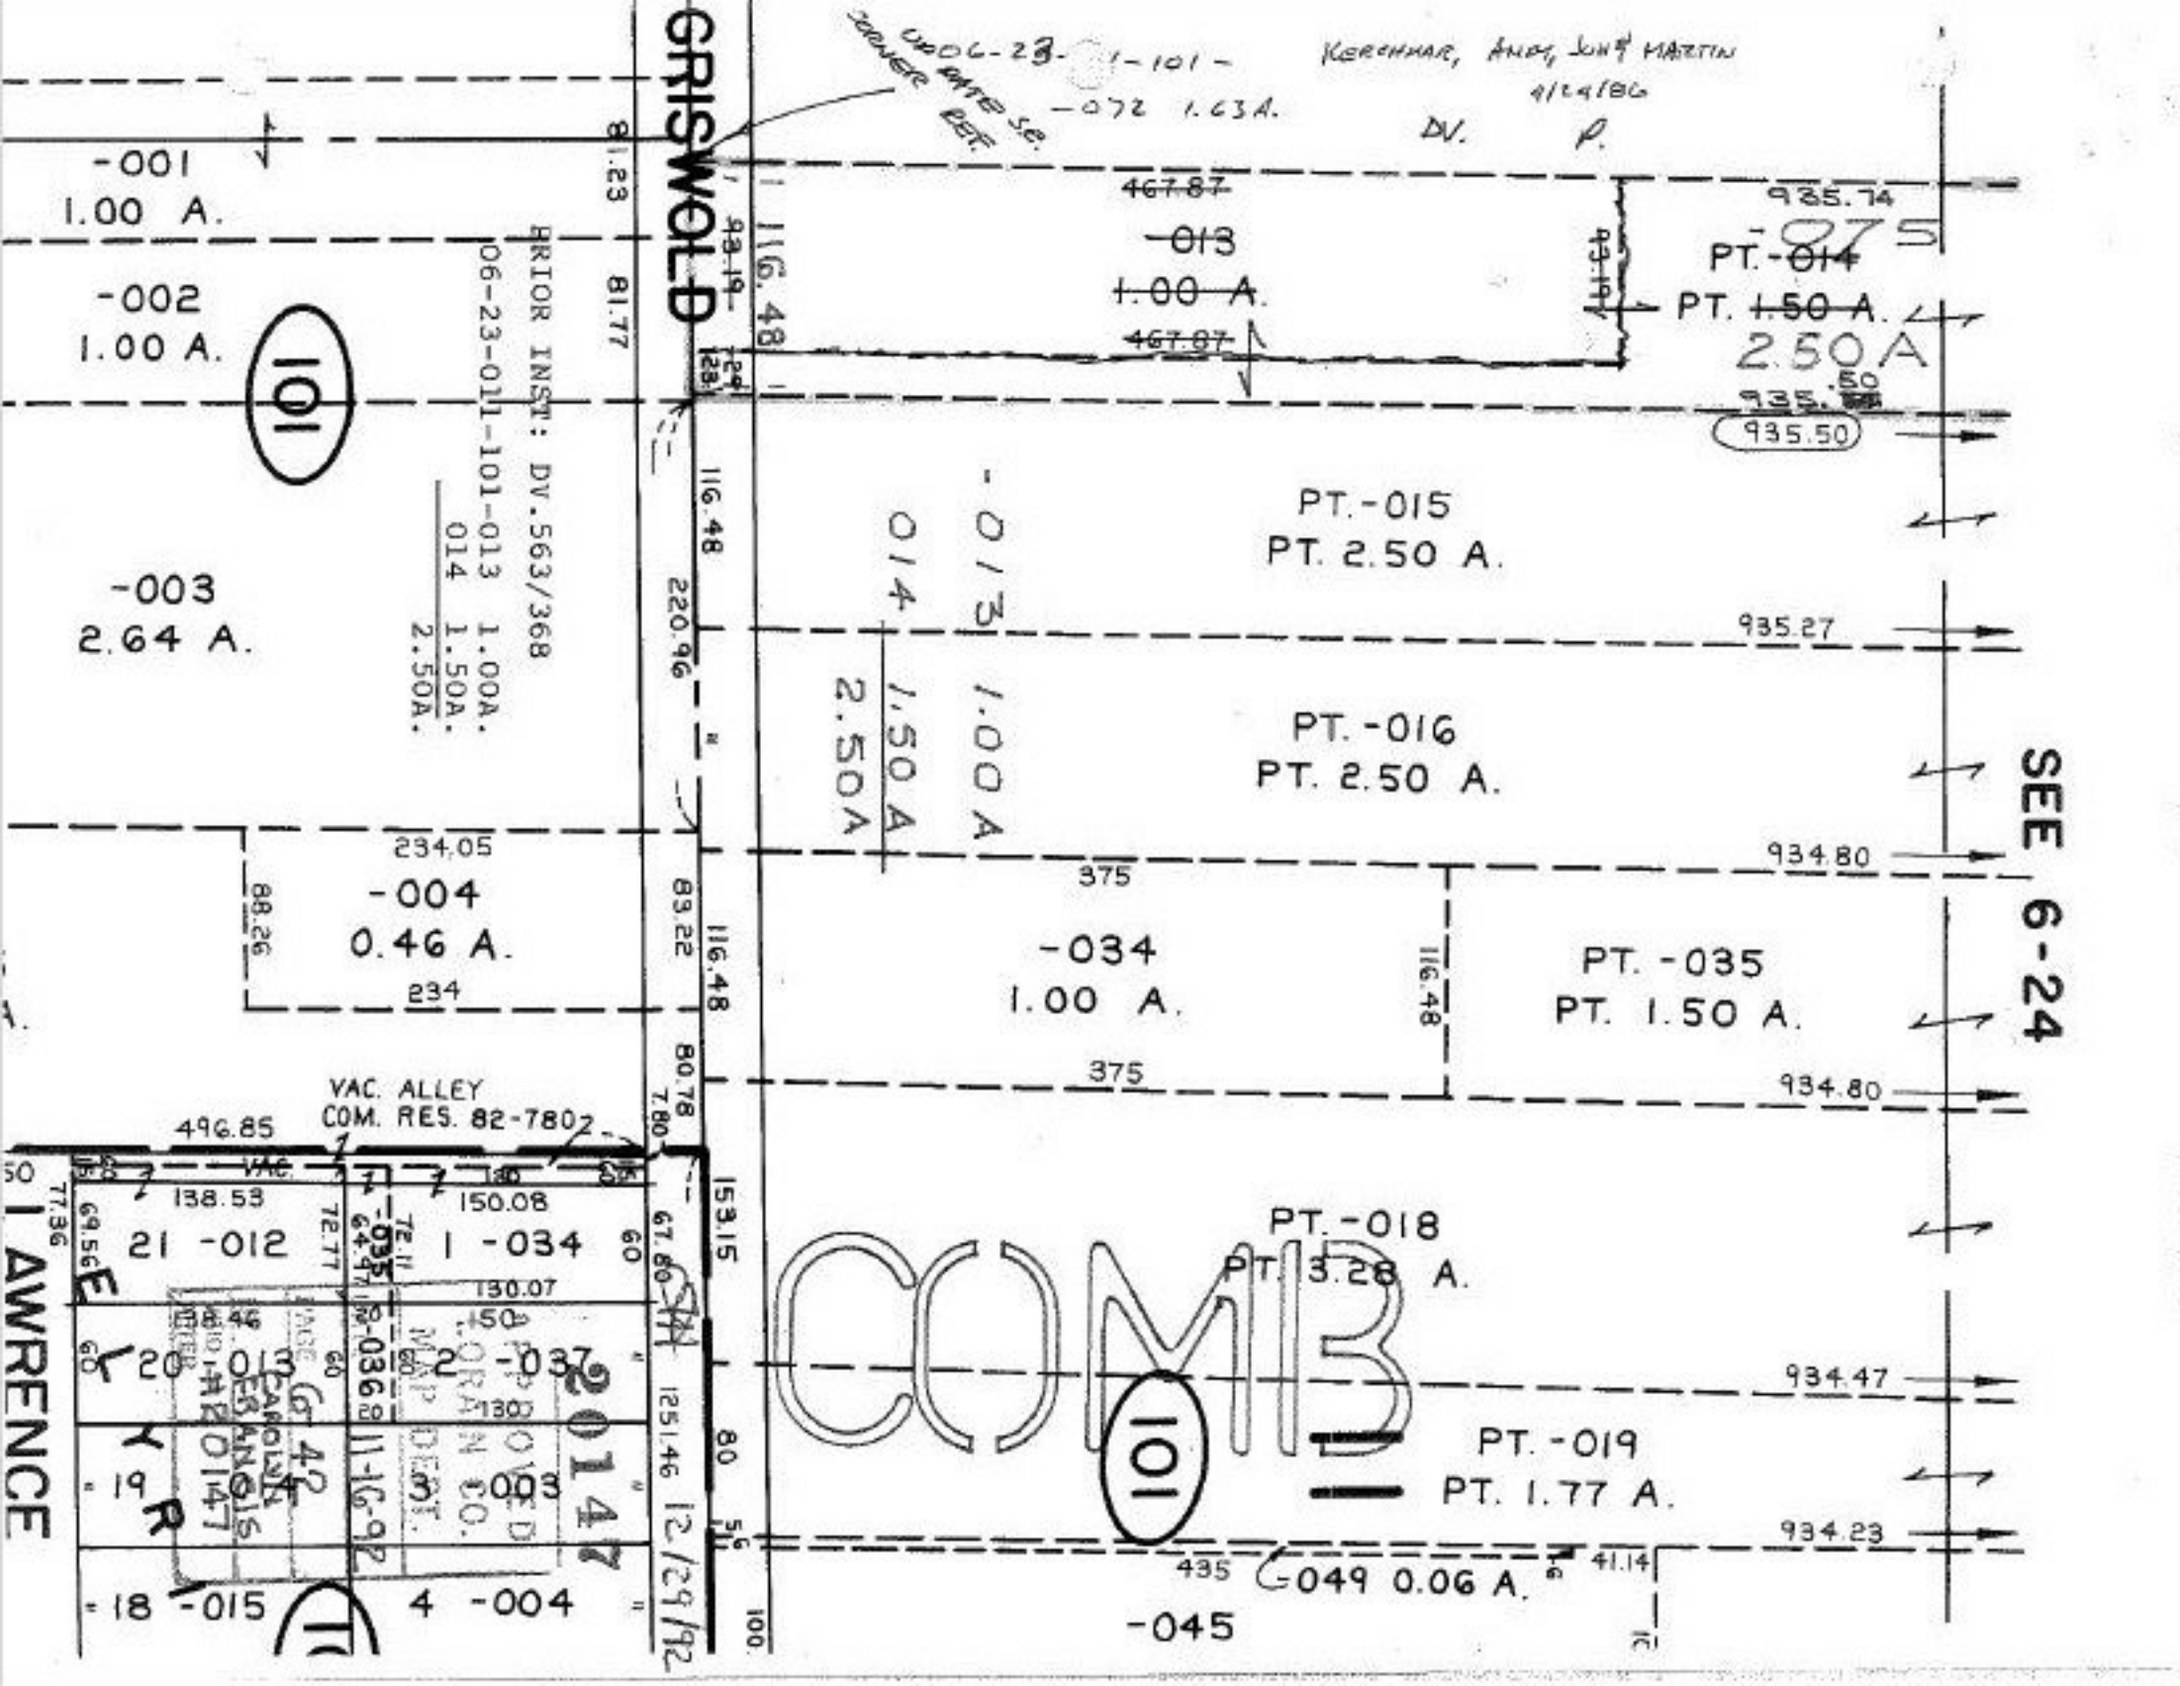
GRISWOLD
LAWRENCE
-001
1.00 A.
-002
1.00 A.
-003
2.64 A.
101
PRIOR INST: DV. 563/368
06-23-011-101-013 1.00A.
014 1.50A.
2.50A.
-004
0.46 A.
234.05
234
88.26
VAC. ALLEY
COM. RES. 82-7802
496.85
81.23
81.77
116.48
220.96
83.22
80.78
7.80
-013
1.00 A.
467.87
-014
1.50 A.
2.50A
935.74
935.50
PT.-015
PT. 2.50 A.
935.27
PT.-016
PT. 2.50 A.
934.80
-034
1.00 A.
375
PT.-035
PT. 1.50 A.
PT.-018
PT. 3.28 A.
934.47
PT.-019
PT. 1.77 A.
934.23
-049 0.06 A.
-045
41.14
435
COMB
101
SEE 6-24
138.53
150.08
130.07
125.46
153.15
67.60
72.77
72.11
64.47
21 -012
1 -034
20 -013
2 -037
19 -014
3 -036
18 -015
4 -004
11-16-92
12/29/92
20147
APPROVED
LORAIN CO.
MAP DEPT.
PAGE OF
PLAT BOOK
PAGE
RECORDS
LORAIN COUNTY
OHIO