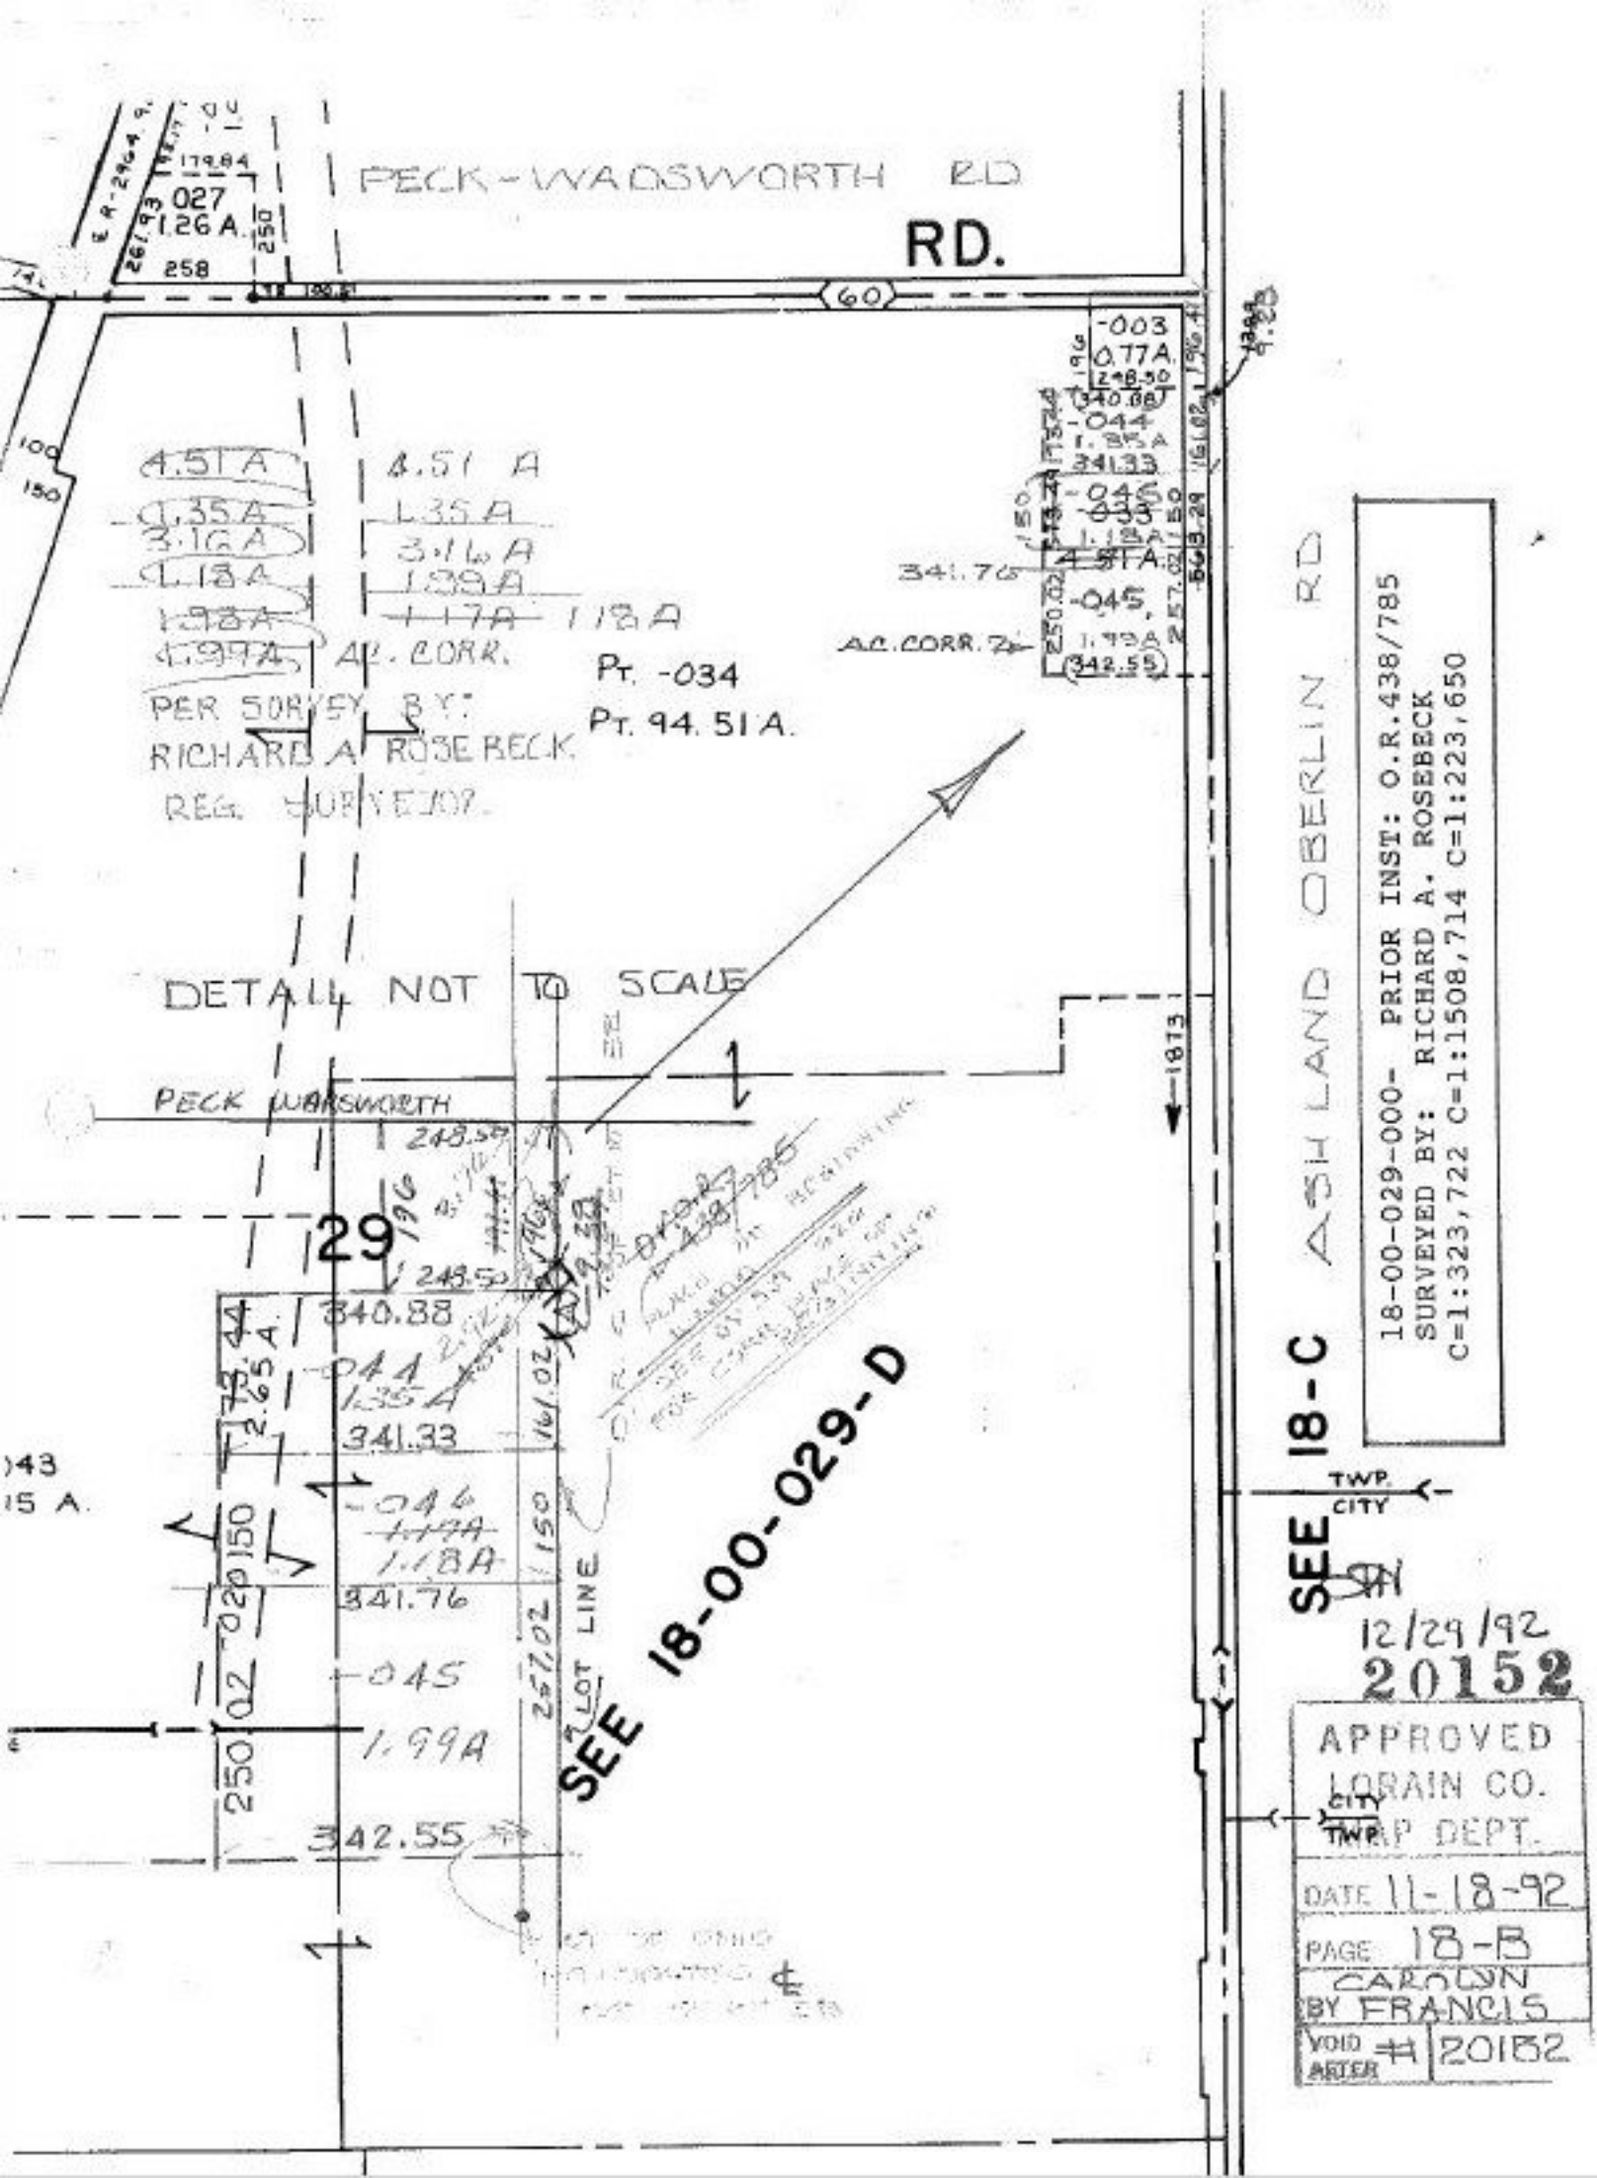
PECK-WADSWORTH RD
RD.
60
027
1.26 A.
258
179.84
261.93
250
-003
0.77A.
298.50
340.88
-044
1.35A
341.33
-046
1.18A
341.76
-045
1.99A
342.55
4.51 A
1.35 A
3.16 A
1.99 A
1.18 A
AL. CORR.
PT. -034
PT. 94.51 A.
PER SURVEY BY:
RICHARD A. ROSEBECK
REG. SURVEYOR.
DETAIL NOT TO SCALE
PECK WADSWORTH
29
248.59
340.88
341.33
341.76
342.55
257.02
161.02
150
250
SEE 18-00-029-D
LOT LINE
ASH LAND
OBERLIN RD
18-00-029-000- PRIOR INST: O.R.438/785
SURVEYED BY: RICHARD A. ROSEBECK
C=1:323,722 C=1:1508,714 C=1:223,650
SEE 18-C
TWP.
CITY
12/29/92
20152
APPROVED
LORAIN CO.
MAP DEPT.
DATE 11-18-92
PAGE 18-B
CAROLYN
BY FRANCIS
VOID AFTER #1
20152