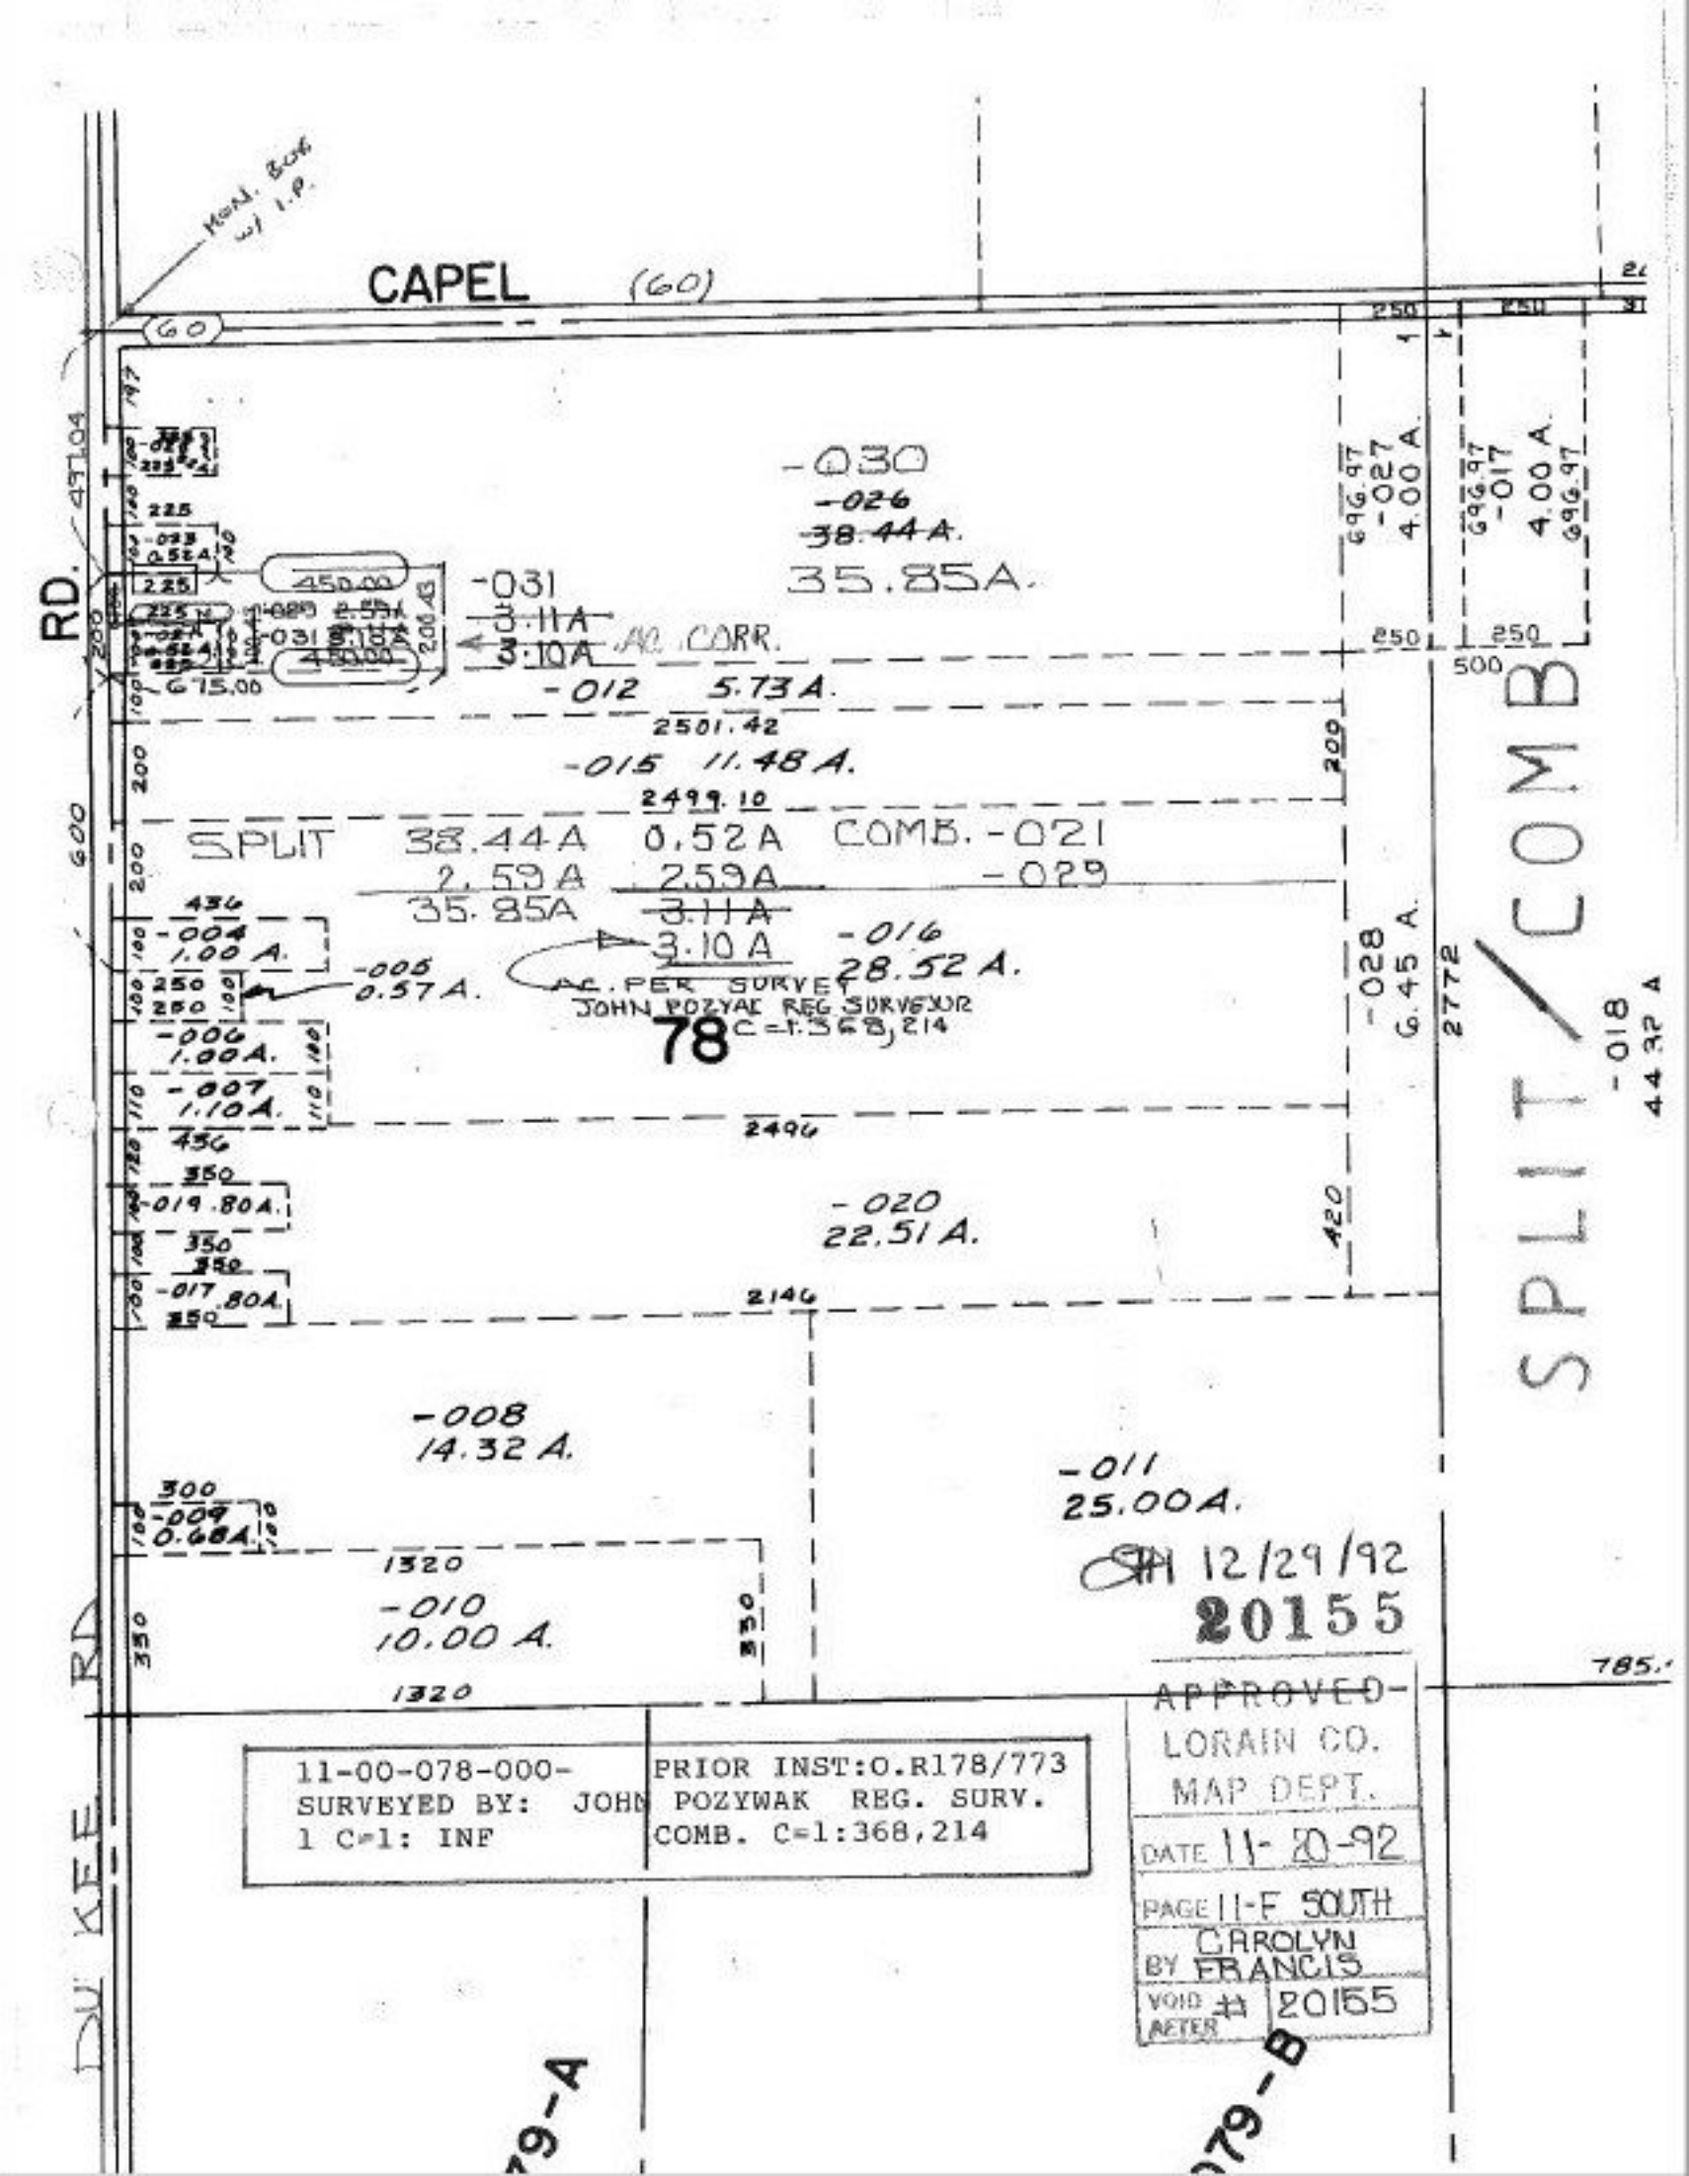

11-00-078-000-
SURVEYED BY: JOHN POZYWAK REG. SURV.
1 C=1: INF

PRIOR INST: O.R178/773
COMB. C=1:368,214

APPROVED
LORAIN CO.
MAP DEPT.
DATE 11-20-92
PAGE 11-F SOUTH
BY CAROLYN FRANCIS
VOID AFTER # 20155

SH 12/29/92
20155