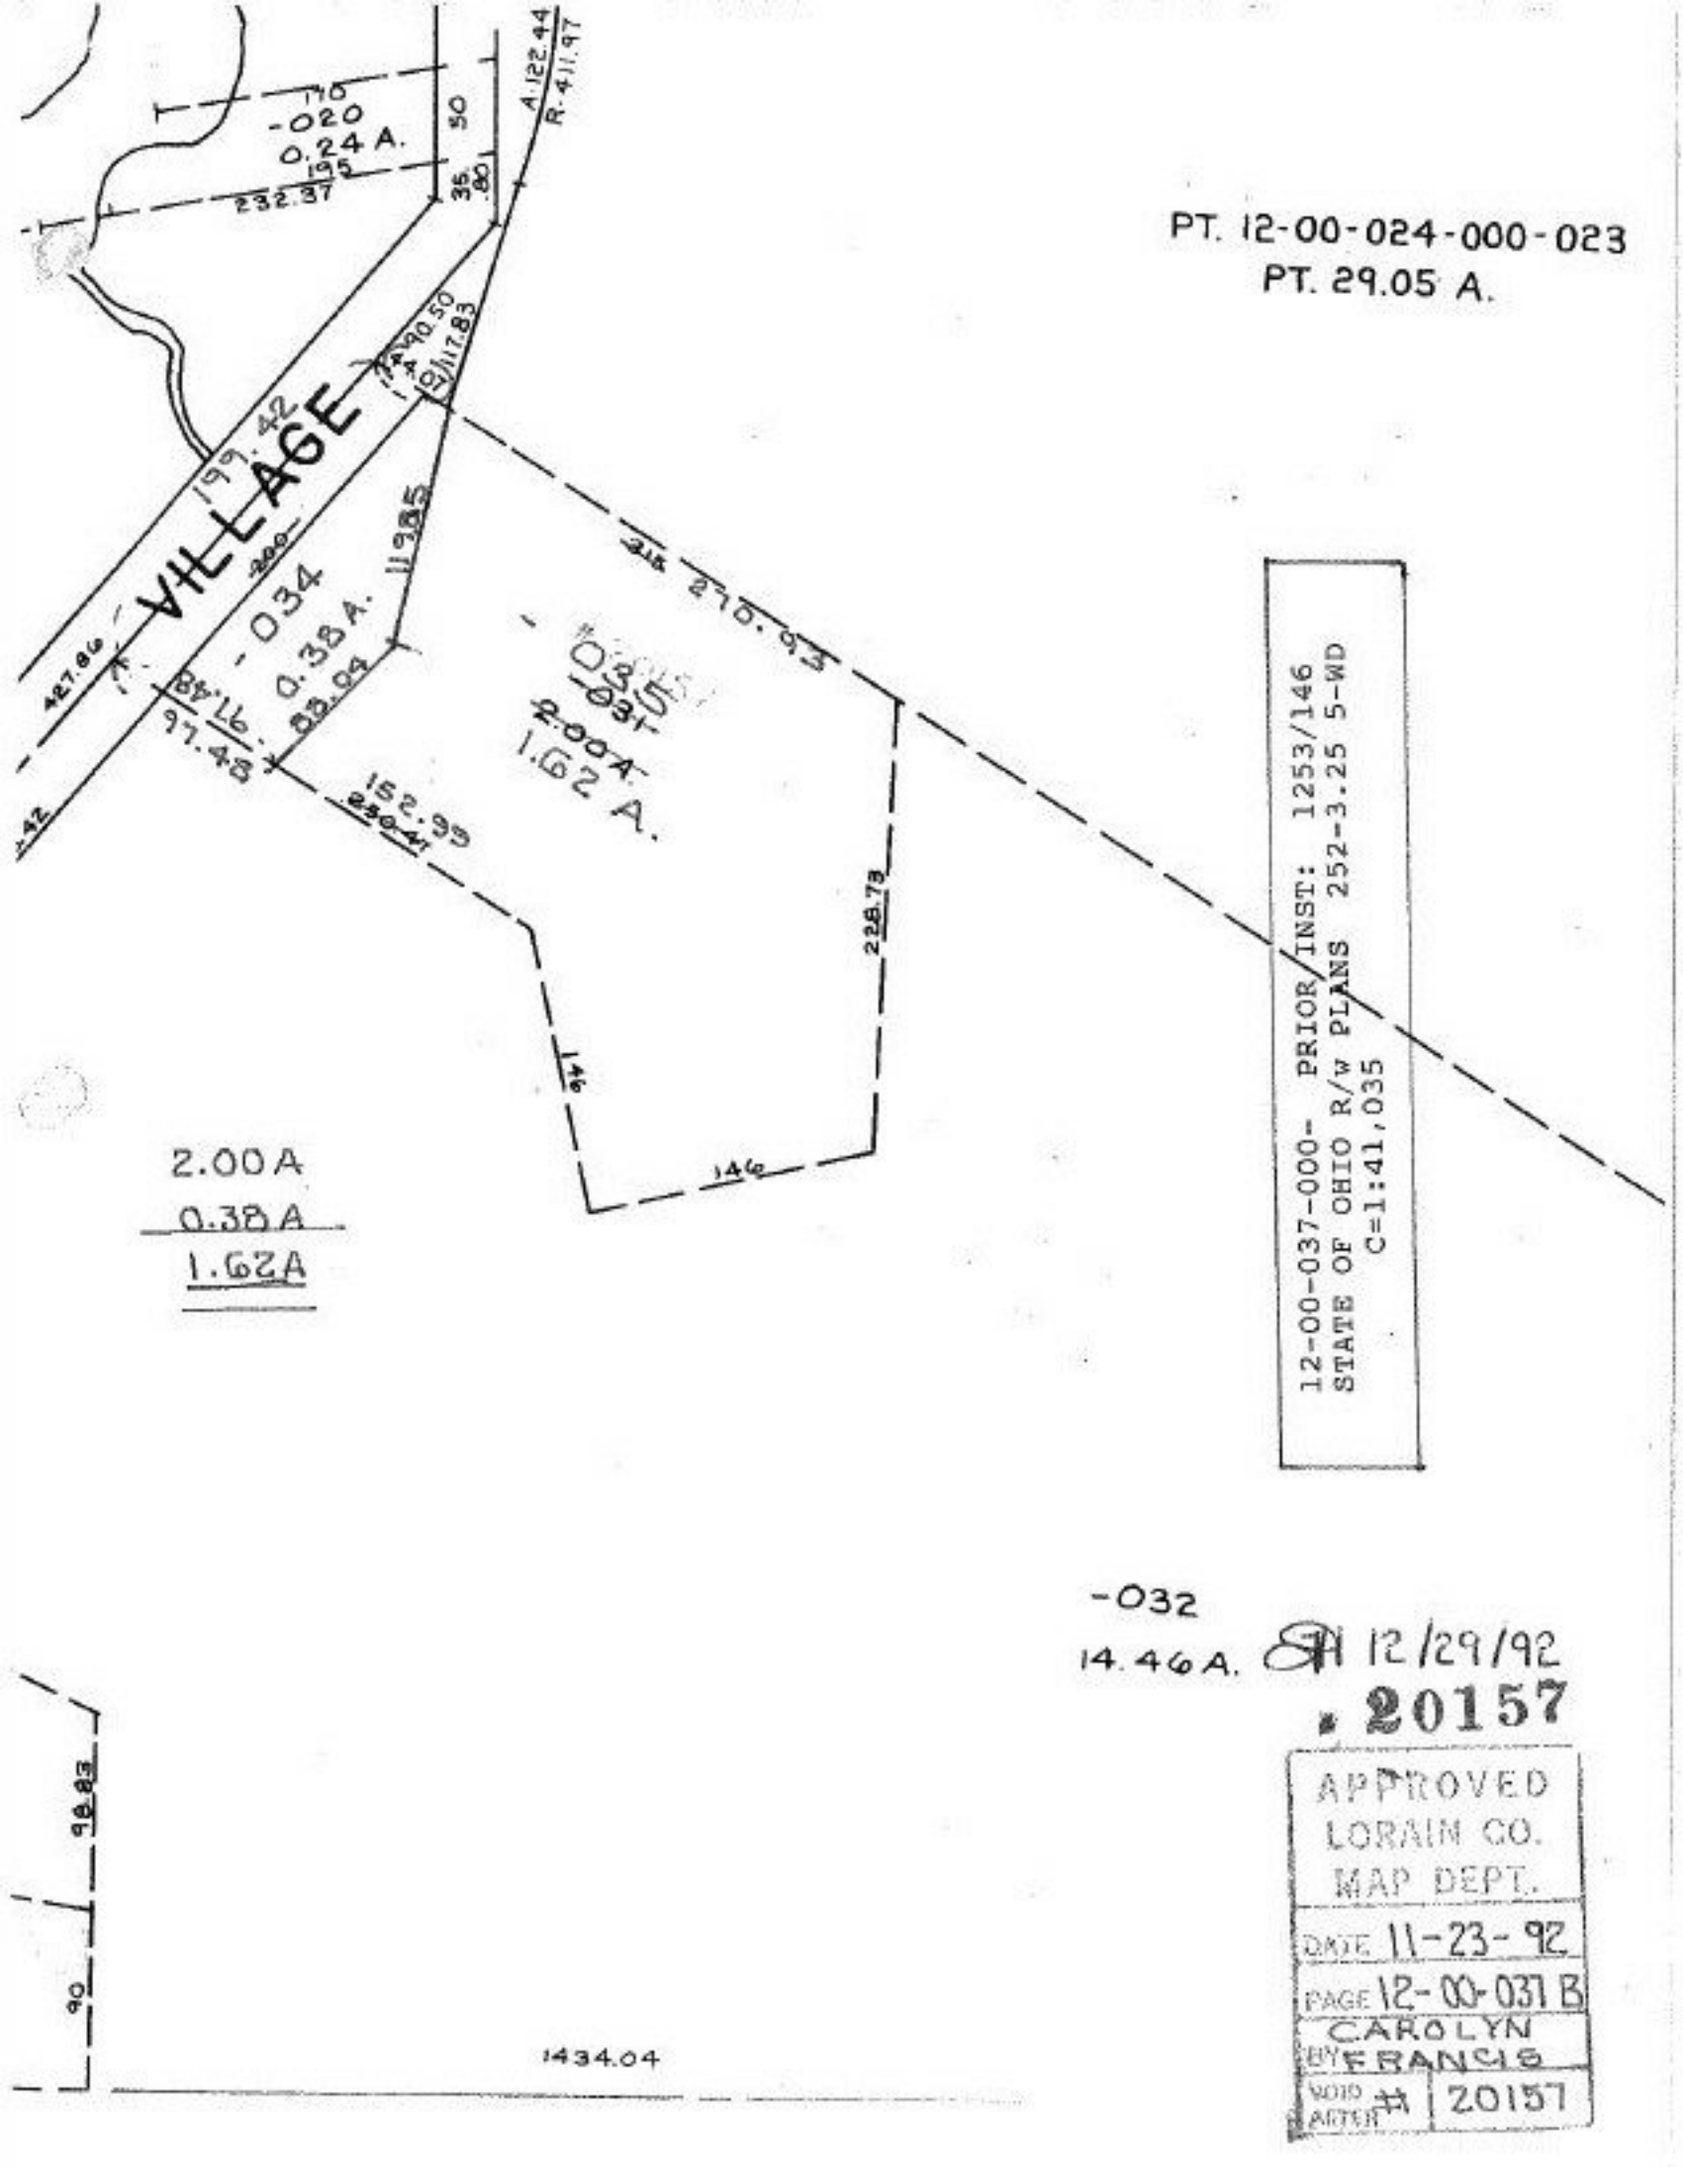
PT. 12-00-024-000-023
PT. 29.05 A.
VILLAGE
-020
0.24 A.
-034
0.38 A.
-033
2.00A
1.62 A.
12-00-037-000- PRIOR INST: 1253/146
STATE OF OHIO R/w PLANS 252-3.25 5-WD
C=1:41,035
2.00A
0.38A
1.62A
-032
14.46A.
12/29/92
20157
APPROVED
LORAIN CO.
MAP DEPT.
DATE 11-23-92
PAGE 12-00-037 B
BY CAROLYN FRANCIS
VOID AFTER # 20157
1434.04