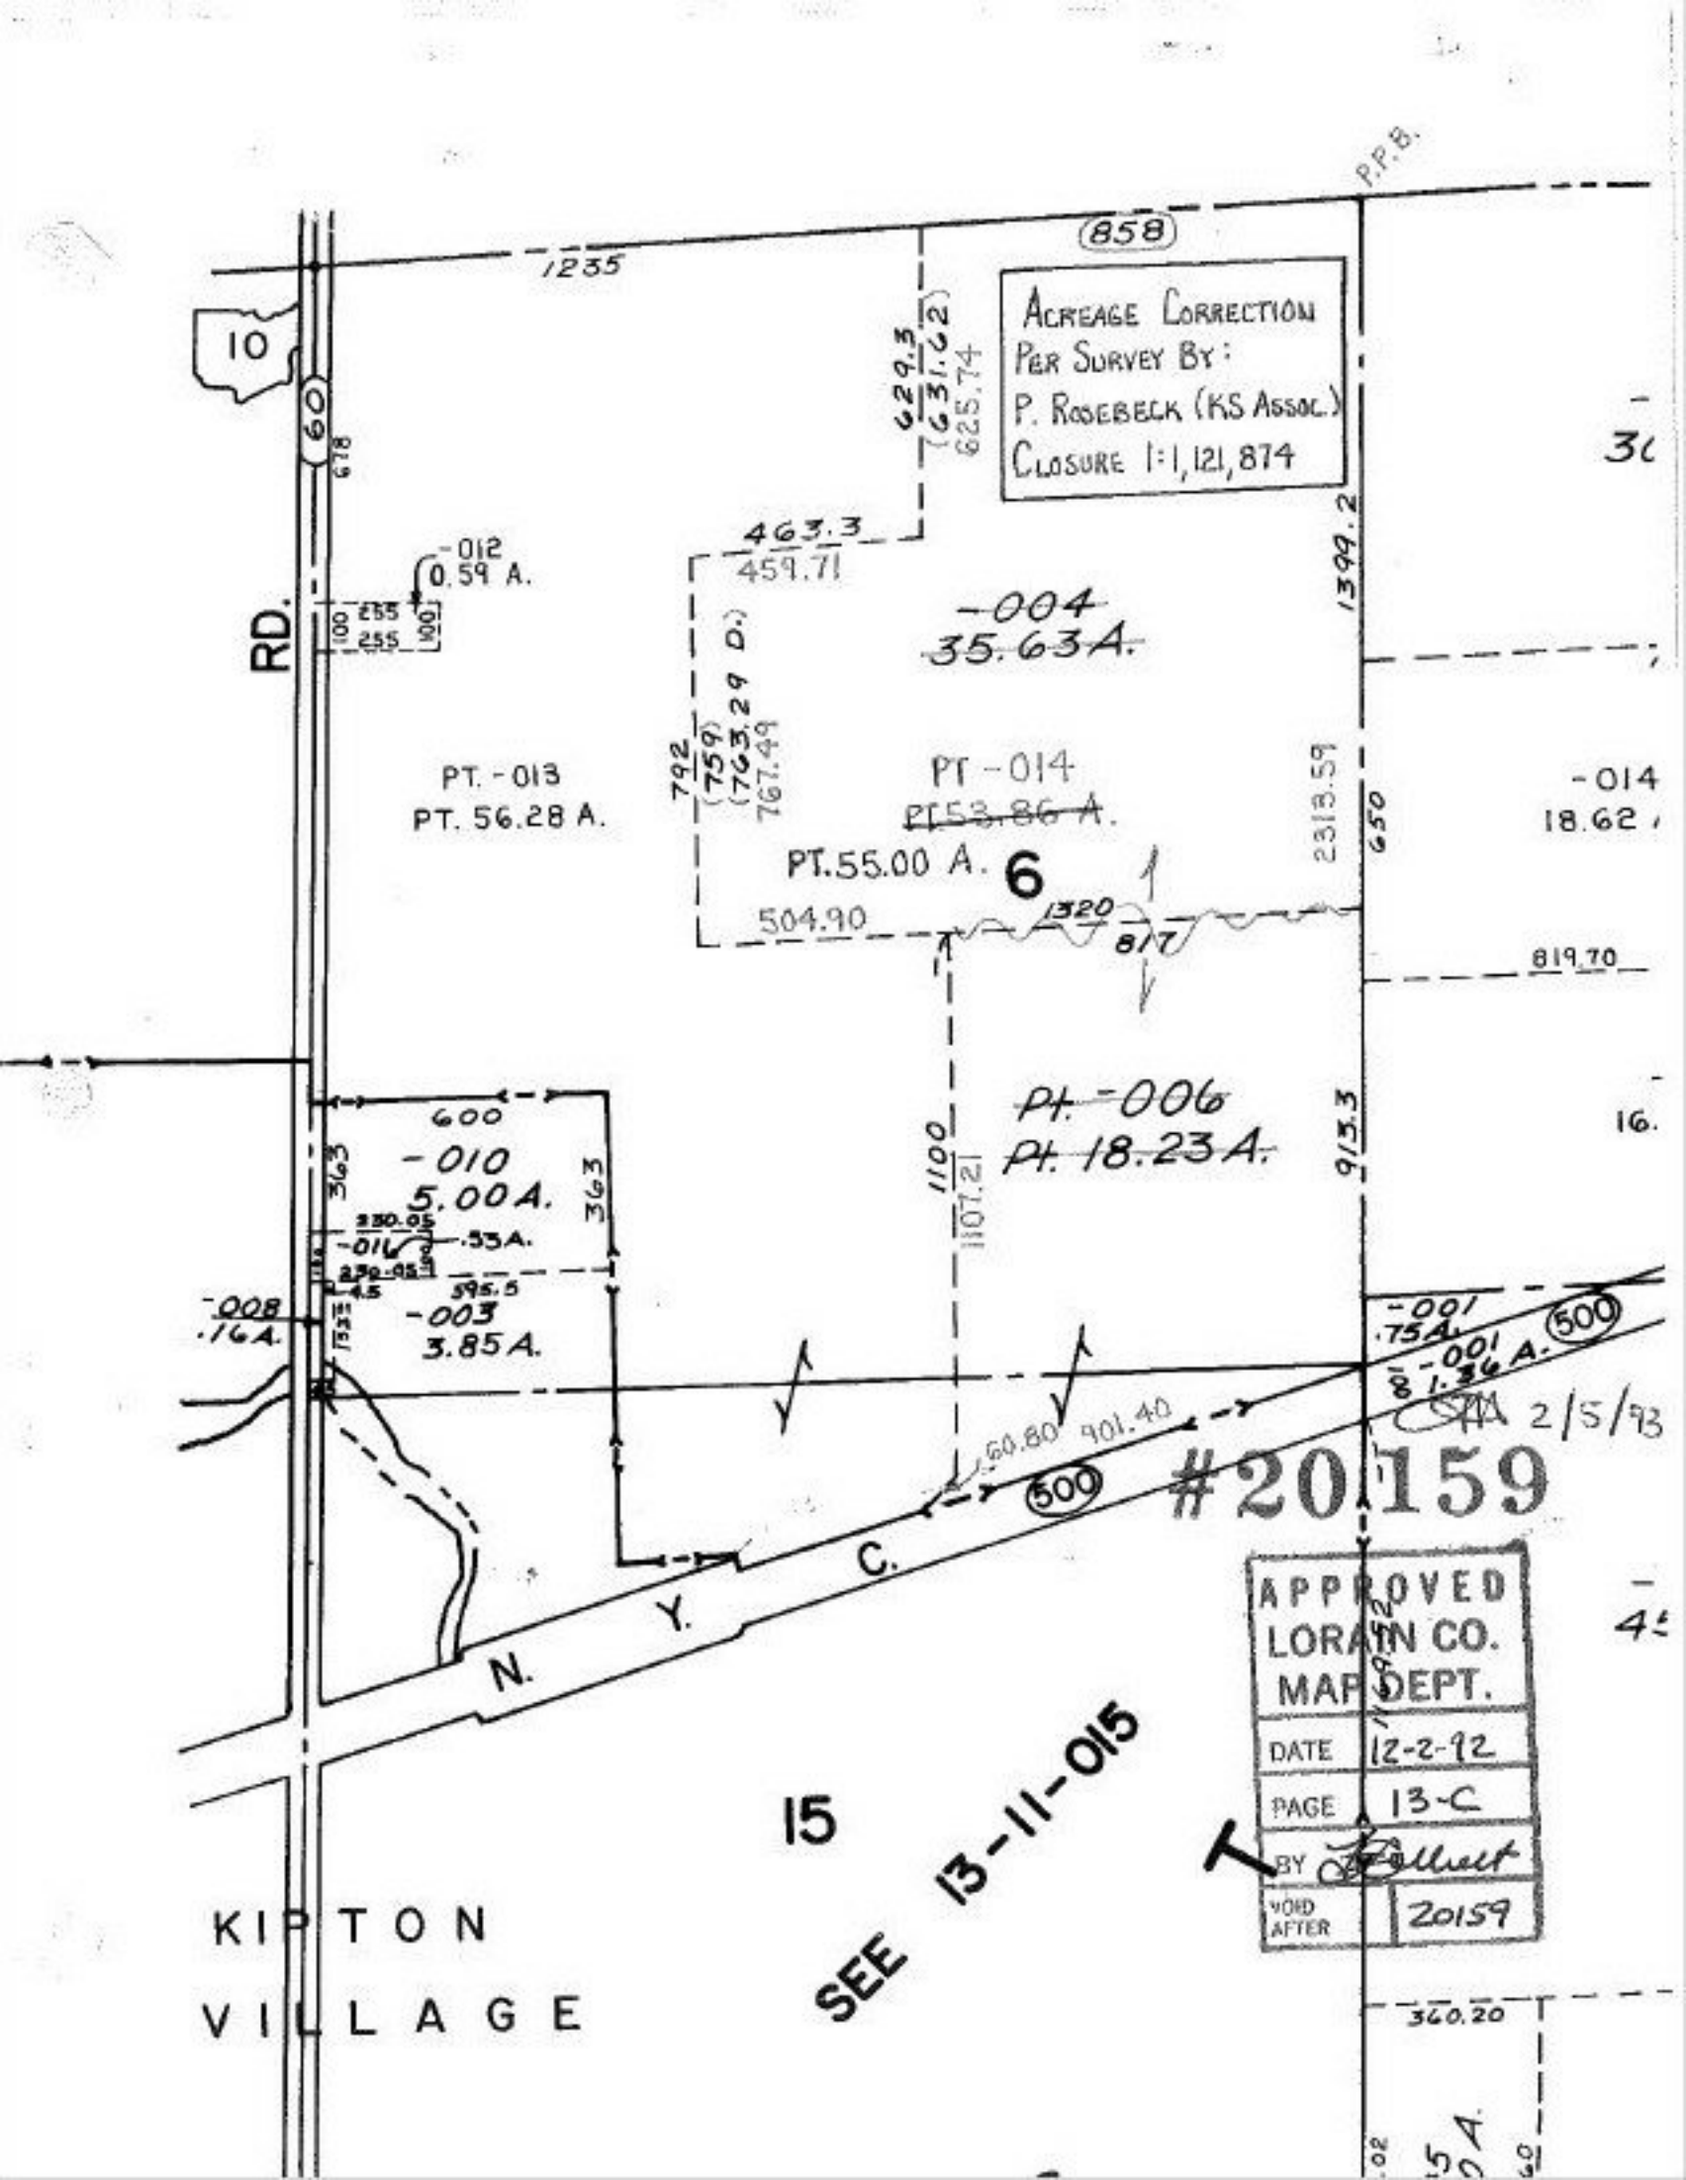
P.P.B.
858
1235
ACREAGE CORRECTION
PER SURVEY BY:
P. ROSEBECK (KS ASSOC.)
CLOSURE 1:1,121,874
10
60
678
RD.
-012
0.59 A.
463.3
459.71
-004
35.63A.
629.3
(631.62)
625.74
1399.2
792
(759)
(763.29 D.)
767.49
PT. - 013
PT. 56.28 A.
PT - 014
PT 53.86 A.
PT. 55.00 A.
6
2313.59
650
-014
18.62
504.90
1320
817
819.70
600
-010
5.00A.
363
-016
.55A.
-008
.16A.
-003
3.85A.
1100
1107.21
Pt. -006
Pt. 18.23A.
913.3
16.
-001
.75A.
-001
1.36A.
500
60.80
901.40
N. Y. C.
2/5/93
#20159
APPROVED
LORAIN CO.
MAP DEPT.
DATE 12-2-92
PAGE 13-C
BY
VOID AFTER 20159
15
SEE 13-11-015
KIPTON
VILLAGE
360.20