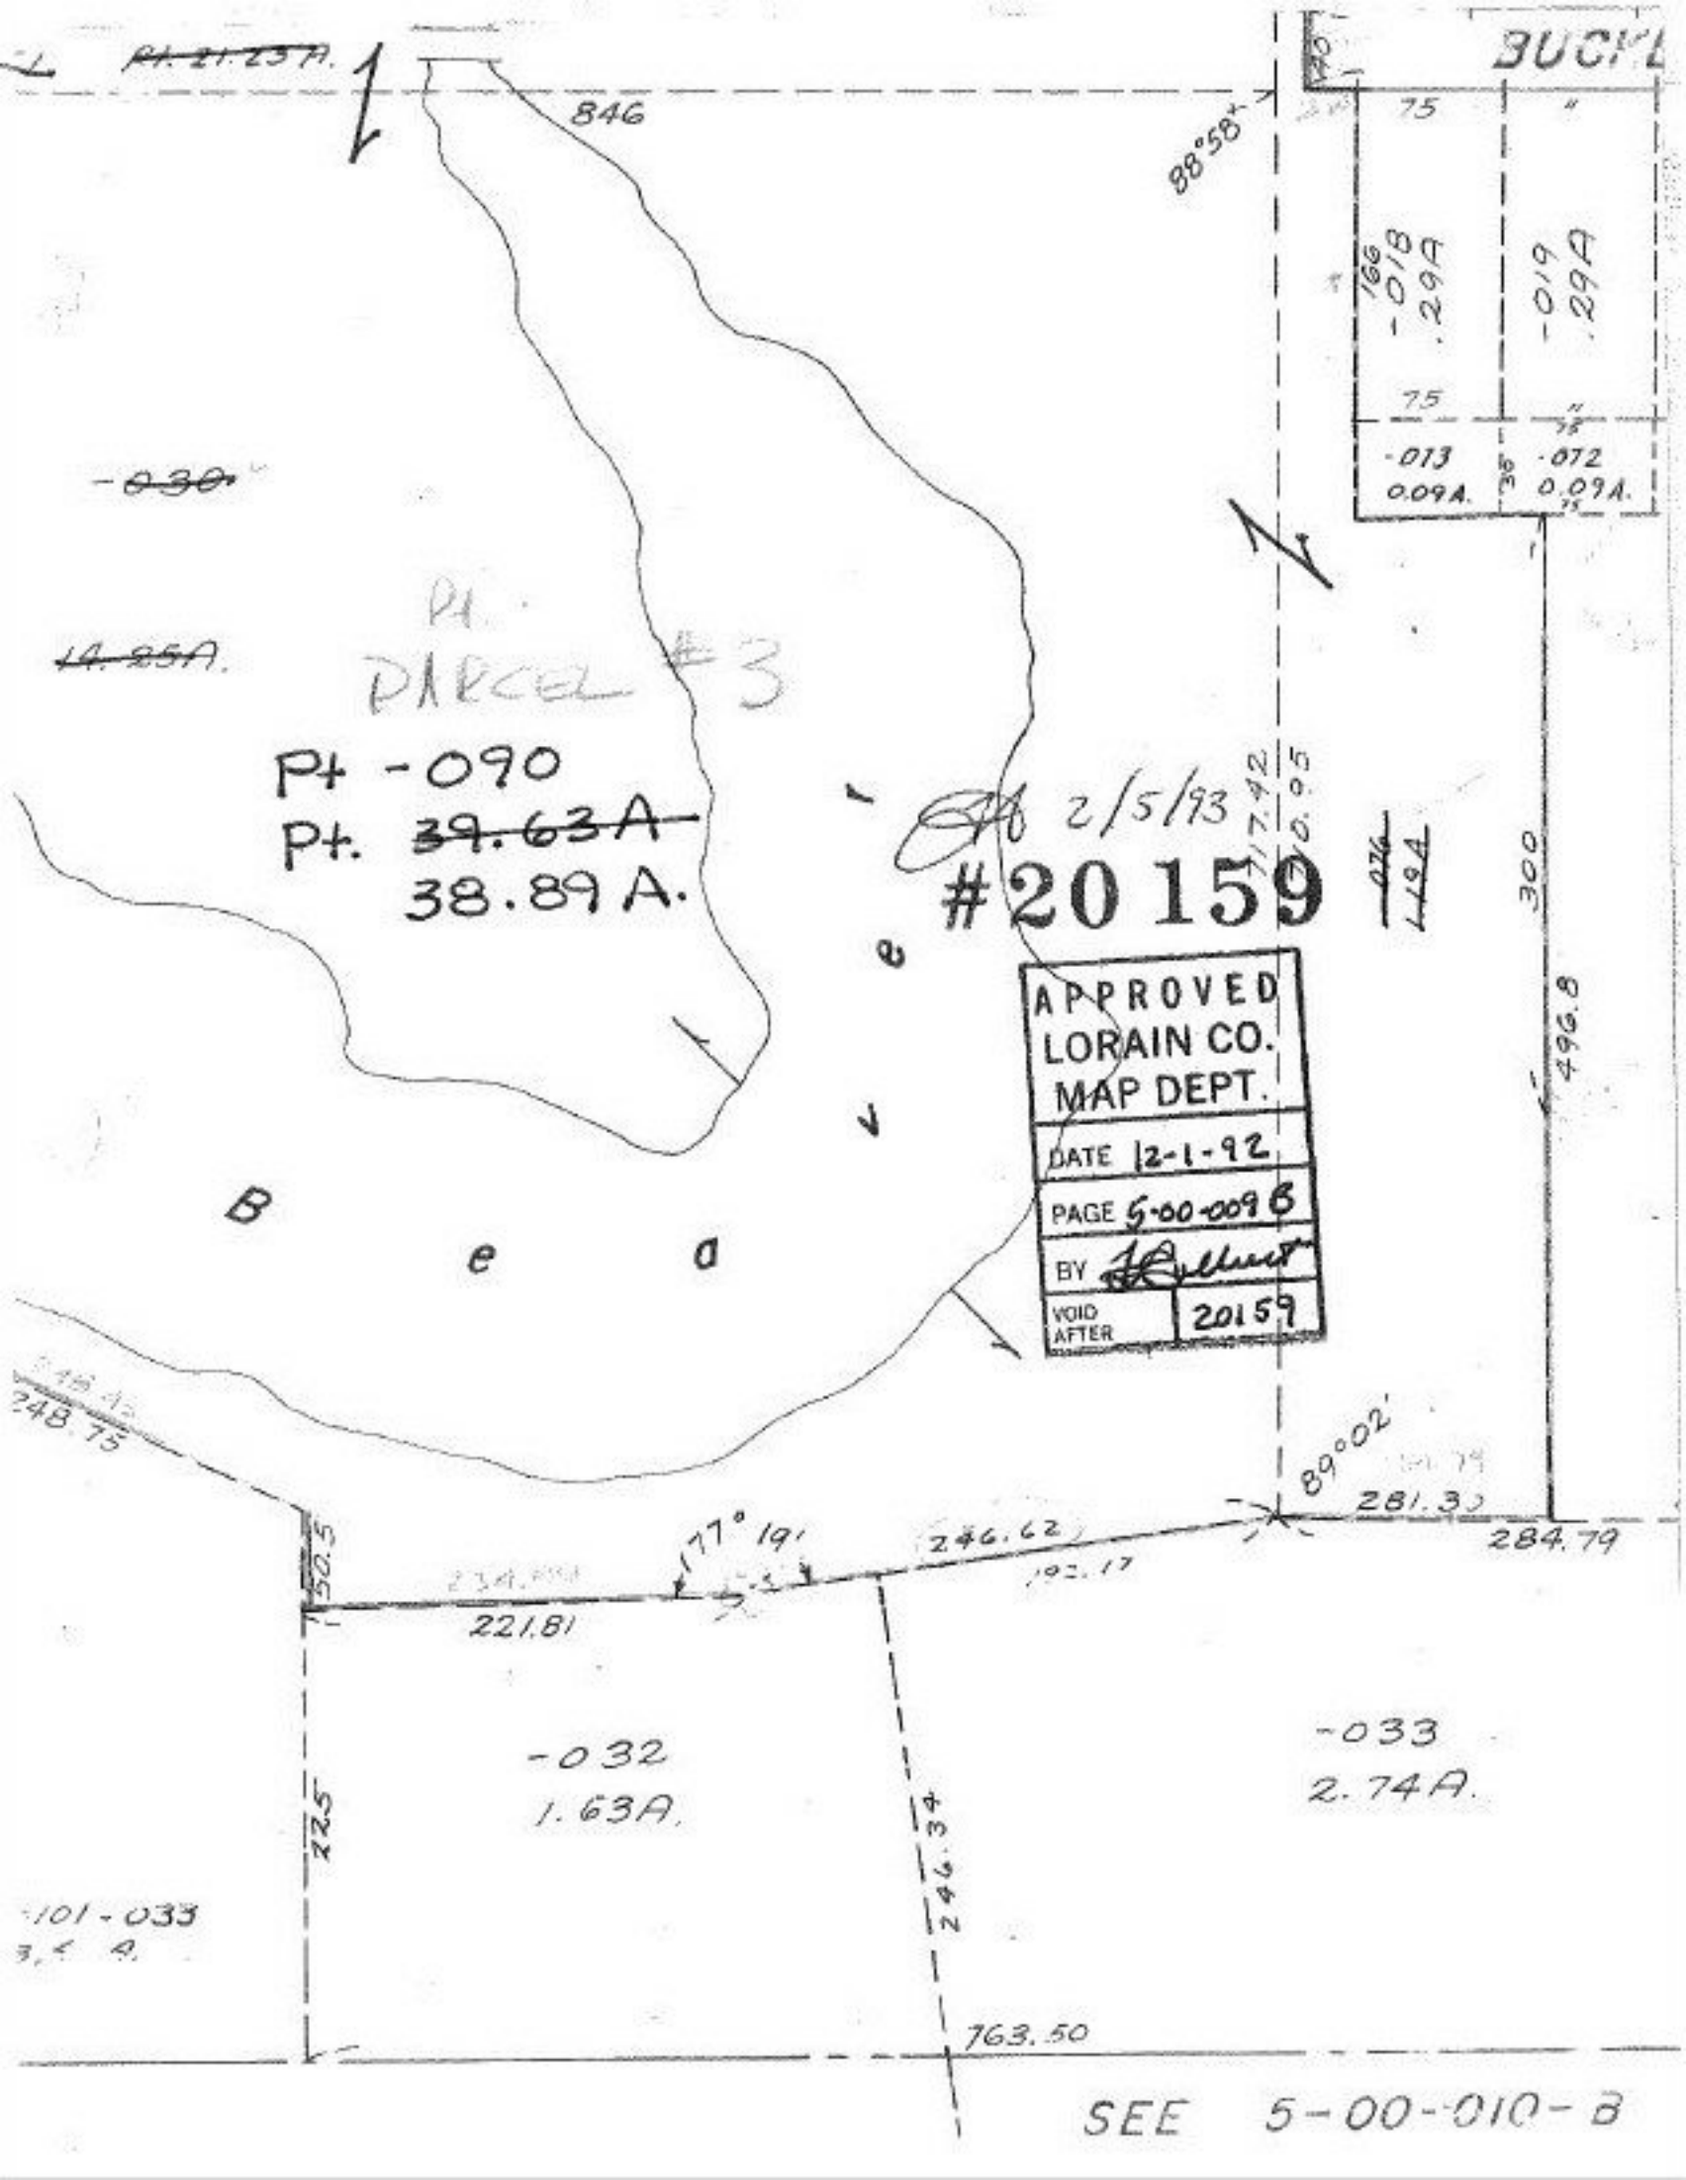
Pt. 21.23A.
846
88°58'
BUCK
75
166
-018
.29A
-019
.29A
75
-013
0.09A.
-072
0.09A.
-030
14.95A.
Pt.
PARCEL #3
Pt -090
Pt. 39.63A
38.89 A.
2/5/93
#20159
APPROVED
LORAIN CO.
MAP DEPT.
DATE 12-1-92
PAGE 5-00-009 B
BY
VOID AFTER 20159
300
496.8
248.75
89°02'
281.3
284.79
77° 19'
246.62
234.88
221.81
225
-032
1.63A.
-033
2.74A.
246.34
763.50
-101-033
3.4 A.
SEE 5-00-010-B