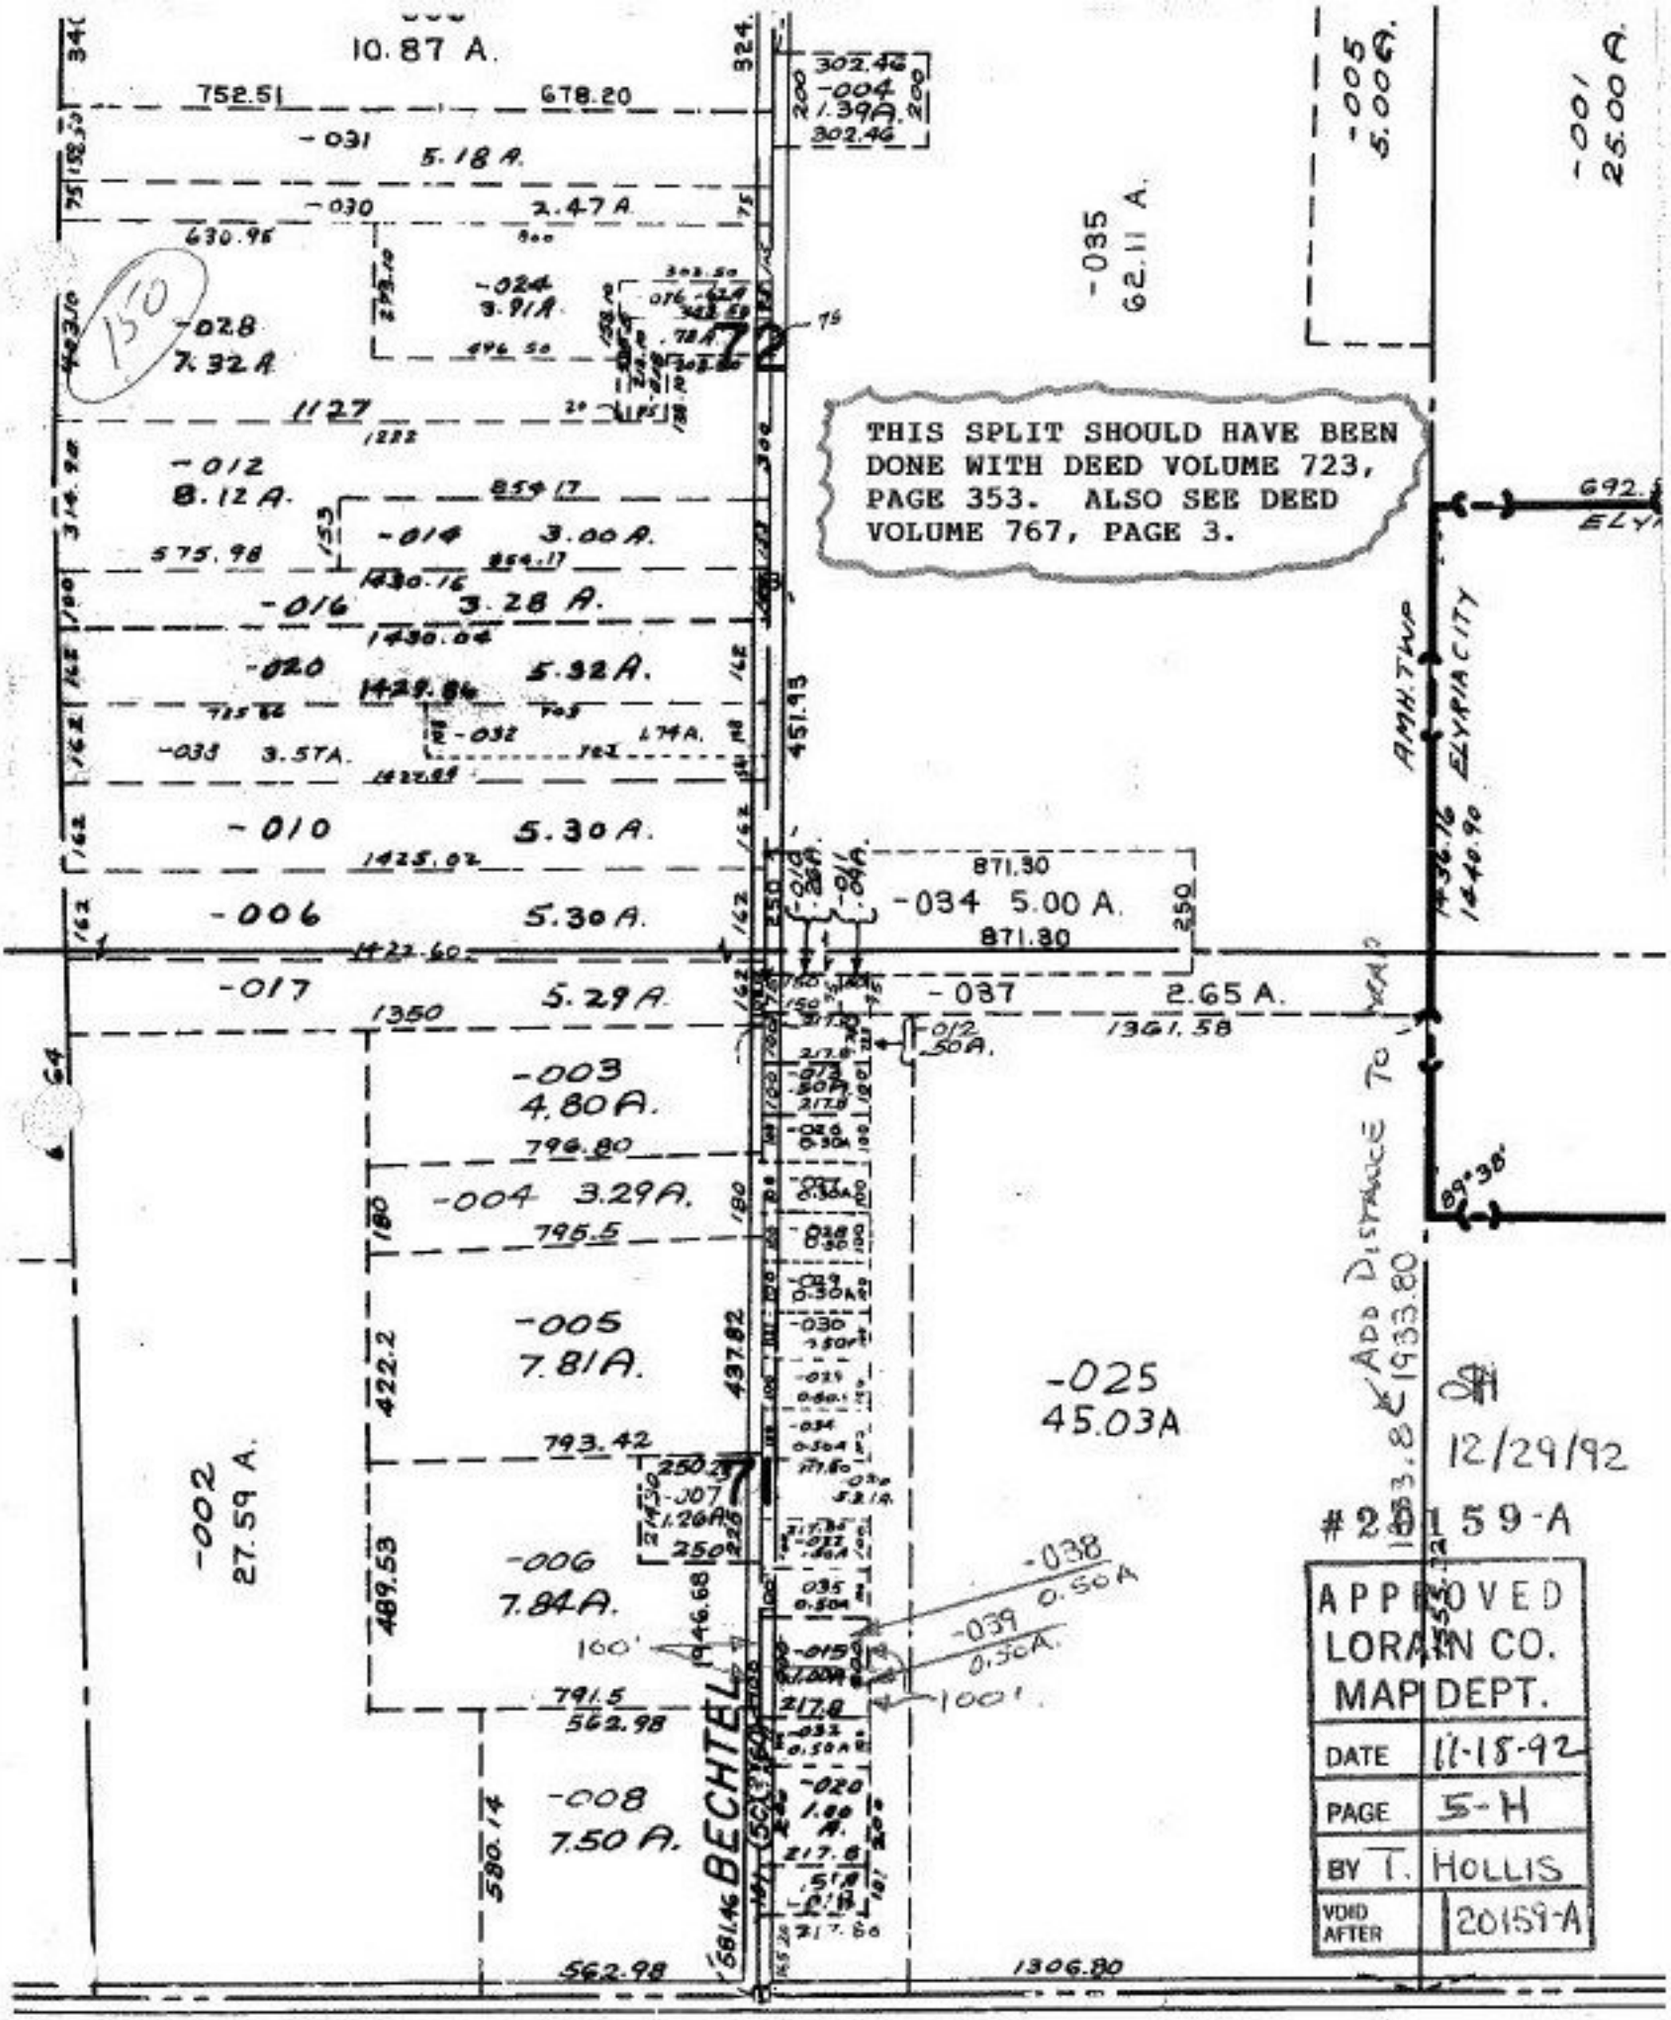
10.87 A.
752.51
678.20
-031
5.18 A.
-030
2.47 A.
430.96
-024
3.91 A.
-028
7.32 A.
1127
-012
8.12 A.
859.17
-014
3.00 A.
575.98
1430.16
-016
3.28 A.
1430.04
-020
5.32 A.
1429.84
-033
3.57A.
-032
1.74A.
-010
5.30 A.
1425.02
-006
5.30 A.
1422.60
-017
5.29 A.
1350
-003
4.80 A.
796.80
-004
3.29A.
795.5
-005
7.81A.
793.42
-002
27.59 A.
-007
1.26A.
-006
7.84A.
791.5
562.98
-008
7.50 A.
580.14
BECHTEL
-035
62.11 A.
-005
5.00A.
-001
25.00 A.
THIS SPLIT SHOULD HAVE BEEN DONE WITH DEED VOLUME 723, PAGE 353. ALSO SEE DEED VOLUME 767, PAGE 3.
871.30
-034 5.00 A.
871.30
-037
2.65 A.
1361.58
-012
.50A.
-025
45.03A
1306.80
AMH. TWP
ELYRIA CITY
1436.16
1440.90
ADD DISTANCE TO
1933.80
89°38'
12/29/92
#20159-A
-038
0.50A
-039
0.50A.
100'
100'
APPROVED
LORAIN CO.
MAP DEPT.
DATE 11-18-92
PAGE 5-H
BY T. HOLLIS
VOID AFTER 20159-A