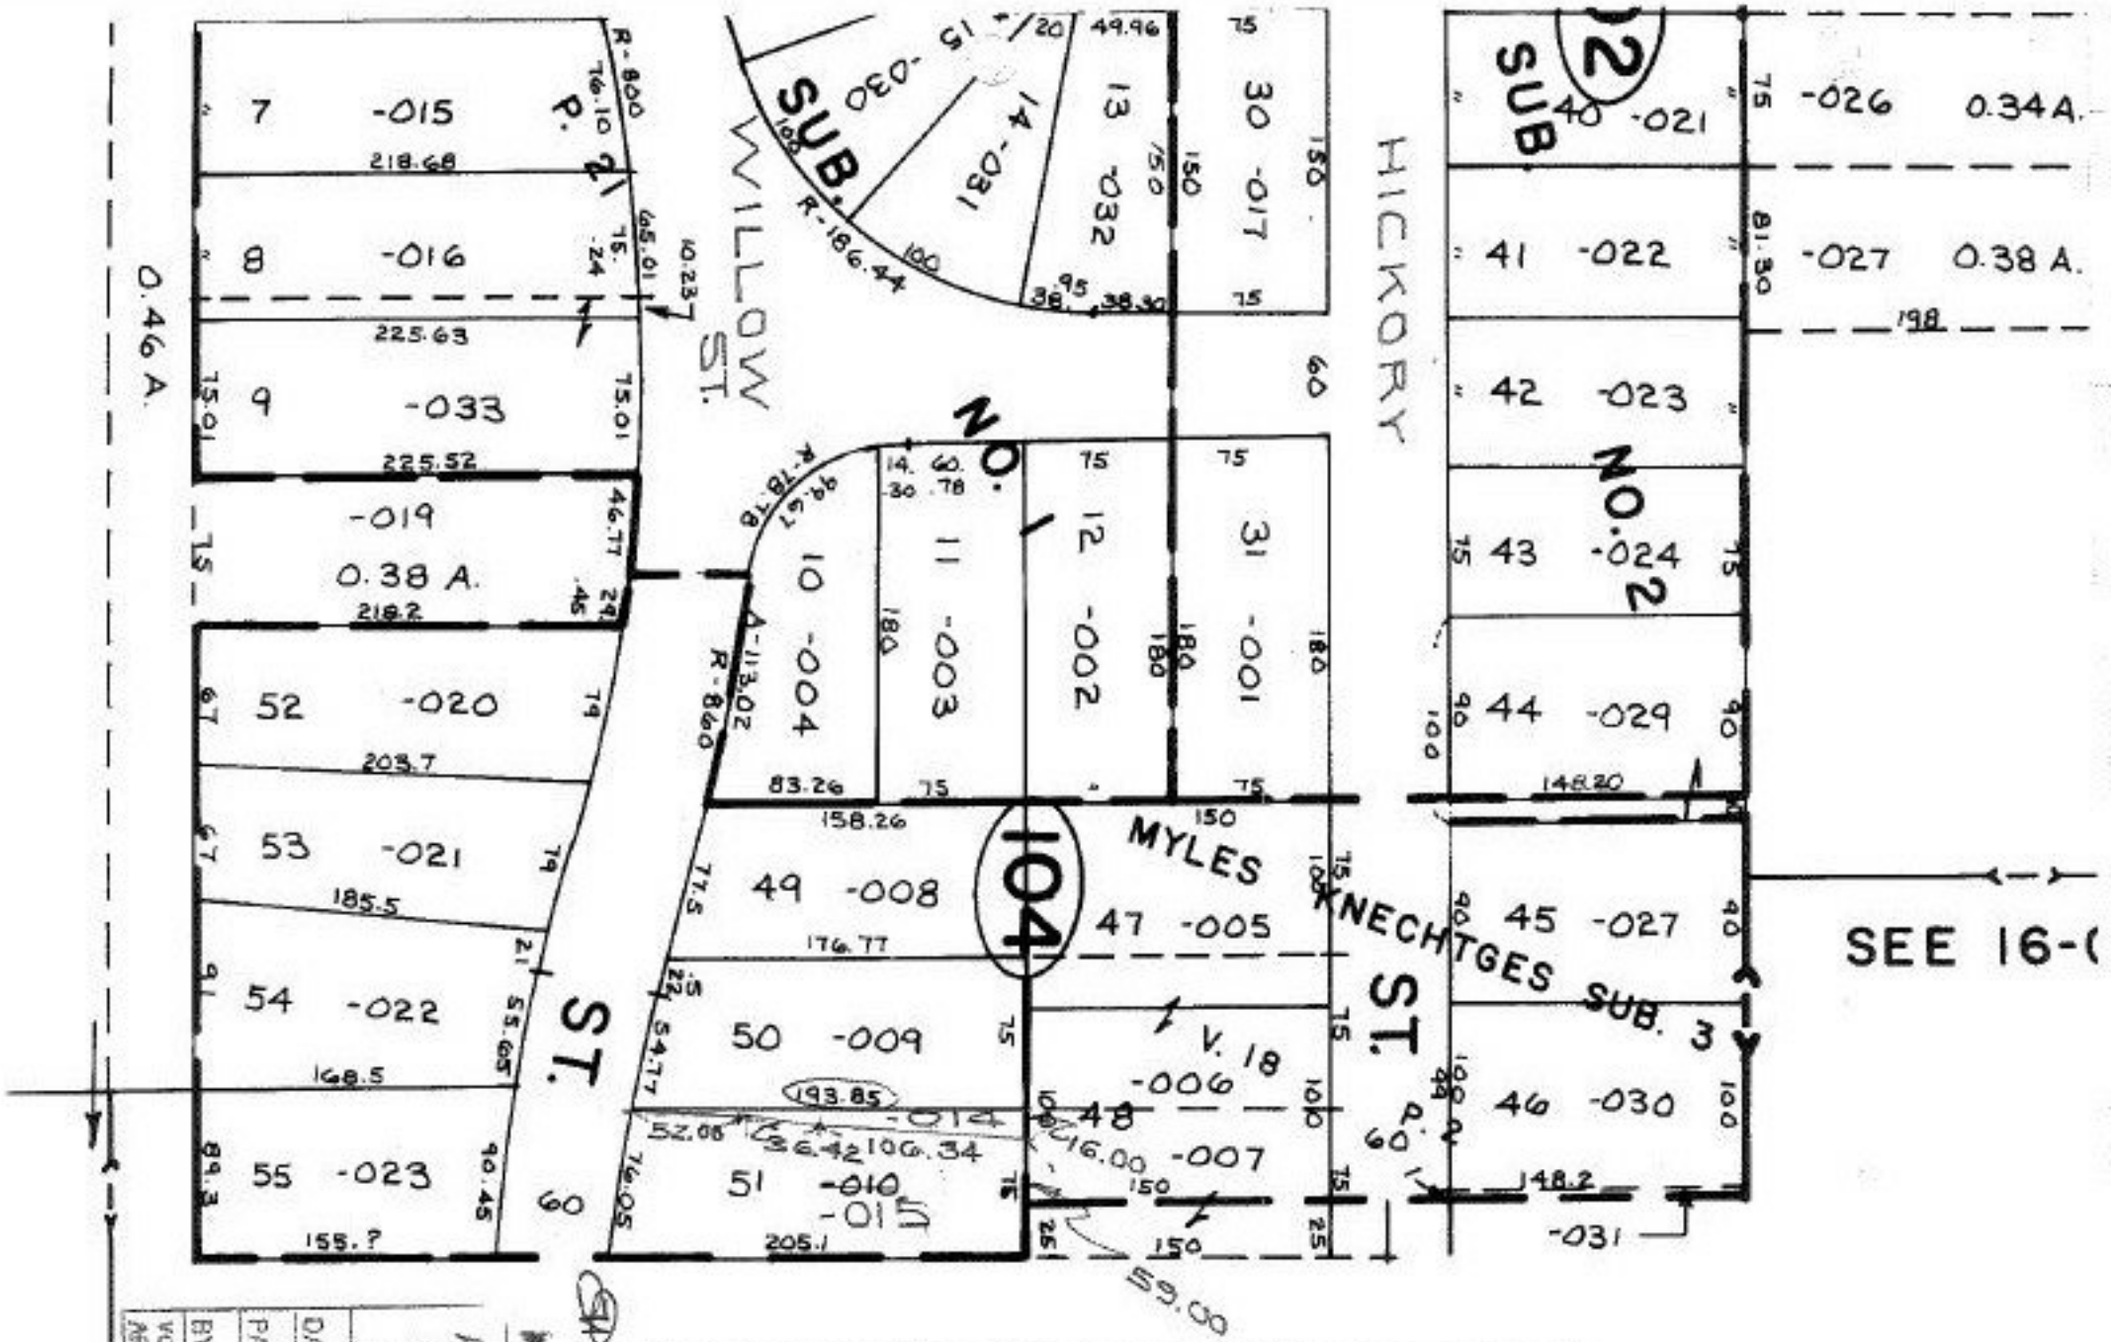

16-00-003-104- PRIOR INST: 1014/837
SURVEYED BY: JOHN POZYWAK REG. SURVEYOR
C=1:~~2432.000~~ 2000.000