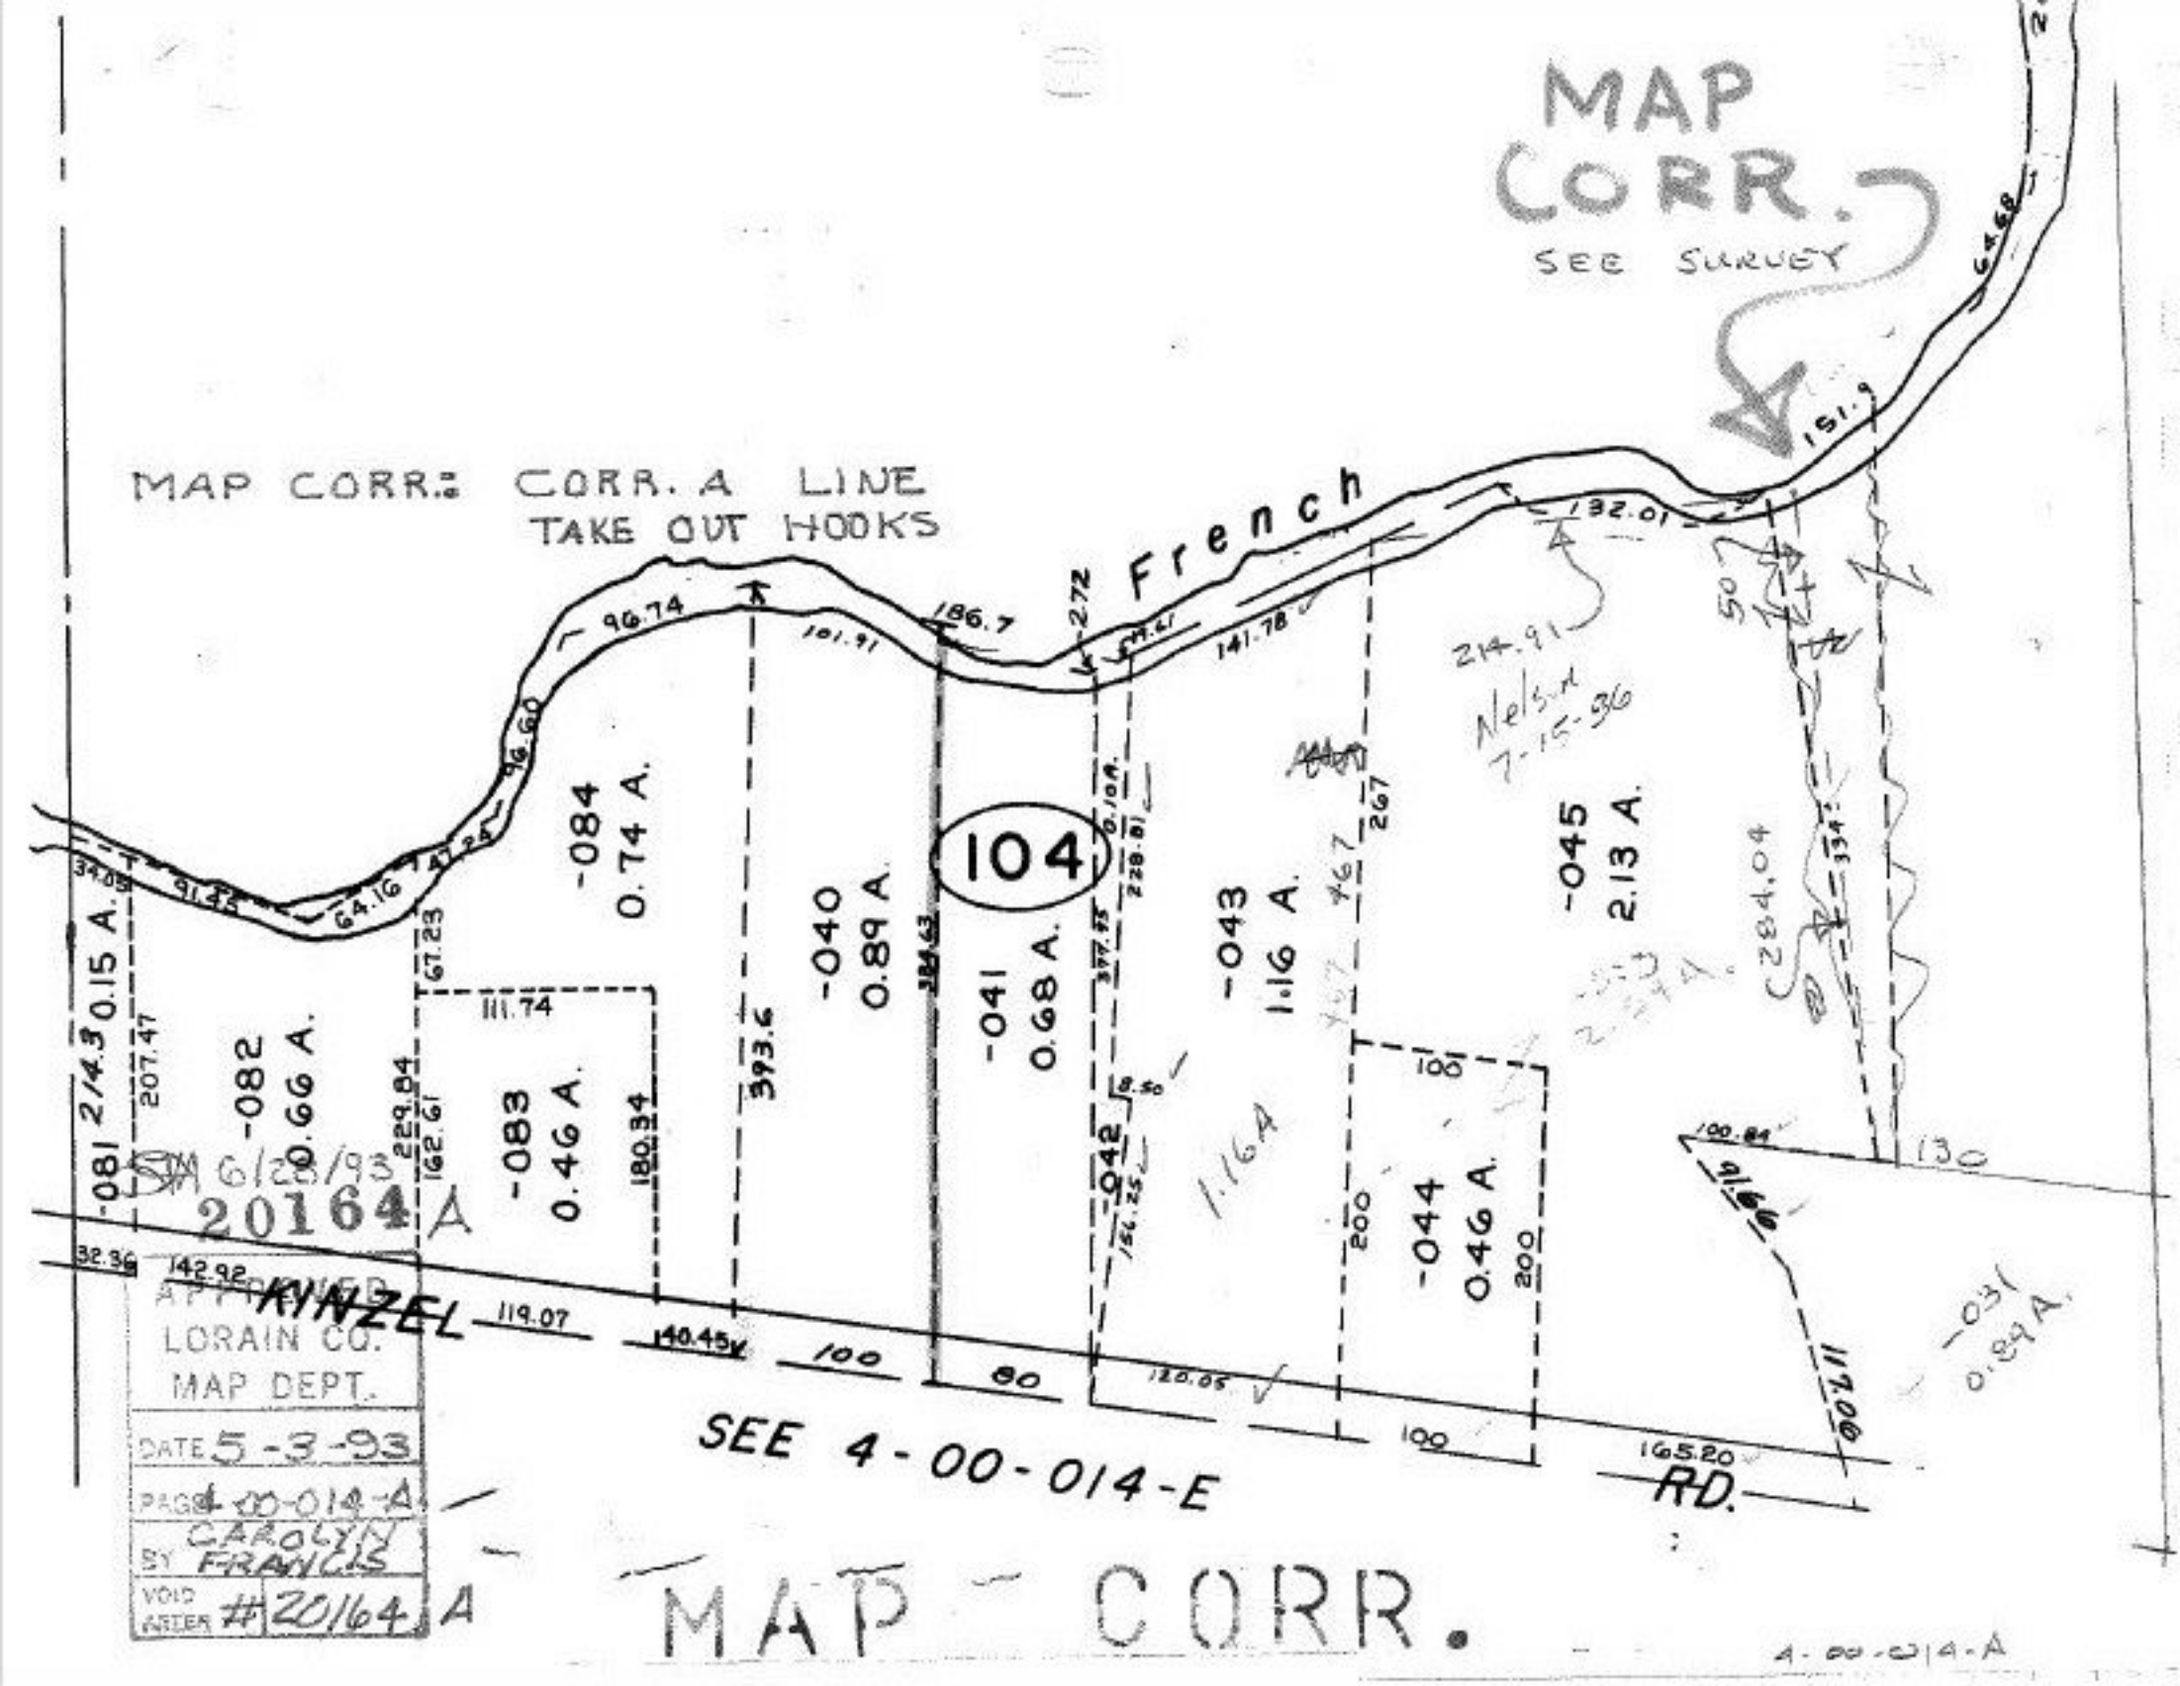
MAP CORR.
SEE SURVEY
MAP CORR.: CORR. A LINE
TAKE OUT HOOKS
French
104
-081 2/4.3 0.15 A.
-082 0.66 A.
-083 0.46 A.
-084 0.74 A.
-040 0.89 A.
-041 0.68 A.
-042
-043 1.16 A.
-044 0.46 A.
-045 2.13 A.
-031 0.89 A.
KINZEL
SEE 4-00-014-E
RD.
SM 6/28/93
20164 A
APPROVED
LORAIN CO.
MAP DEPT.
DATE 5-3-93
PAGE 4-00-014-A
BY CAROLYN FRANCIS
VOID AFTER #20164 A
MAP CORR.
4-00-014-A