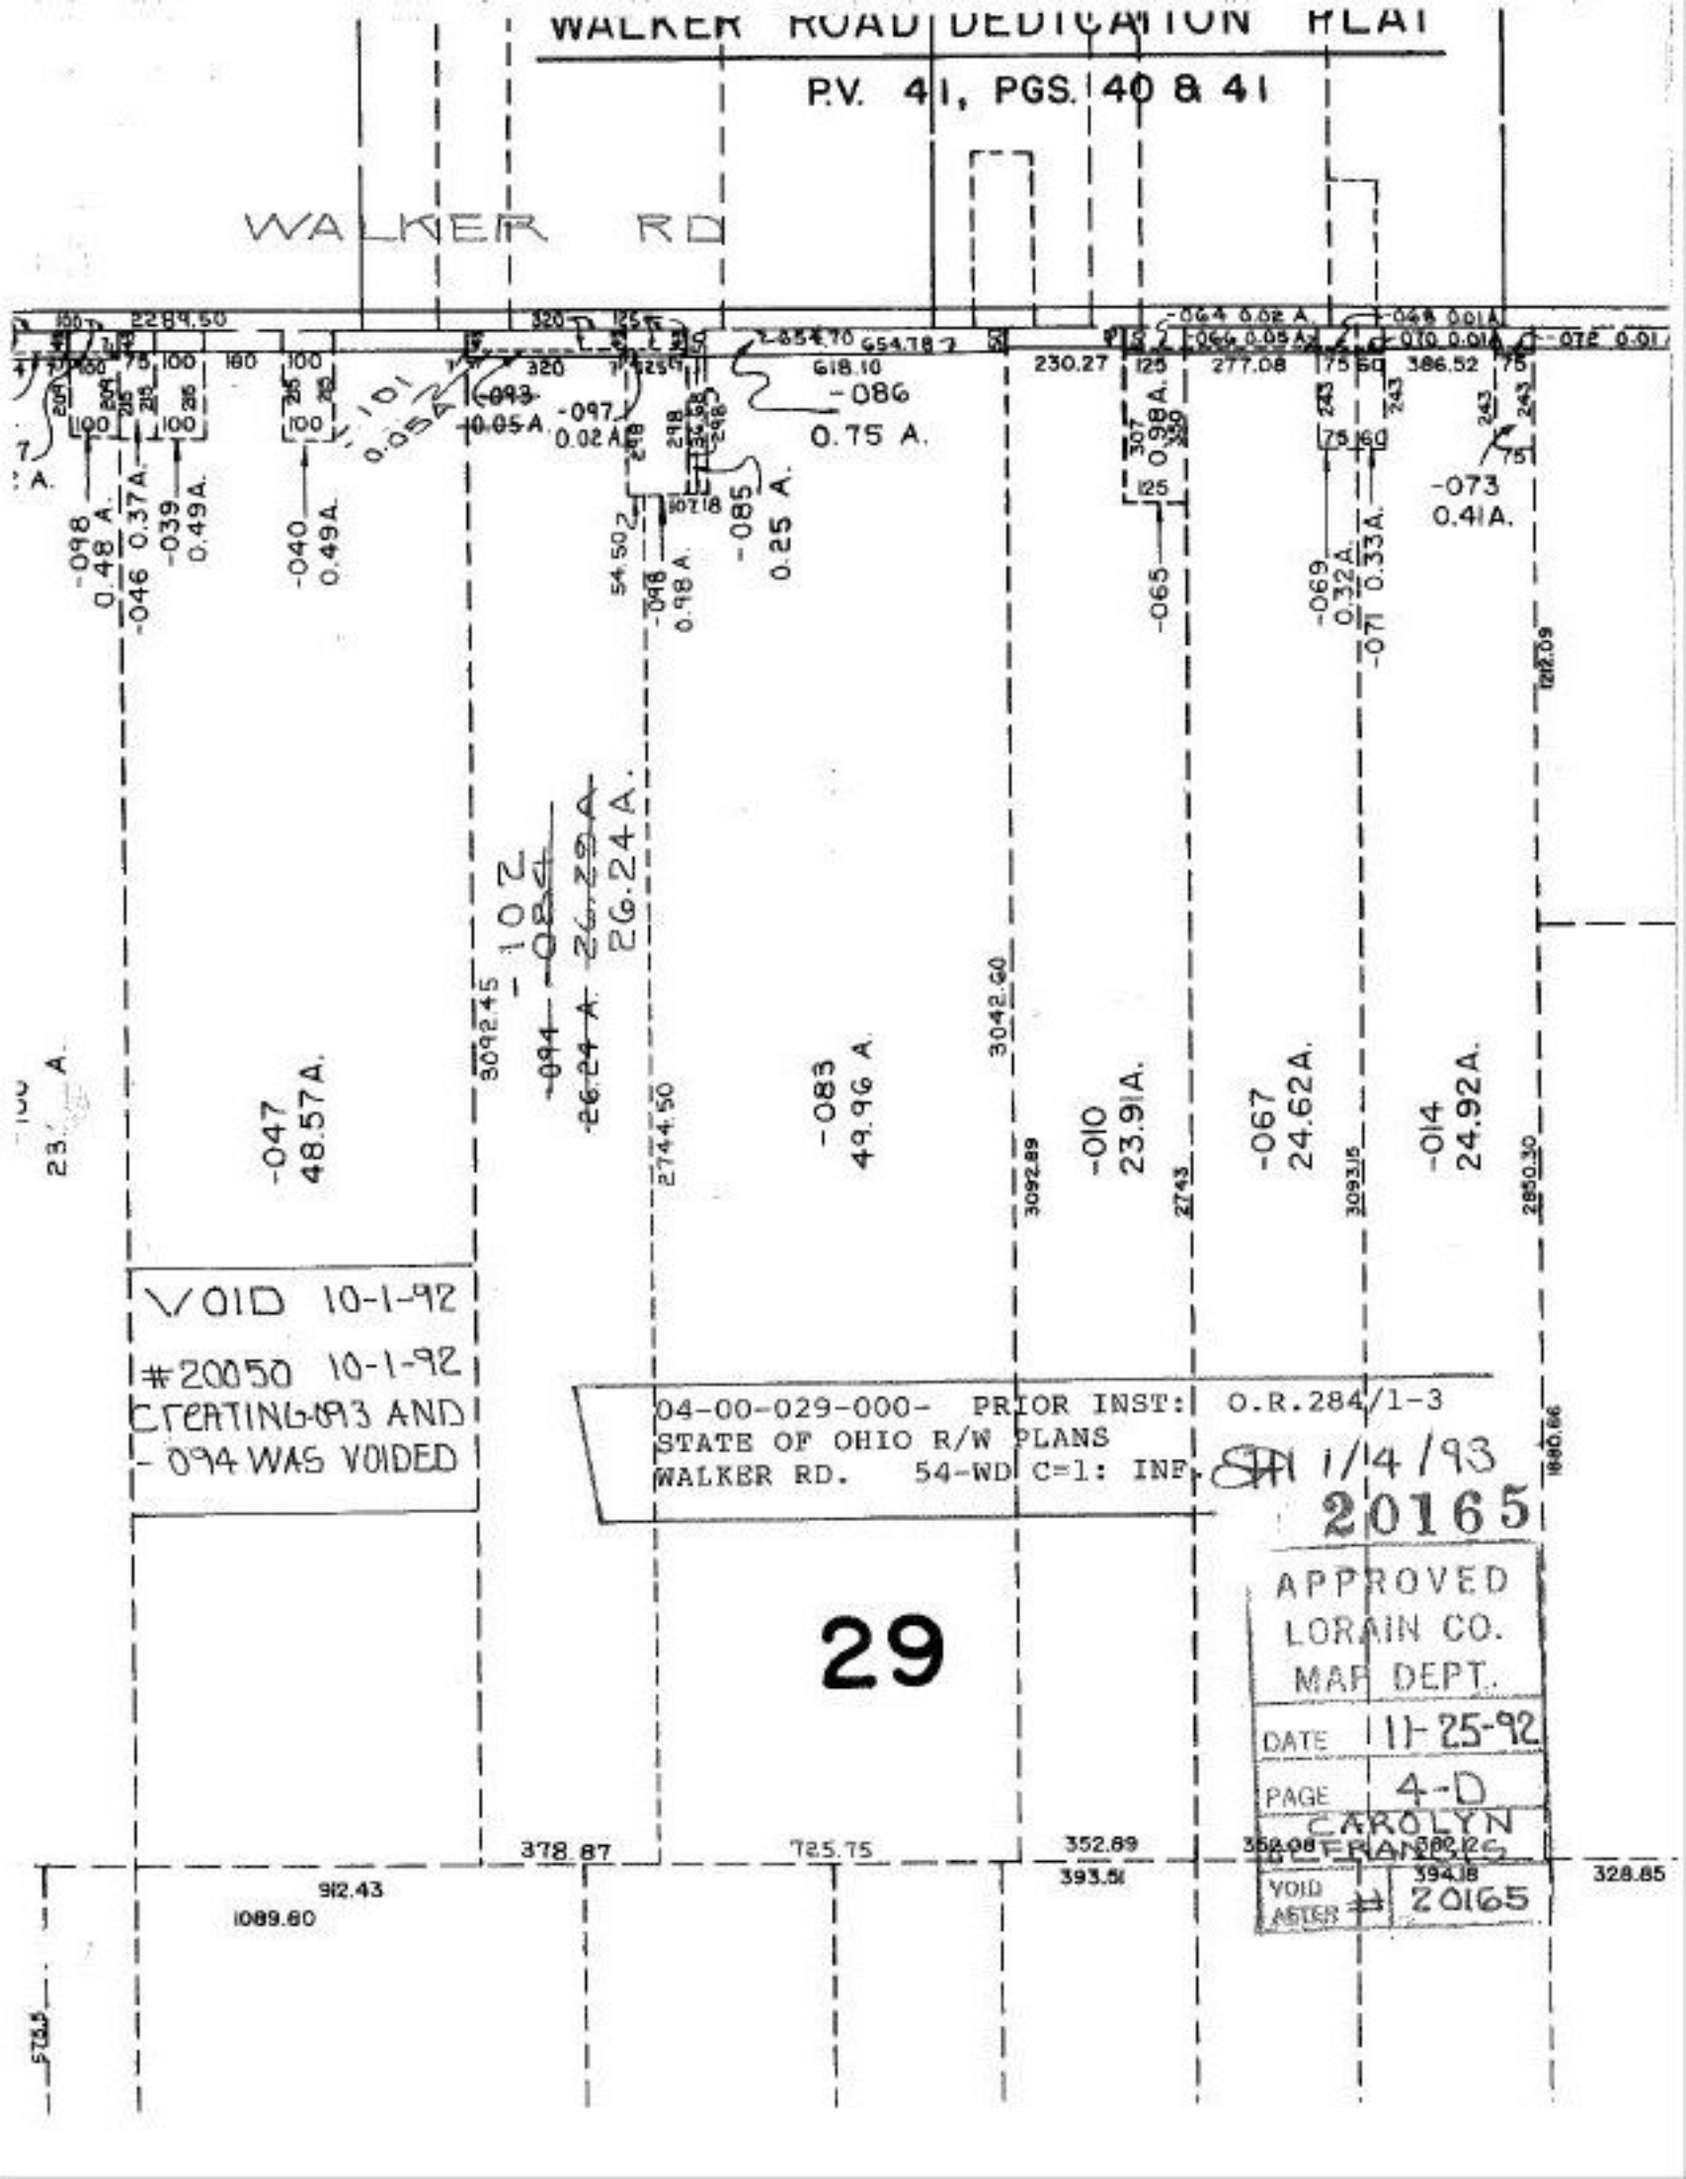
WALKER ROAD DEDICATION PLAT
P.V. 41, PGS. 40 & 41
WALKER RD
-098 0.48 A.
-046 0.37 A.
-039 0.49 A.
-040 0.49 A.
-093 0.05 A.
-097 0.02 A.
-086 0.75 A.
-085 0.25 A.
-048 0.98 A.
-065 0.98 A.
-069 0.32 A.
-071 0.33 A.
-073 0.41 A.
-047 48.57 A.
-102
-083 49.96 A.
-010 23.91 A.
-067 24.62 A.
-014 24.92 A.
VOID 10-1-92
#20050 10-1-92
CREATING -093 AND
-094 WAS VOIDED
04-00-029-000- PRIOR INST: O.R.284/1-3
STATE OF OHIO R/W PLANS
WALKER RD. 54-WD C=1: INF.
1/4/93
20165
APPROVED
LORAIN CO.
MAP DEPT.
DATE 11-25-92
PAGE 4-D
CAROLYN
VOID AFTER # 20165
29