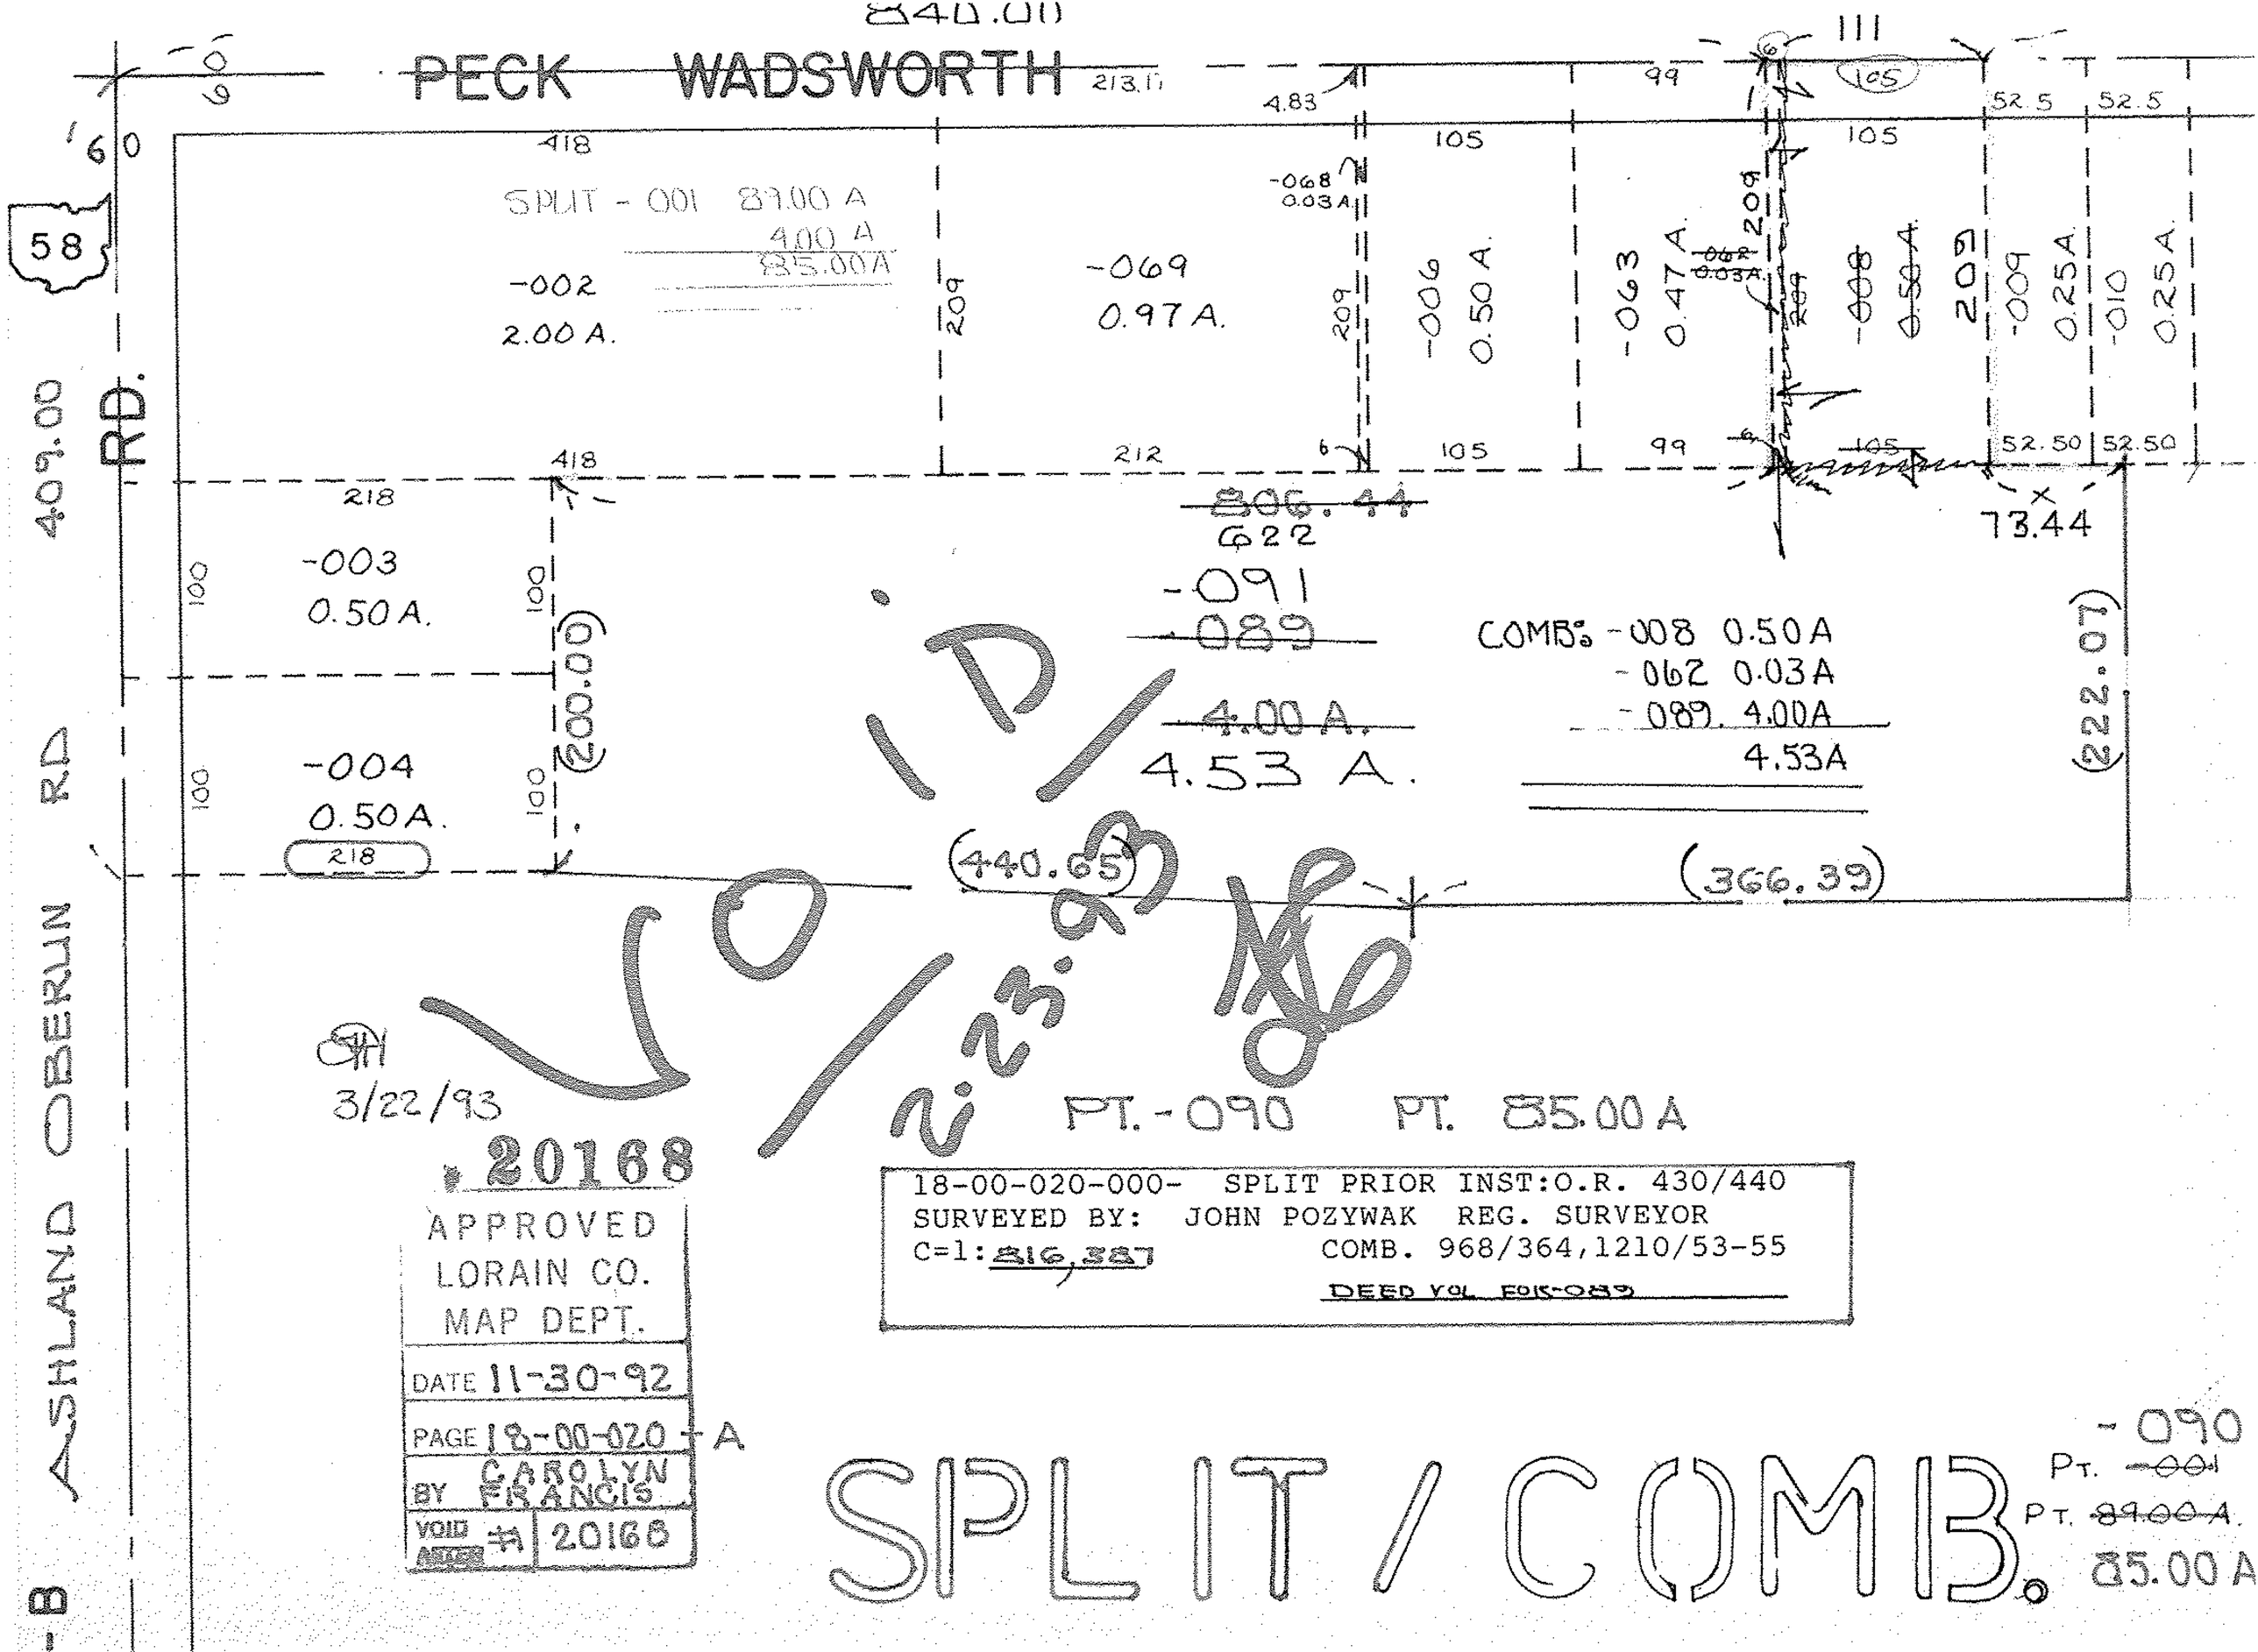

840.00
PECK WADSWORTH
58
409.00
RD.
ASHLAND OBERLIN RD
SPLIT - 001 89.00 A
4.00 A
85.00A
-002
2.00 A.
-069
0.97 A.
-068
0.03 A
-006
0.50 A.
-063
0.47 A.
-062
0.03A.
-008
0.50 A.
-009
0.25 A.
-010
0.25 A.
-003
0.50 A.
-004
0.50 A.
(200.00)
(440.65)
(366.39)
(222.07)
73.44
806.44
622
-091
-089
4.00 A.
4.53 A.
COMB: -008 0.50 A
-062 0.03 A
-089 4.00 A
4.53 A
PT. -090 PT. 85.00 A
3/22/93
20168
APPROVED
LORAIN CO.
MAP DEPT.
DATE 11-30-92
PAGE 18-00-020-A
BY CAROLYN FRANCIS
VOID #20168
18-00-020-000- SPLIT PRIOR INST:O.R. 430/440
SURVEYED BY: JOHN POZYWAK REG. SURVEYOR
C=1: 816,387 COMB. 968/364,1210/53-55
DEED VOL FOR-089
SPLIT / COMB.
PT. -090
PT. 85.00 A