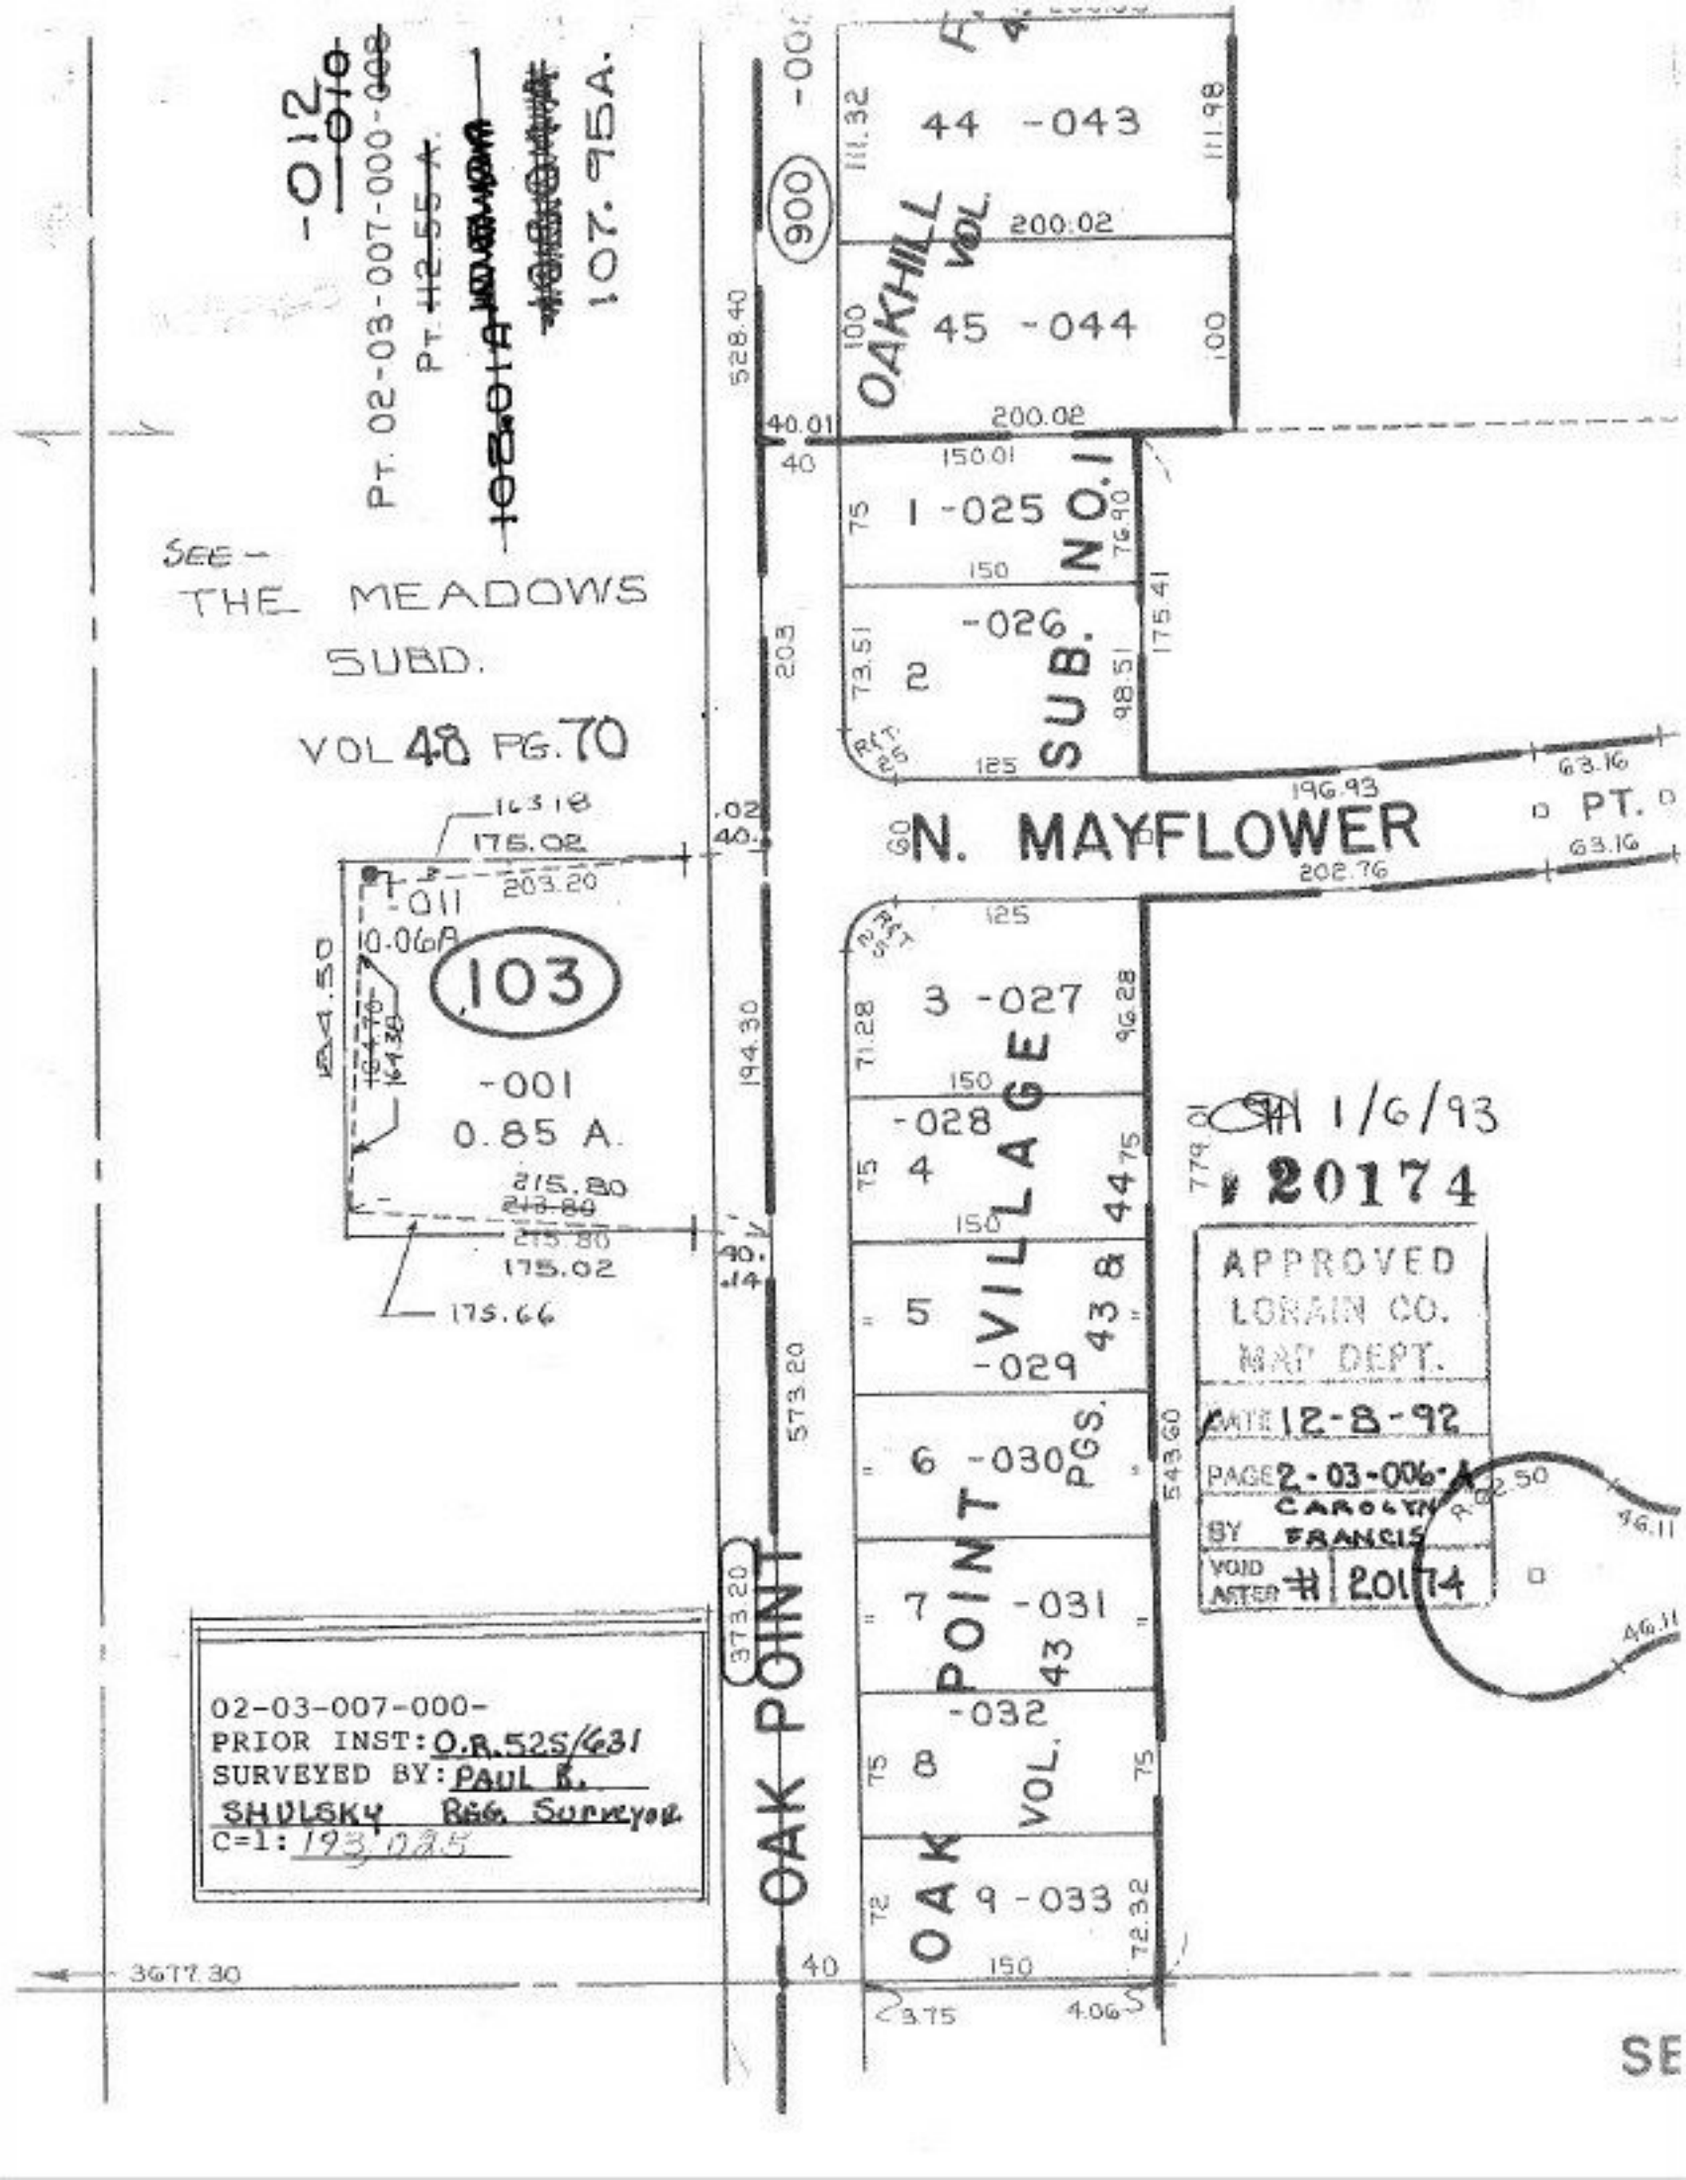

-012
PT. 02-03-007-000-
PT. 112.55 A.
107.95A.
SEE -
THE MEADOWS
SUBD.
VOL 48 PG. 70
103
-001
0.85 A.
163.18
175.02
203.20
-011
0.06A
215.80
175.02
175.66
900
OAKHILL VOL.
44 -043
45 -044
200.02
1 -025
2 -026
SUB. NO. 1
N. MAYFLOWER
PT.
196.93
202.76
63.16
3 -027
4 -028
5 -029
6 -030
7 -031
8 -032
9 -033
VILLAGE
43 & 44
PGS.
OAK POINT
OAK POINT VOL. 43
573.20
543.60
373.20
528.40
194.30
3677.30
1/6/93
20174
APPROVED
LORAIN CO.
MAP DEPT.
DATE 12-8-92
PAGE 2-03-006-A
BY CAROLYN FRANCIS
VOID AFTER # 20174
02-03-007-000-
PRIOR INST: O.R. 525/631
SURVEYED BY: PAUL R. SHULSKY REG. SURVEYOR
C=1: 193.025