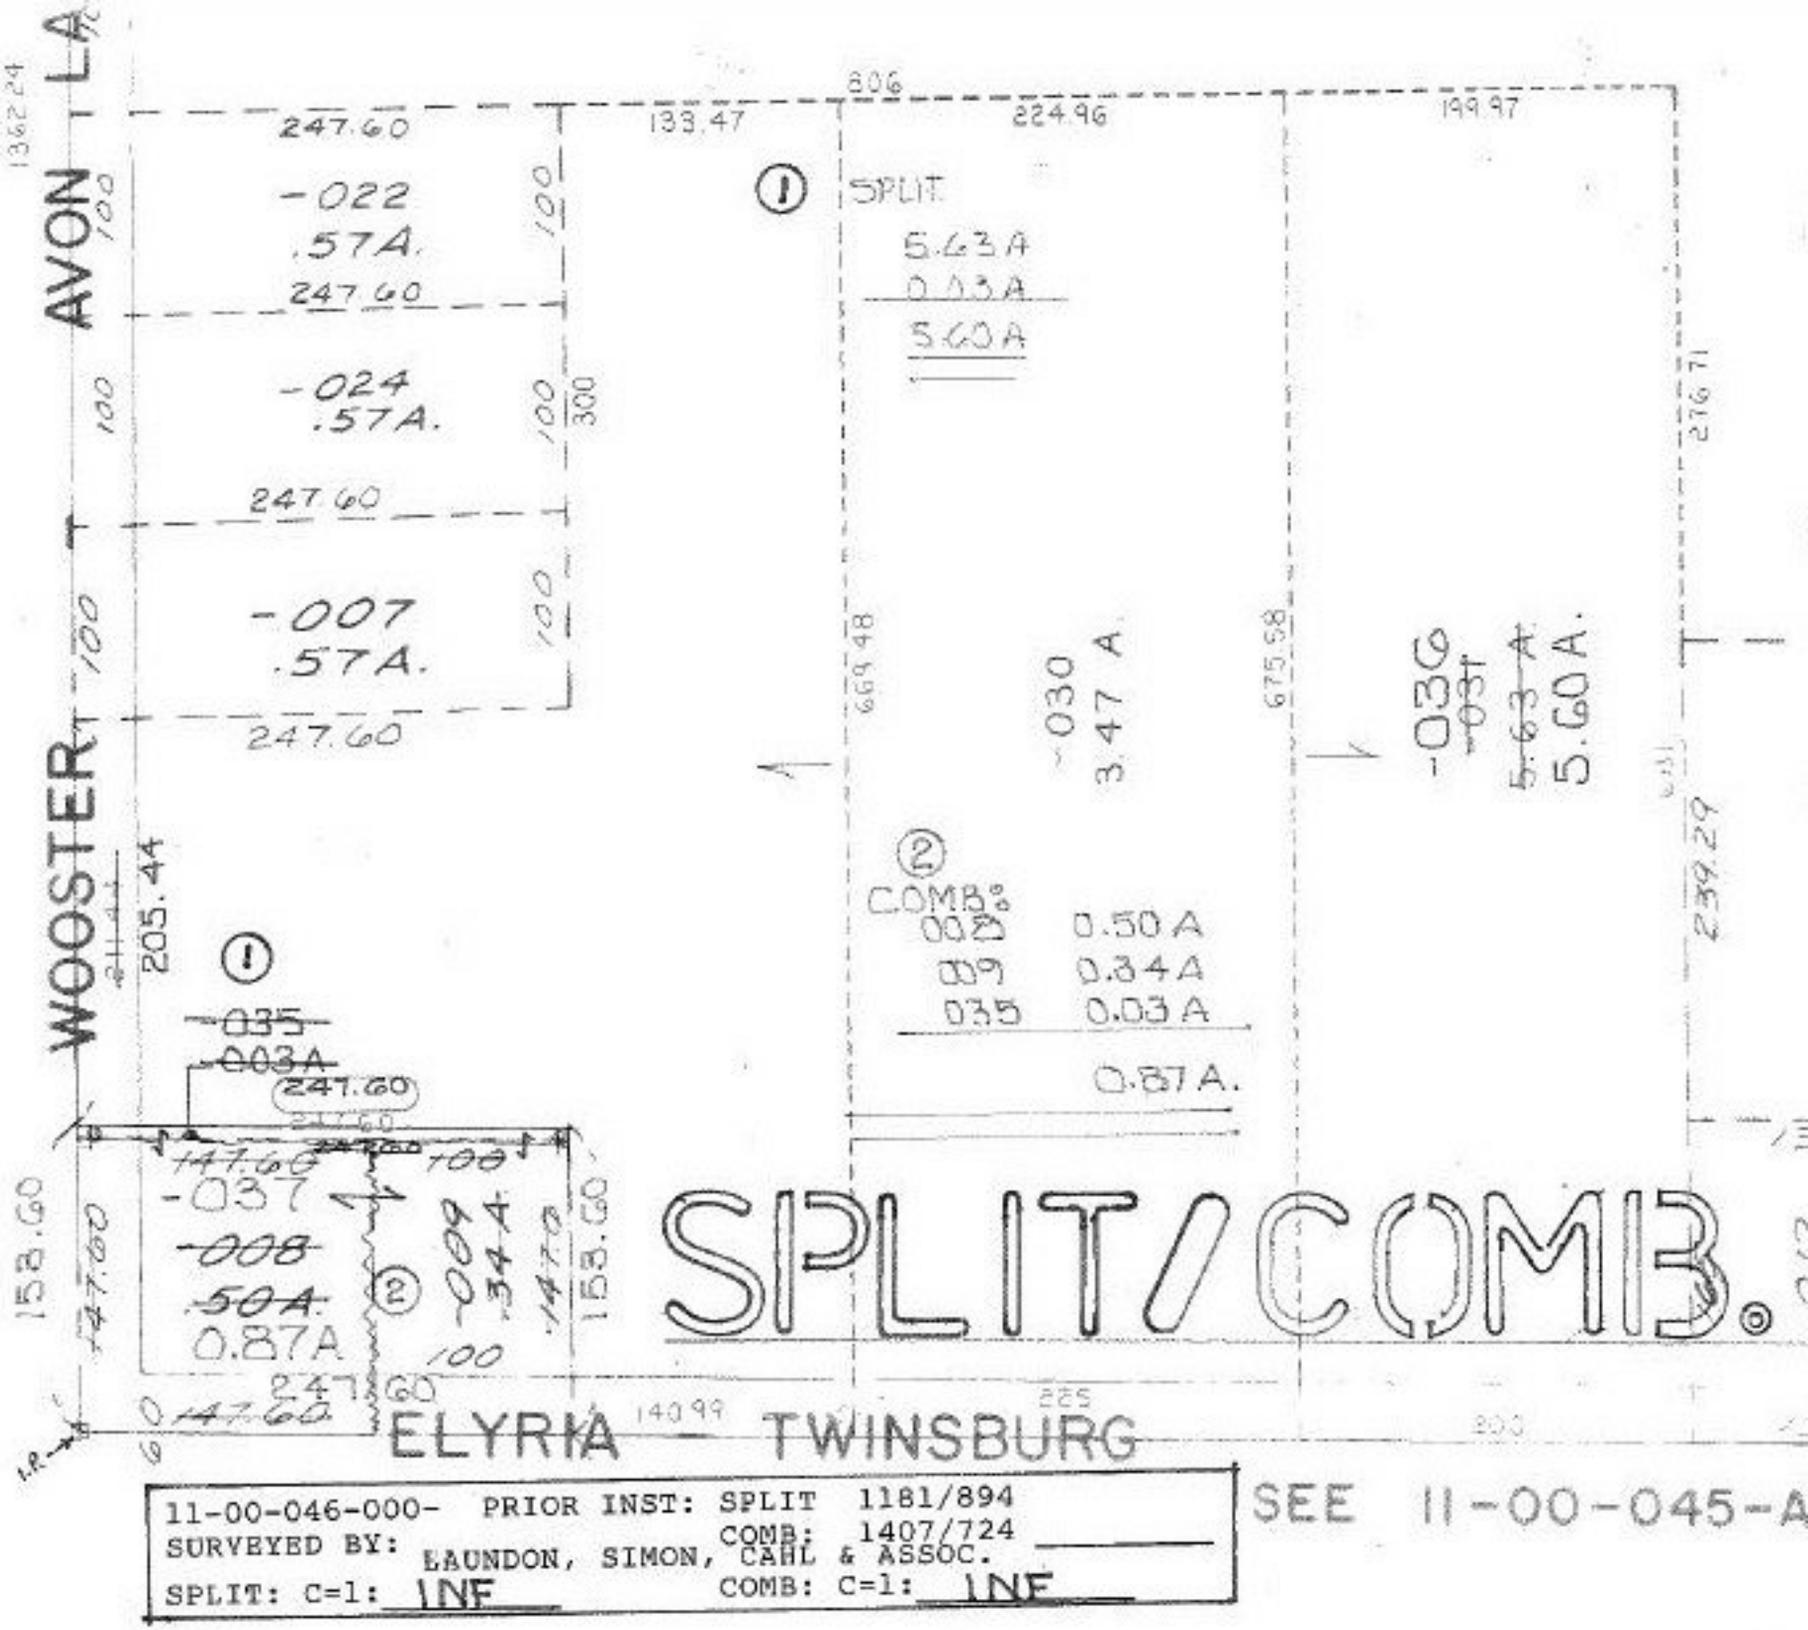

SEE 11-00-045-A

11-00-046-000- PRIOR INST: SPLIT 1181/894
SURVEYED BY: LAUNDON, SIMON, CAHL & ASSOC. COMB: 1407/724
SPLIT: C=1: INF COMB: C=1: INF

SM 1/8/93
20175

APPROVED
LORAIN CO.
MAP DEPT.
DATE 12-8-92
PAGE 11-00-046 A
BY CAROLYN FRANCIS
VOID AFTER # 20175