~~18~~

2018

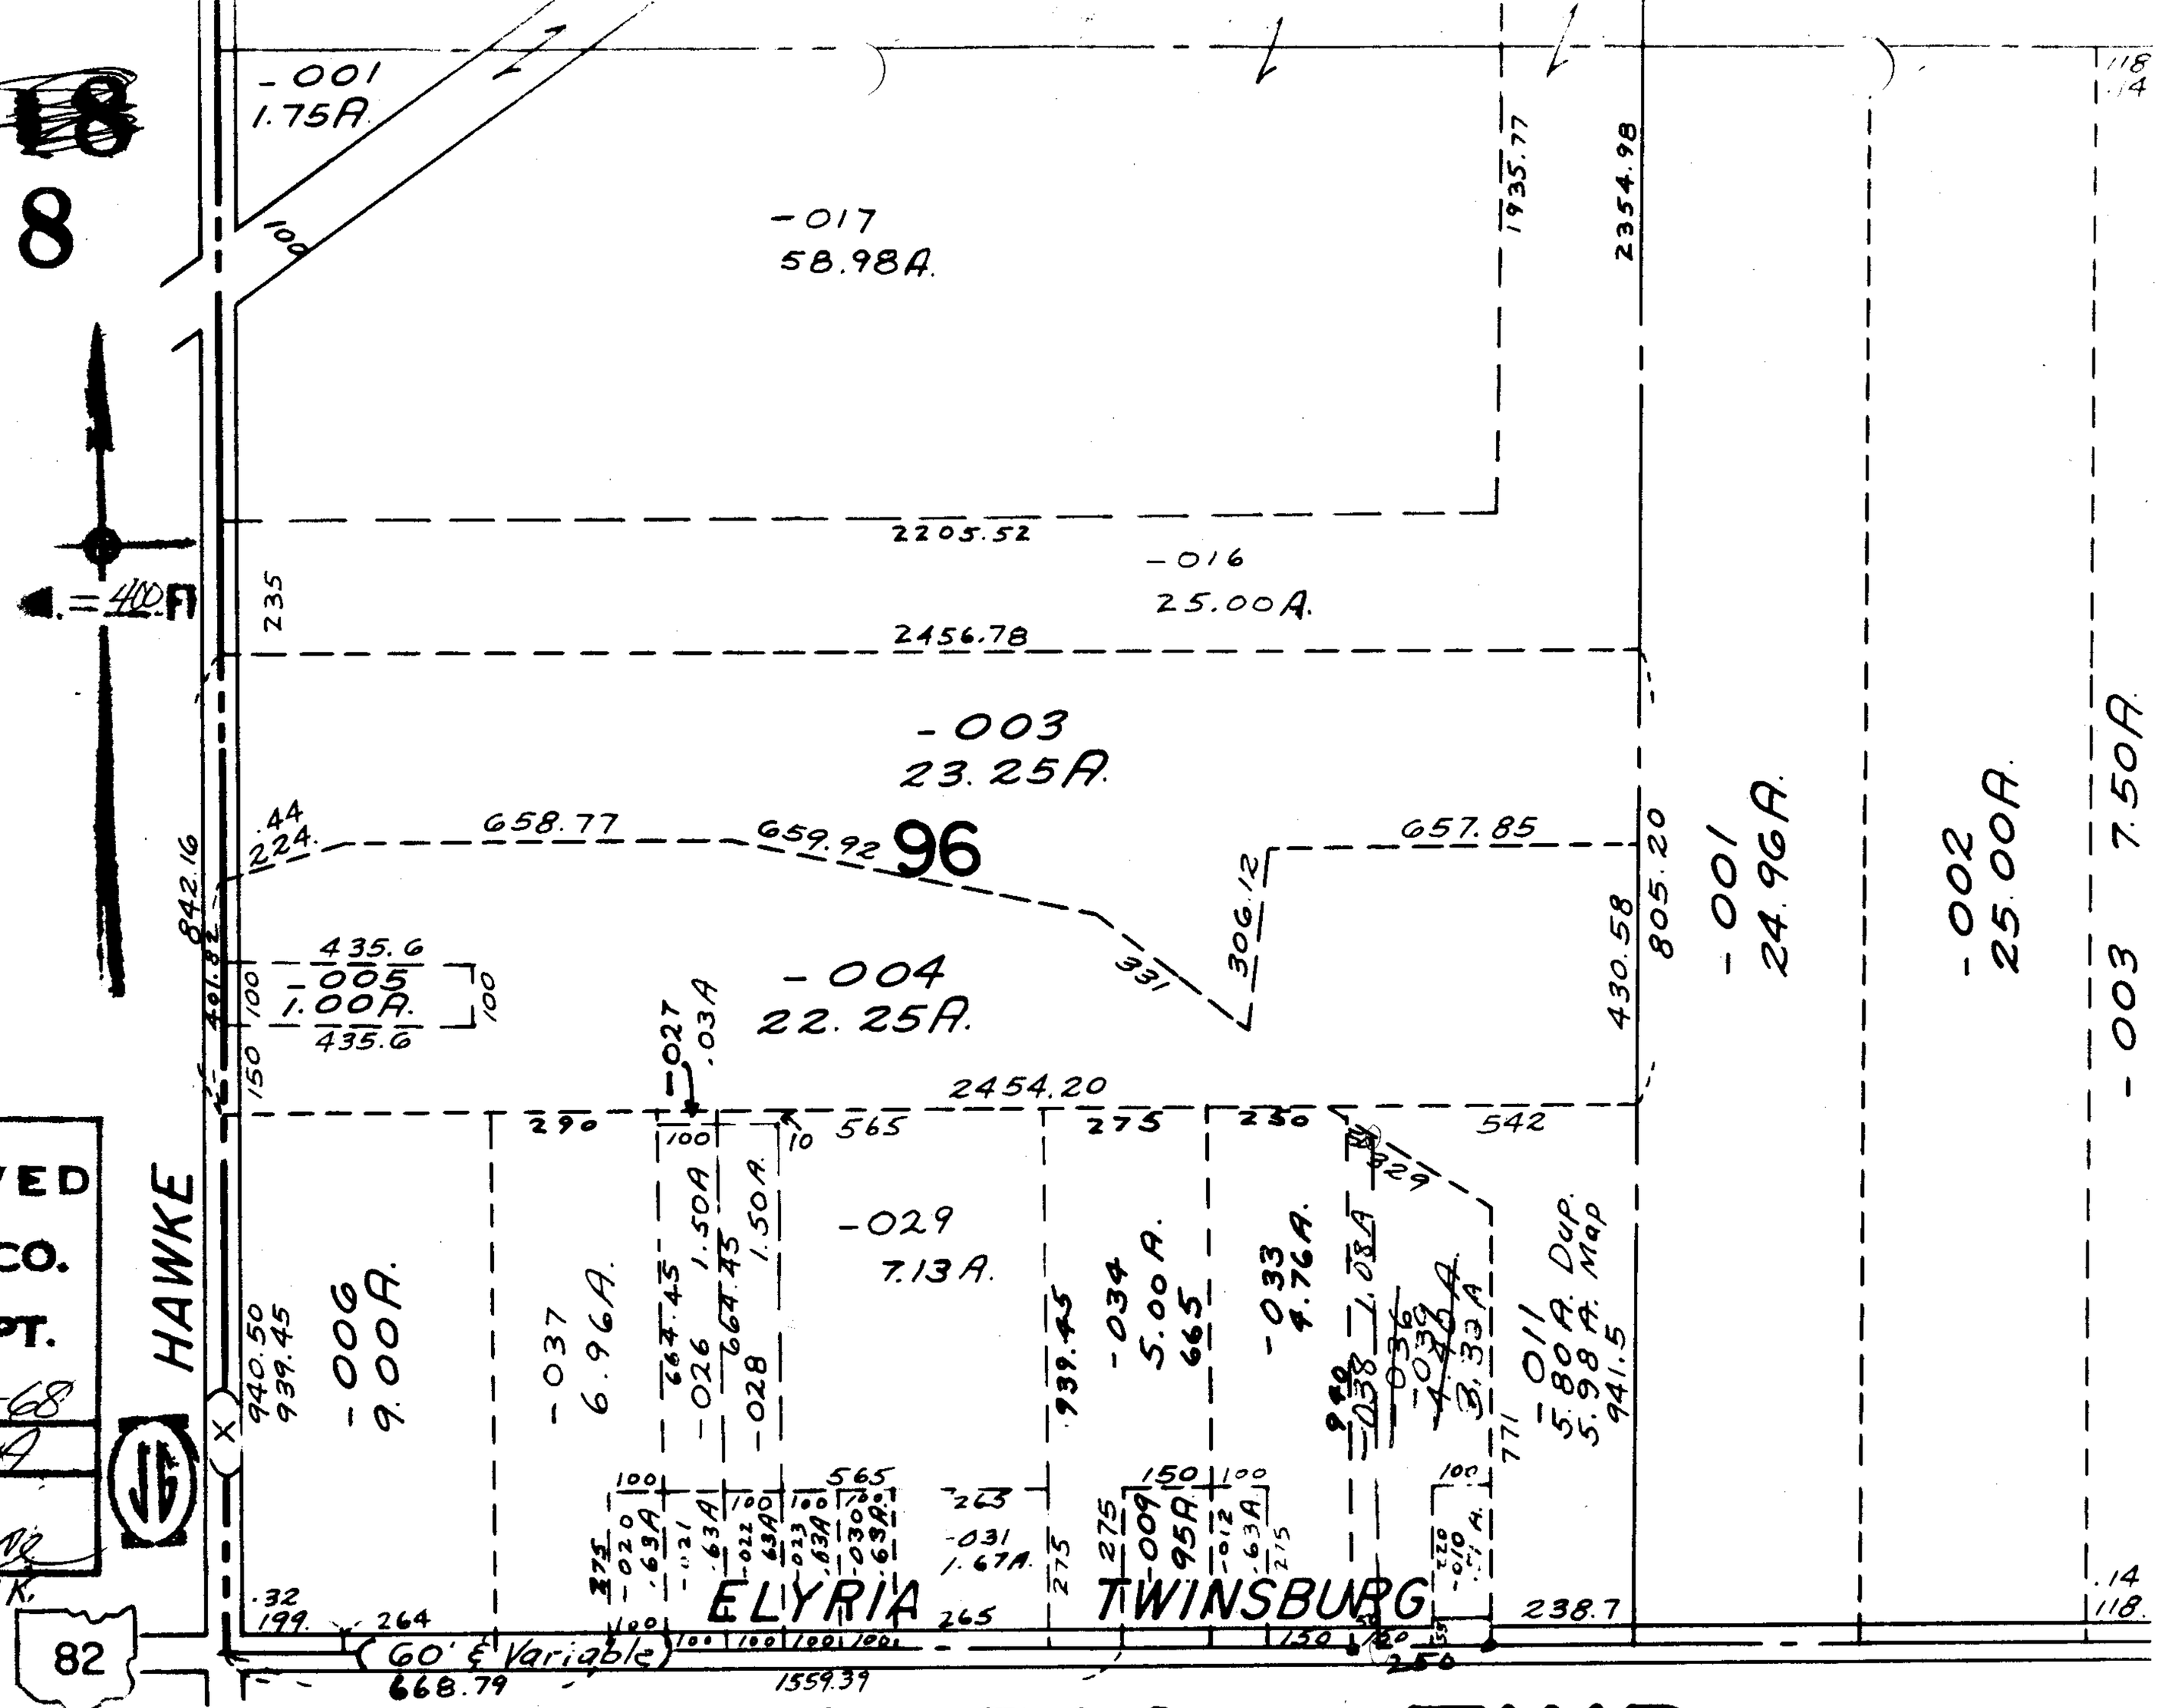

APPROVED
LORAIN CO.
MAP DEPT.
DATE 8-9-68
12-A
BY [signature]
9/30/68 R.K.

Copyright 1962

Revised 9-18-67

COLUMBIA TWP.

SCALE: 1" = 400'

12-A