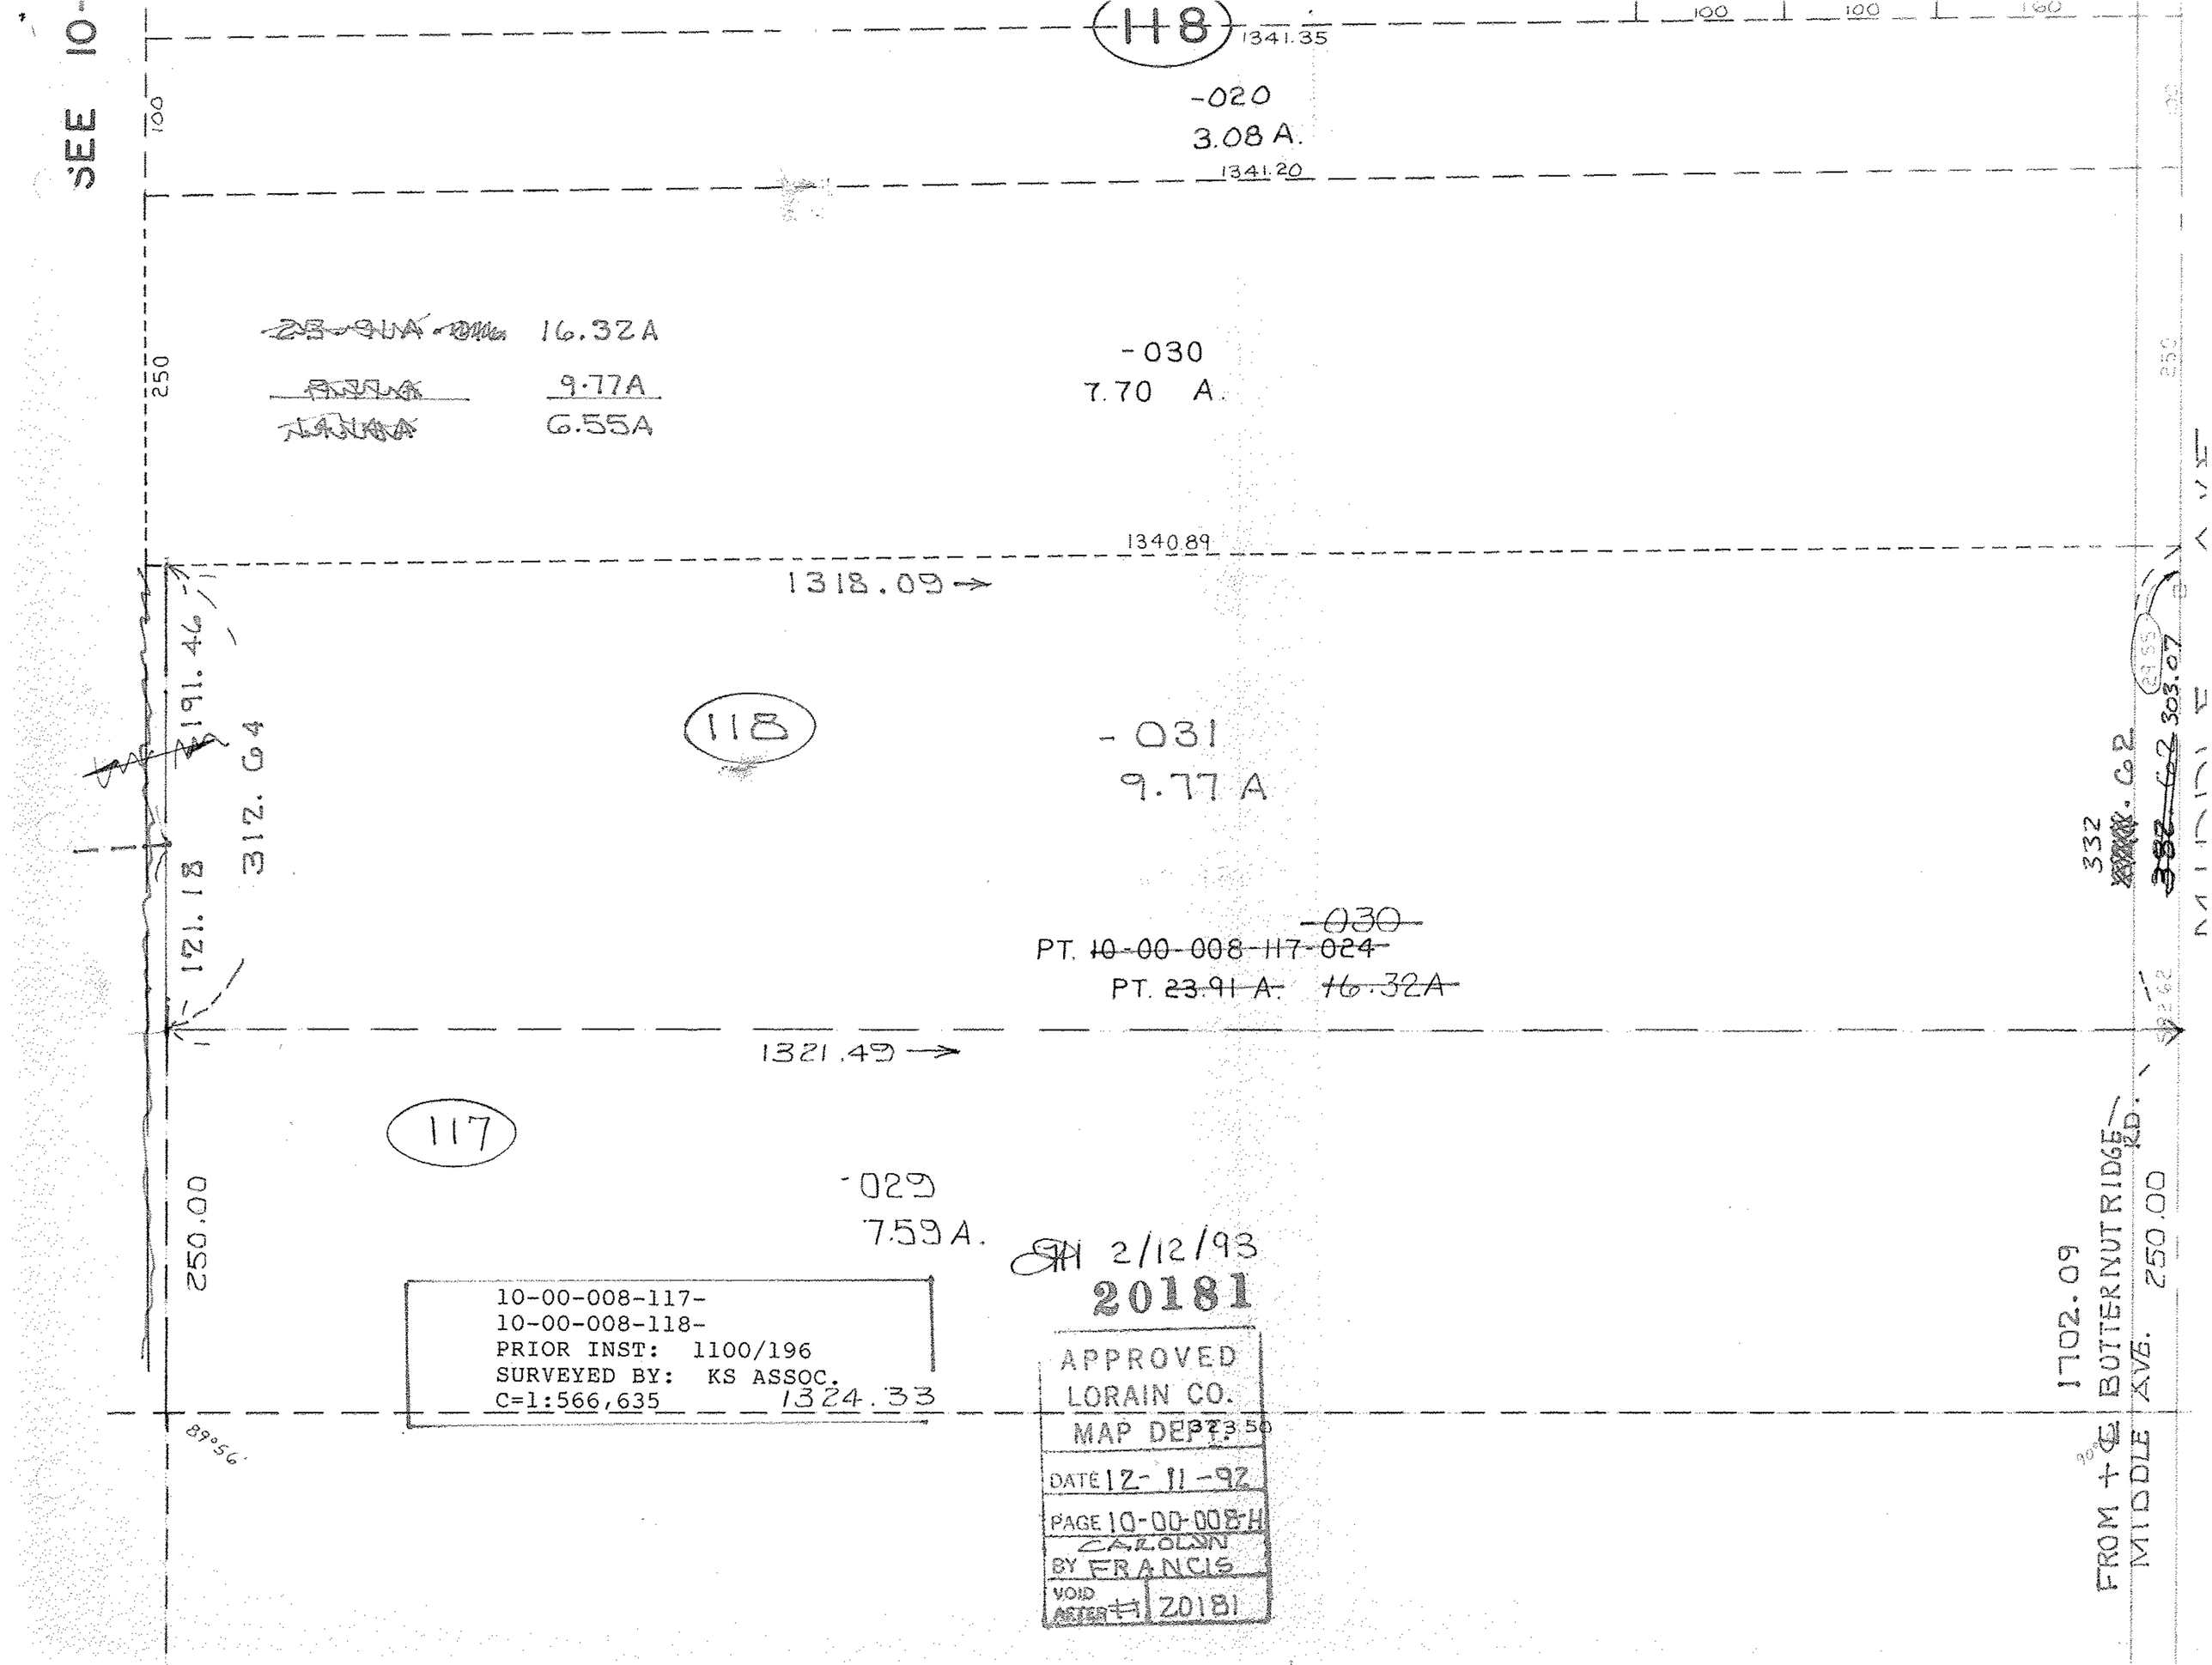
SEE 10-
118
1341.35
-020
3.08 A.
1341.20
16.32A
9.77A
6.55A
-030
7.70 A.
1340.89
1318.09
118
-031
9.77 A
PT. 10-00-008-117-024
-030
PT. 23.91 A. 16.32A
1321.49
117
-029
7.59 A.
250.00
1324.33
10-00-008-117-
10-00-008-118-
PRIOR INST: 1100/196
SURVEYED BY: KS ASSOC.
C=1:566,635
2/12/93
20181
APPROVED
LORAIN CO.
MAP DEPT.
DATE 12-11-92
PAGE 10-00-008-H
BY CAROLYN FRANCIS
VOID AFTER # 20181
1702.09
FROM + ℄ BUTTERNUT RIDGE RD.
MIDDLE AVE.
250.00
332
303.07
191.46
312.64
121.18
89°56'
323.50